


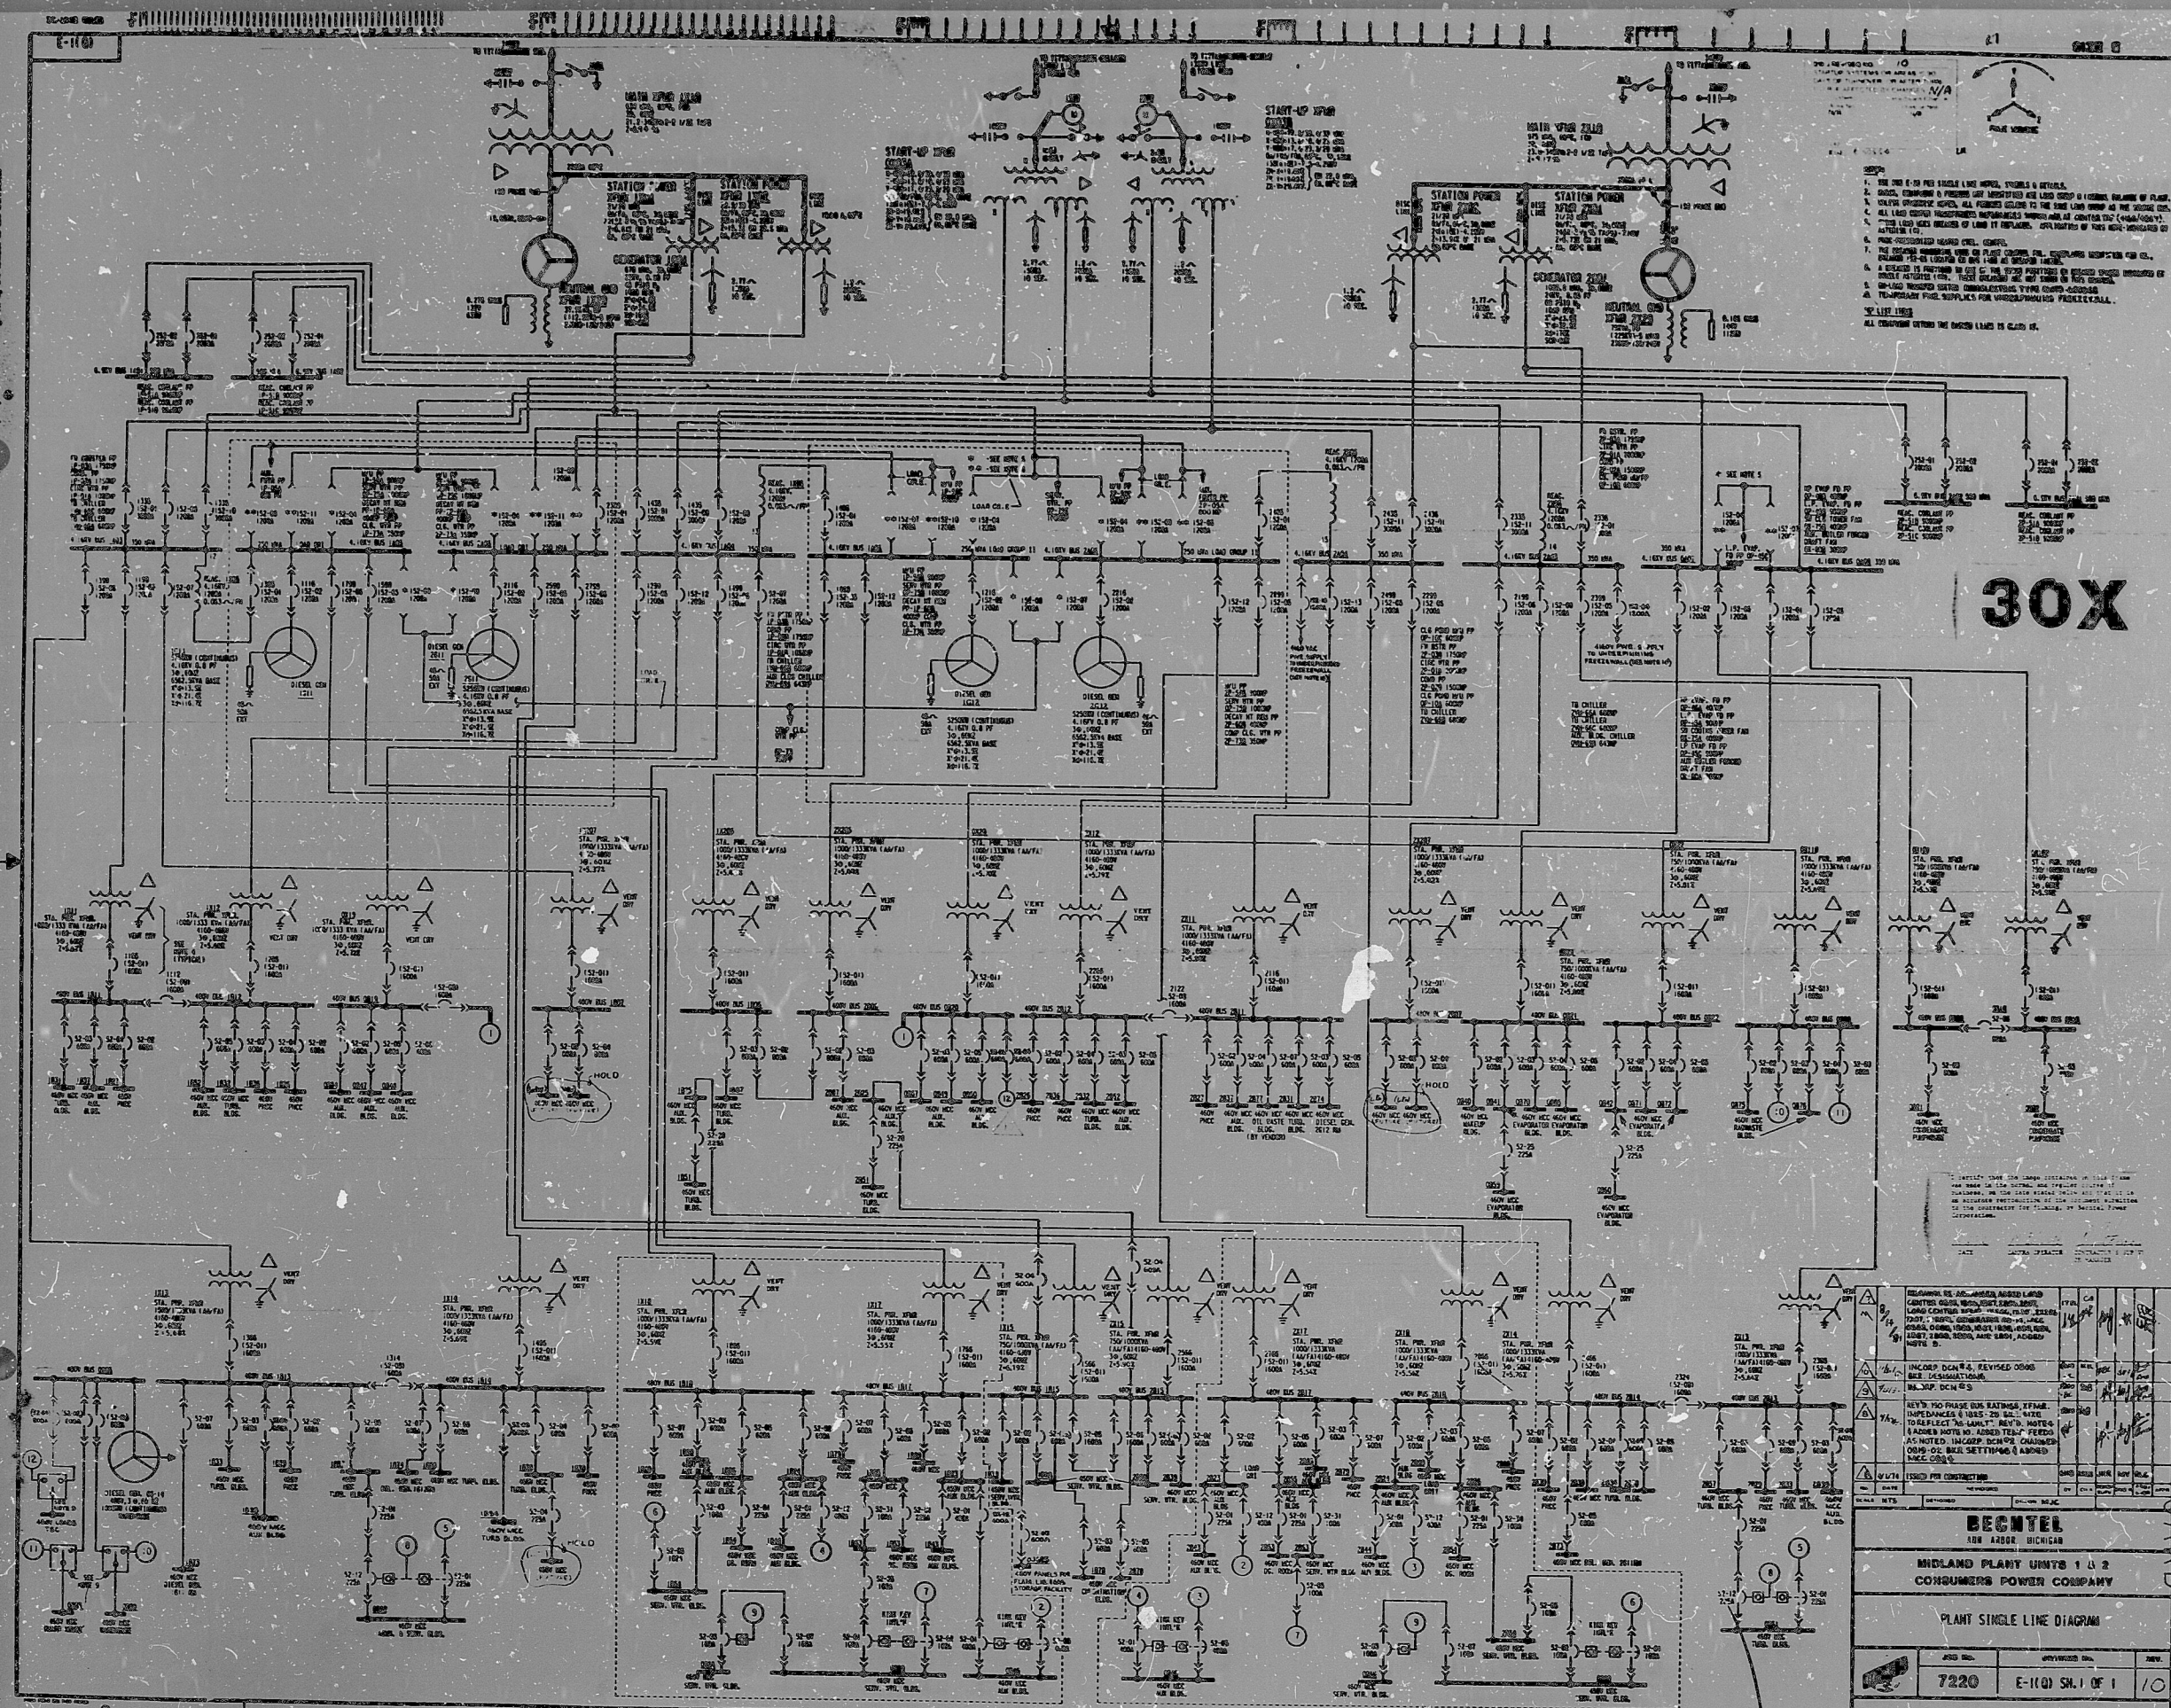

30X

MIDLAND PLANT UNITS 1 & 2 CONSUMERS POWER COMPANY			
PLANT SINGLE LINE DIAGRAM			
7220	E-1101	SH. 1 OF 1	10

PDR RIDS

8401110059

