
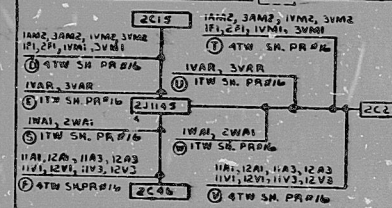


E-53 (Q)

30X

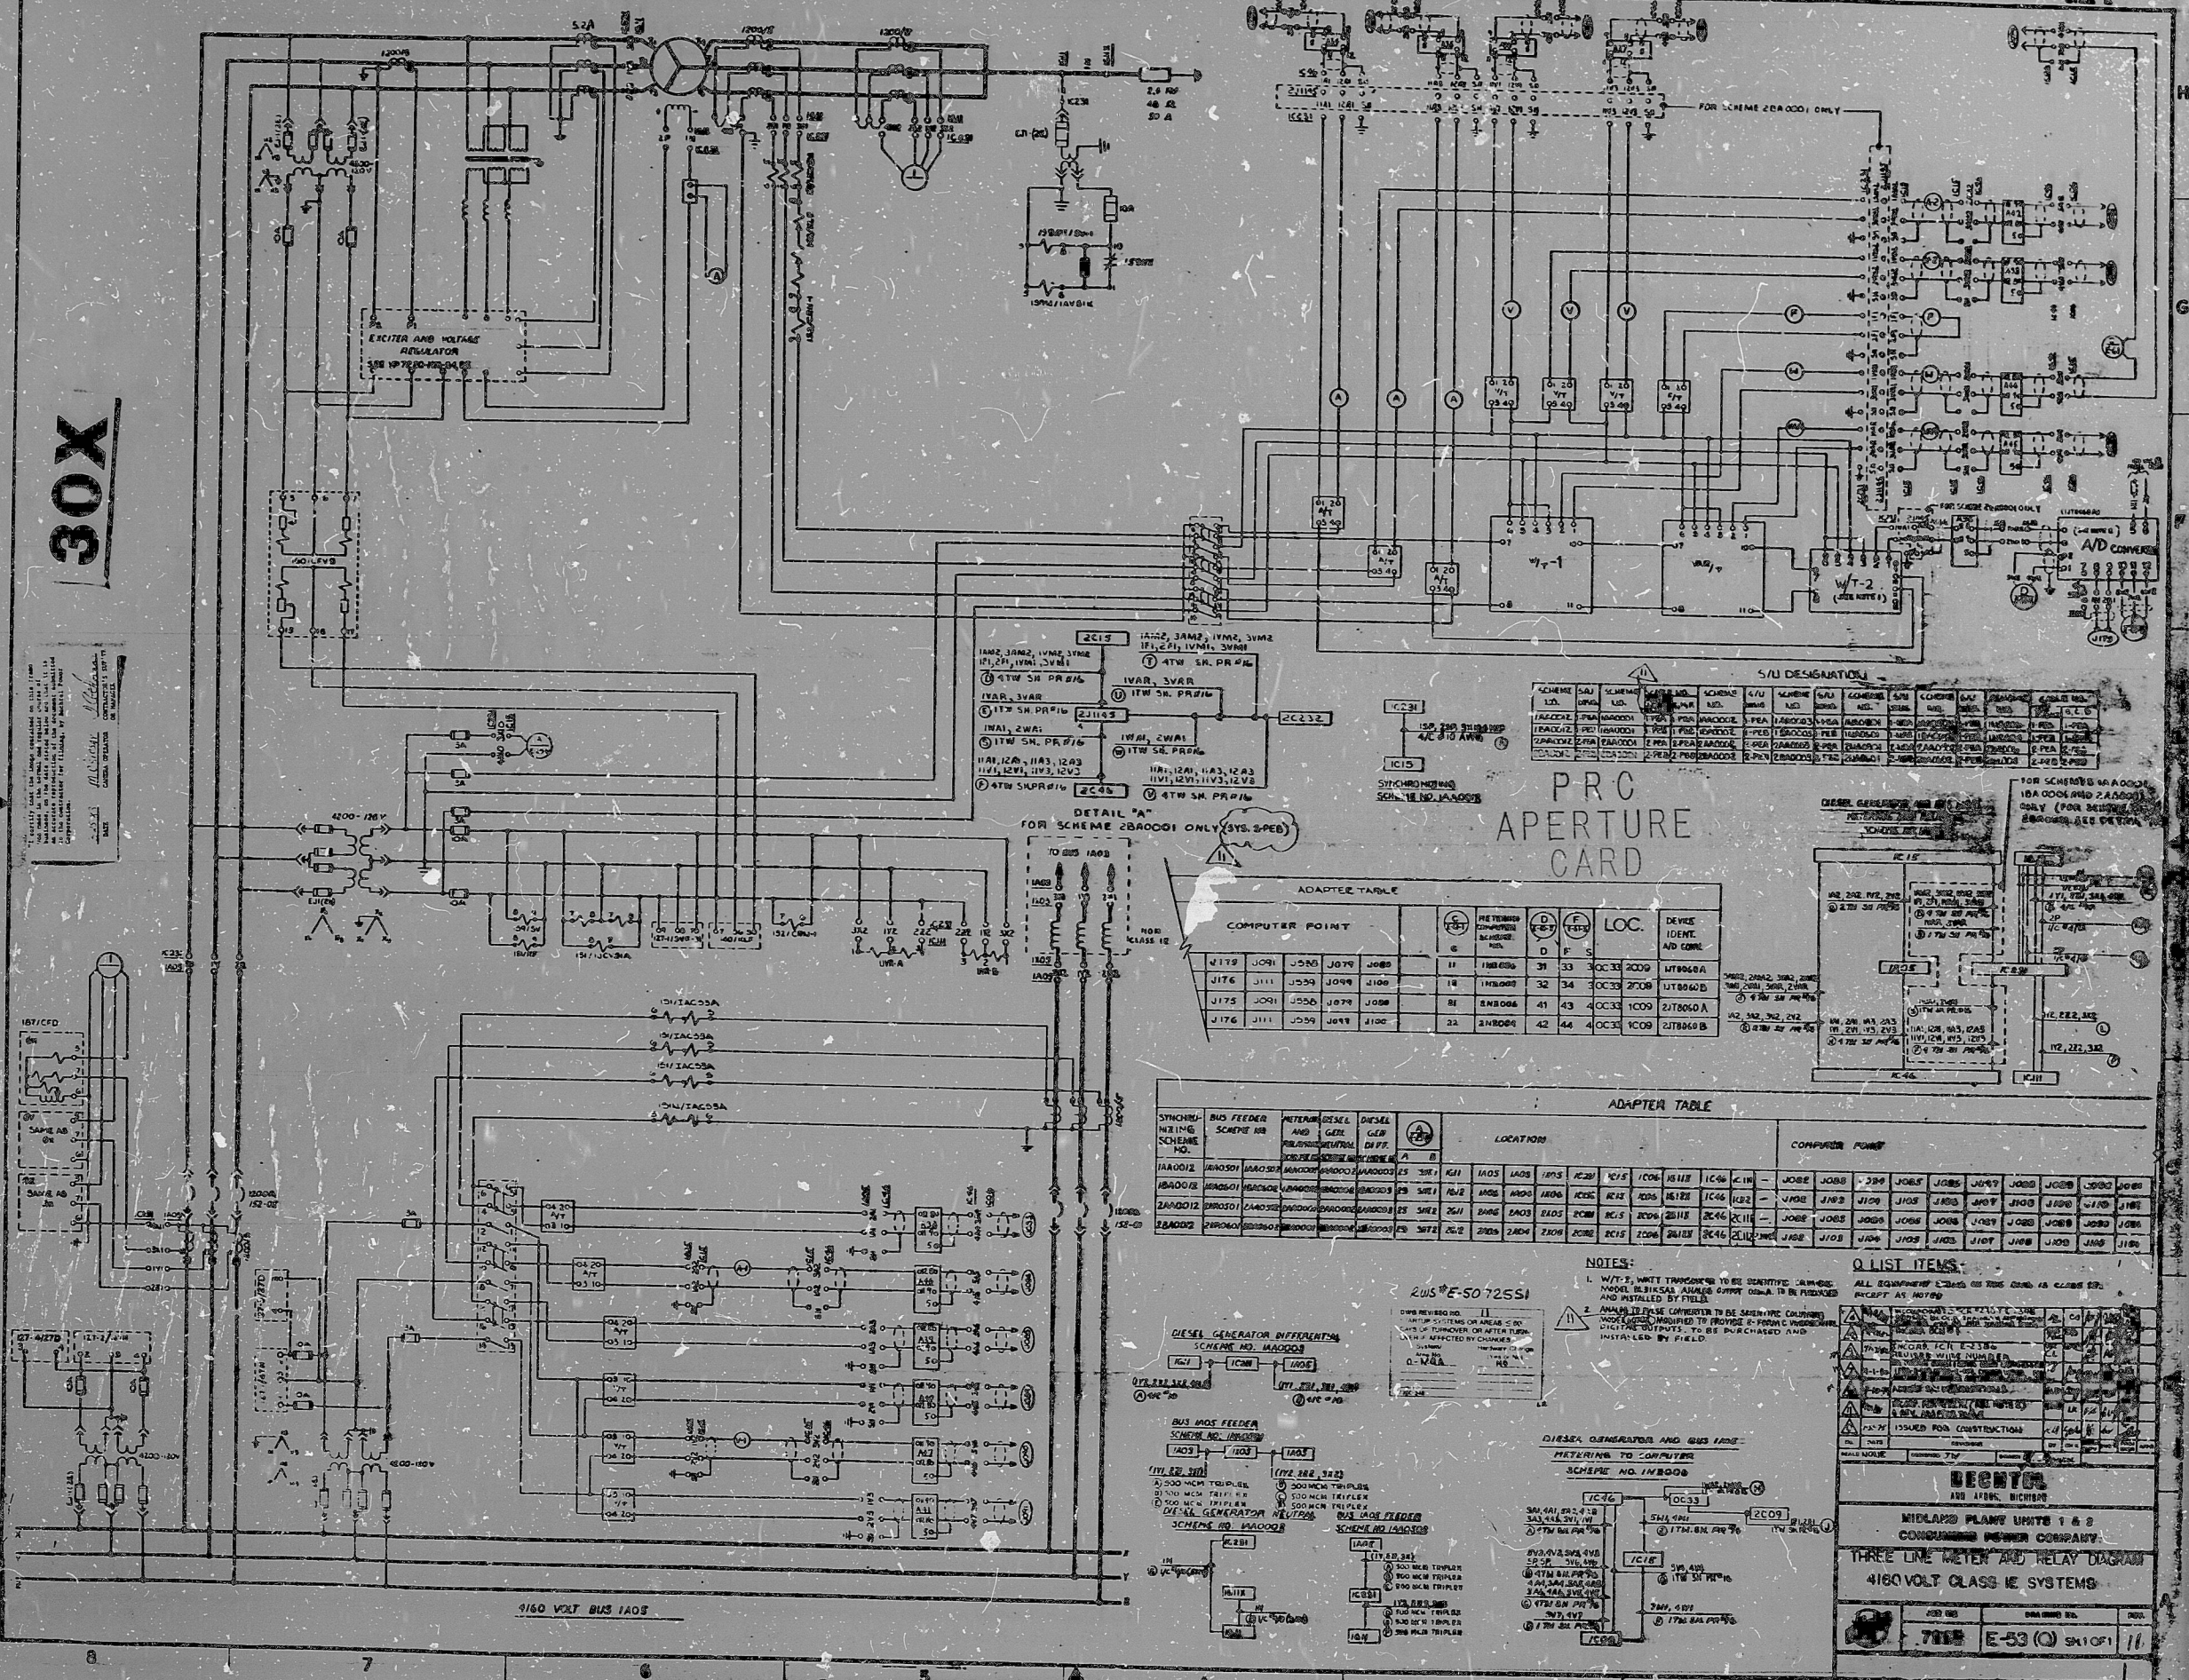


P-R-C
APERTURE
CARD

ADAPTER TABLE										
COMPUTER POINT				 THE PERIPHERAL SLOT NO.	 CPU	 CPU	LOC.	DEVICE IDENT. AND CODE		
				E	D	F				
J178	J001	J580	J078	J088	11	11B006	31	33	40C33 1C09	11B006A
J176	J111	J554	J044	J100	18	11B006	32	34	40C33 2F08	11B006B
J175	J001	J556	J078	J100	RE	ENB066	41	43	40C33 1C09	21B006A
J176	J111	J559	J078	J100	32	21B006	42	46	40C33 1C09	21B006B

ADAPTER TABLE

SYNCHRONIZING SCHEME NO.	FEEDER	RELAY	LOC.	COMPUTER POINT

205E-5072551

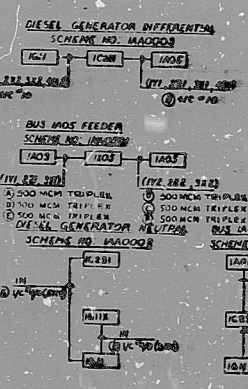

NOTES:


Q LIST ITEMS:





THREE LINE METER AND RELAY DIAGRAM

4160 VOLT CLASS IE SYSTEMS

7155 E-53 (Q) 5/10/11

PDR RIDS

8401110315

