


17"

17"

64

64

DRAWING
CERTIFIED DRAWING

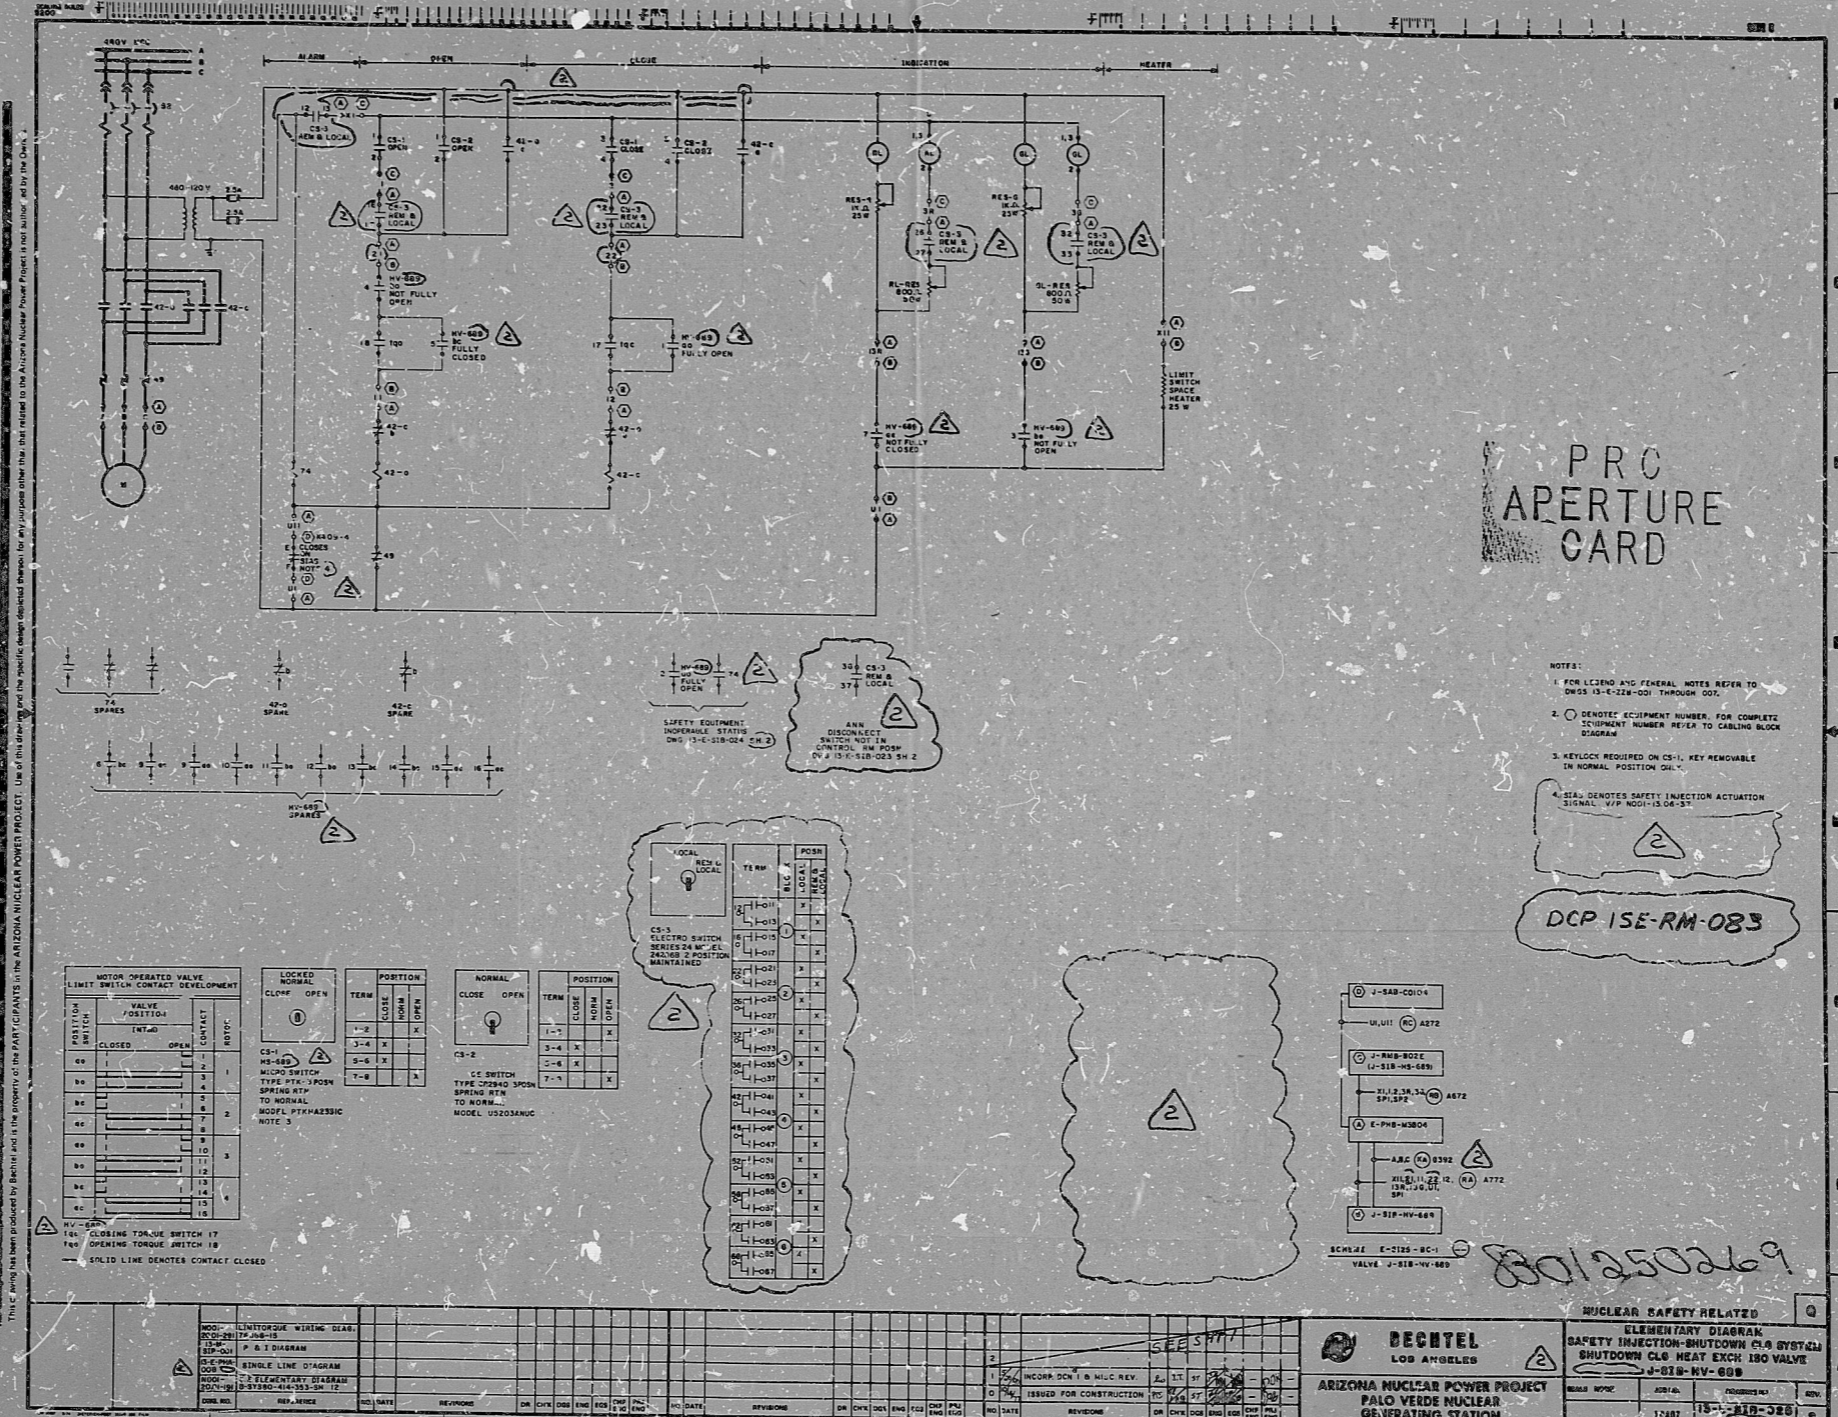

THIS DRAWING WAS PRODUCED BY DECTEL AND IS THE PROPERTY OF THE PARTICIPANTS IN THE ARIZONA NUCLEAR POWER PROJECT. IT IS TO BE USED FOR THE PROJECT ONLY AND NOT FOR OTHER PURPOSES. FOR REVISIONS TO THIS DRAWING CONTACT THE PROJECT MANAGER.

64

64

17"

17"

RIDS

830/250269

