


17"
11"
8.5"
8.5"
11"
17"

CERTIFIED DRAWING

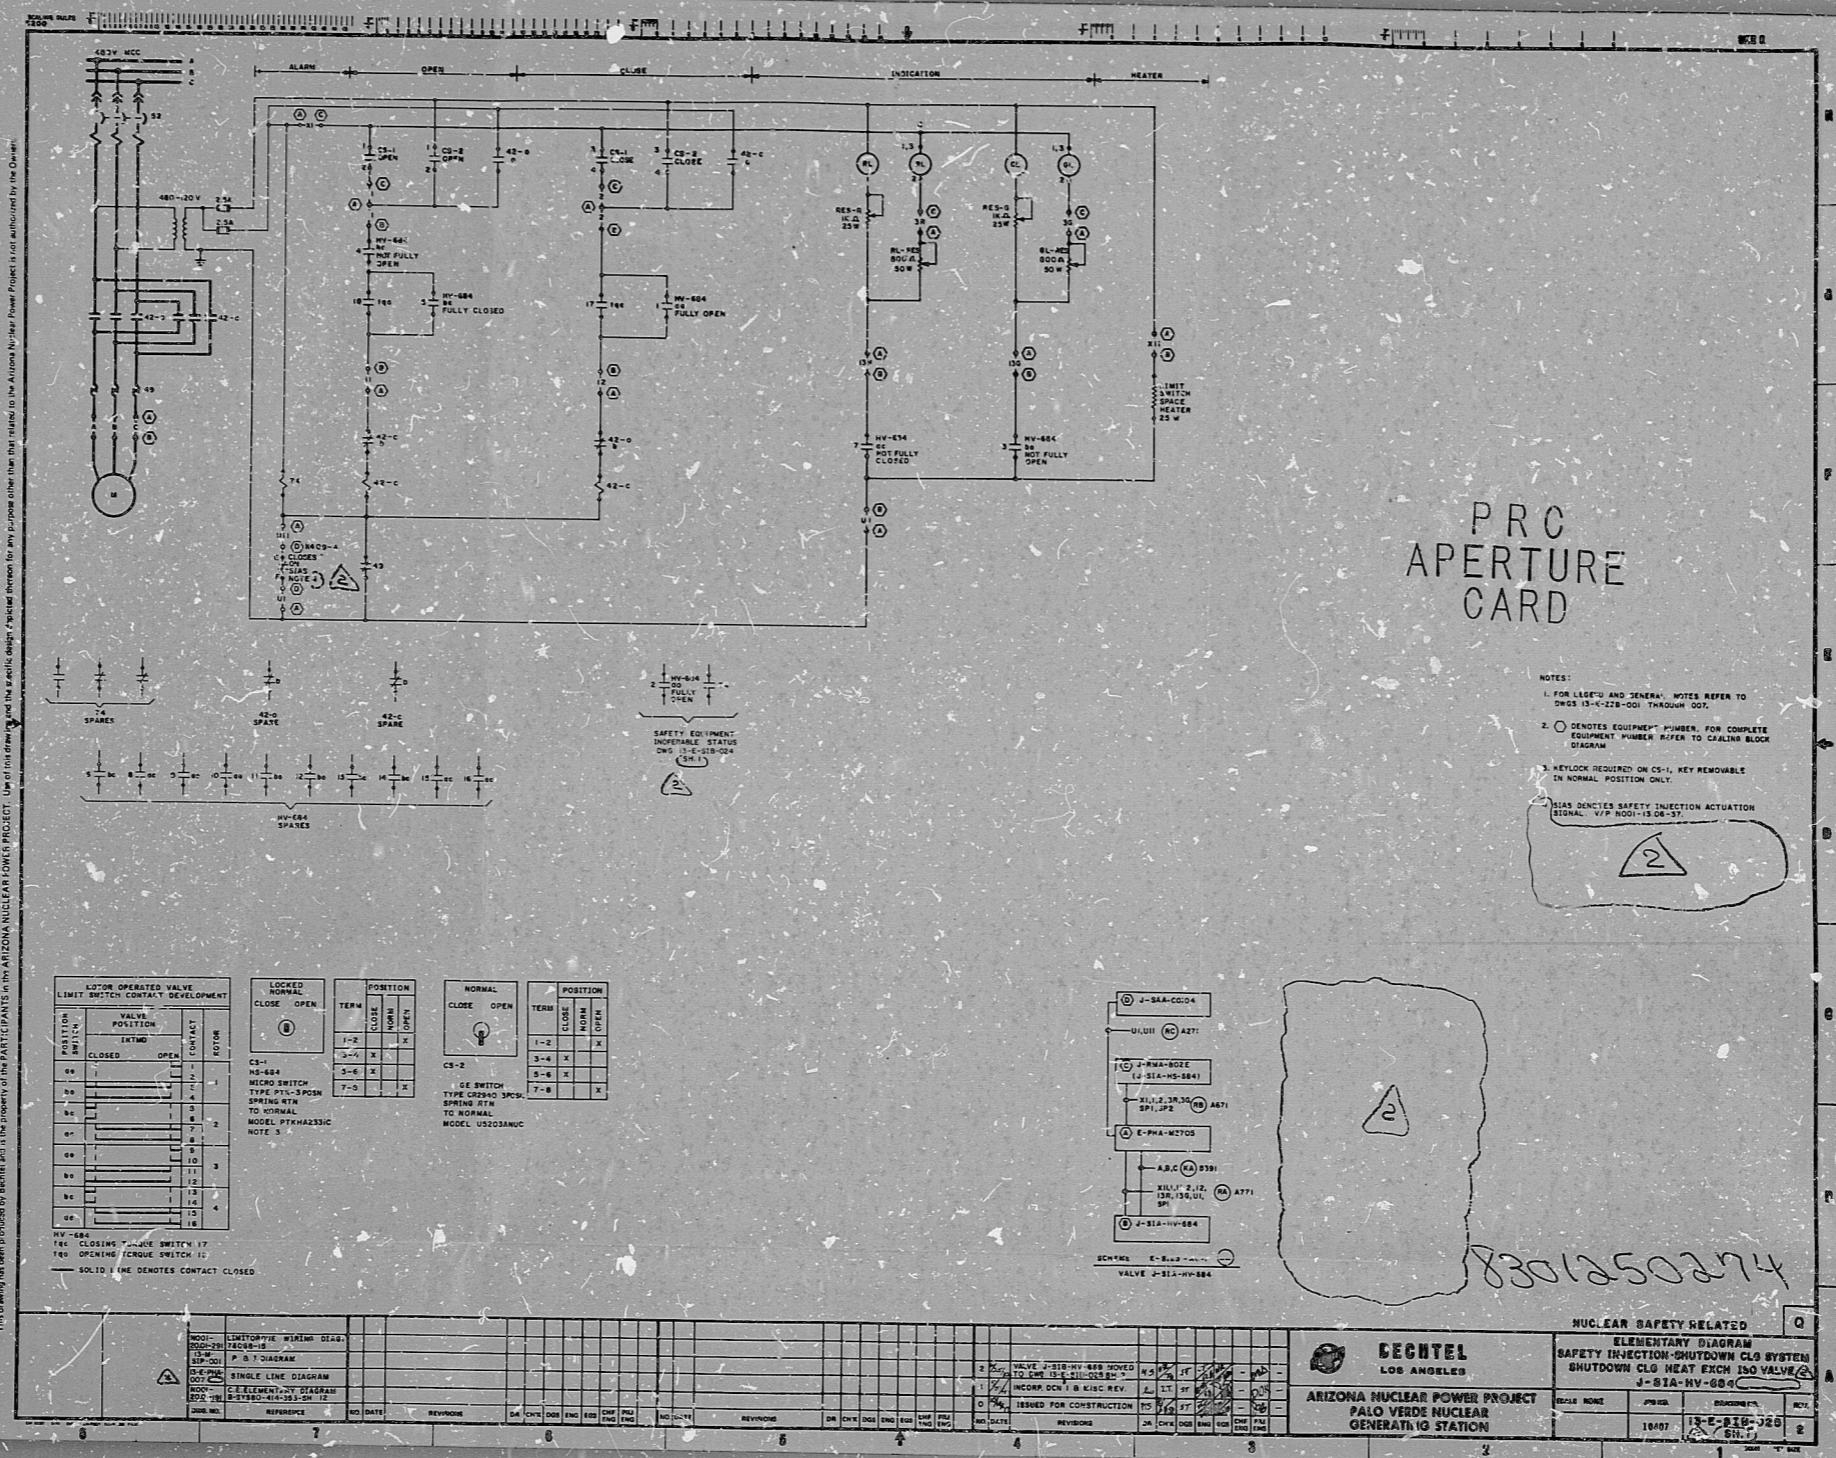

17"
11"
8.5"
8.5"
11"
17"

RIDS

8301250274

