

CERTIFIED DRAWING



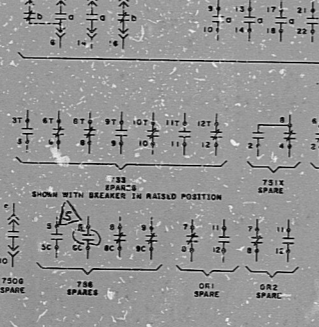


Table with columns: AMMETER, CONTACTS, POSIT-ONS. It lists various electrical components and their states.

Table with columns: BREAKER CONTROL, CONTACTS, POSITIONS. It details the control logic for a breaker, including 'STOP', 'START', 'CLOSE', and 'OPEN' states.

Table with columns: CONTACTS, POSITIONS. It provides a detailed status matrix for multiple contact points across different positions.

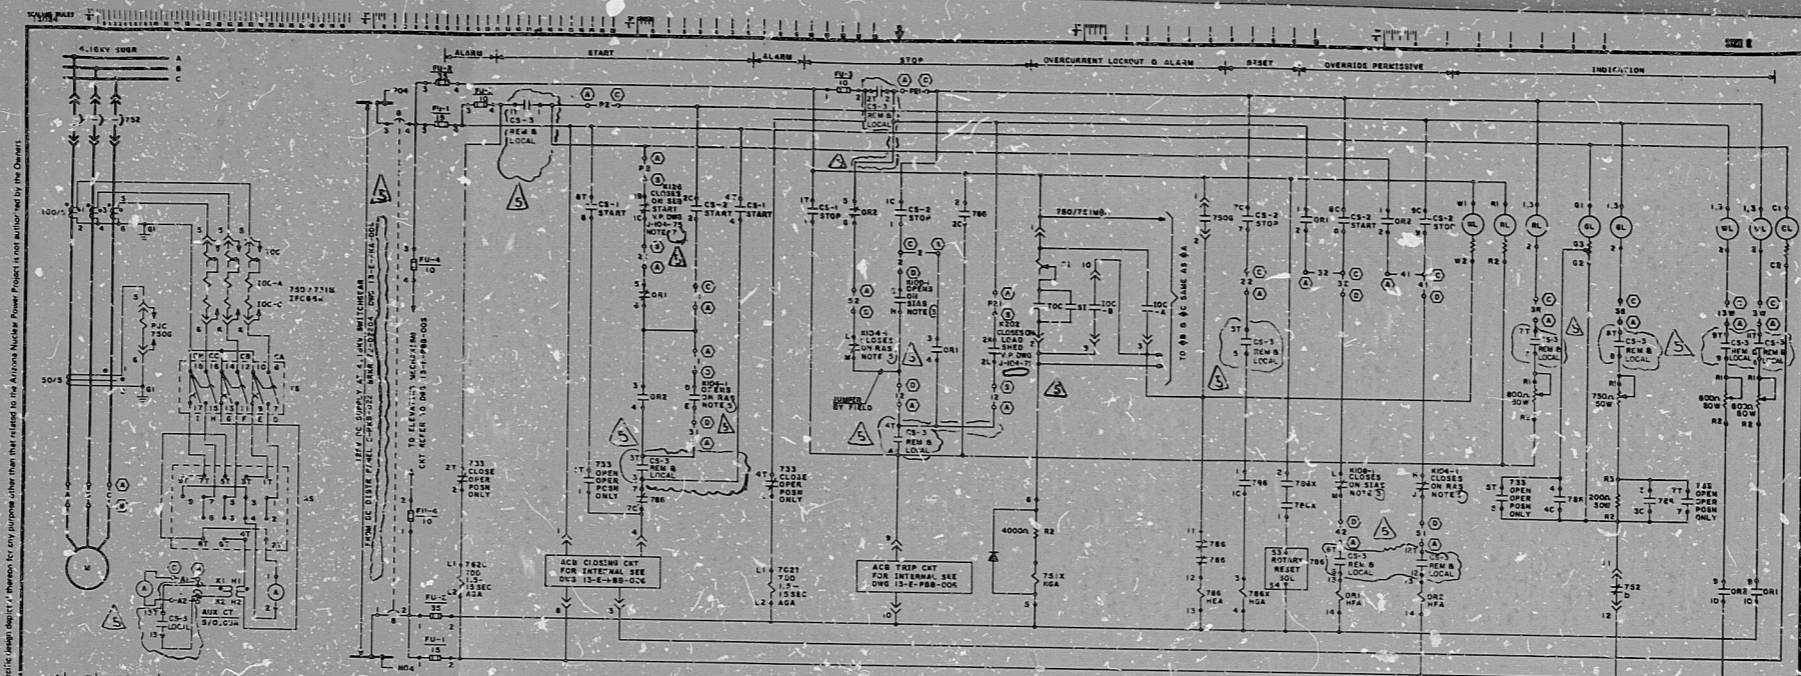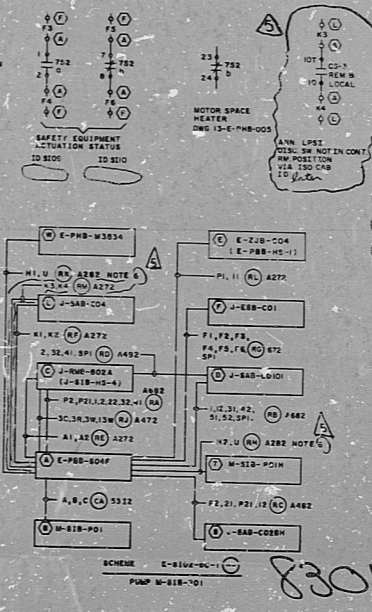

- NOTES: 1. P&L, LEGEND AND GENERAL NOTES REFER TO DWG 13-E-228-001 THROUGH 007. 2. ... 3. ... 4. ... 5. ... 6. ... 7. ...

PRC APERTURE CARD

8301250284

Revision table with columns: NO., DATE, REVISION, and a grid for tracking changes.

Project information block including BECTEL logo, 'ARIZONA NUCLEAR POWER PROJECT PALO VERDE NUCLEAR GENERATING STATION', and 'ELEMENTARY DIAGRAM SAFETY INJECTION SYSTEM CONTROL SYSTEM LP SAFETY INJECTION PUMP M-818-P01'.

17"

17"

66












RIDS

8301250284

