


CERTIFIED DRAWING

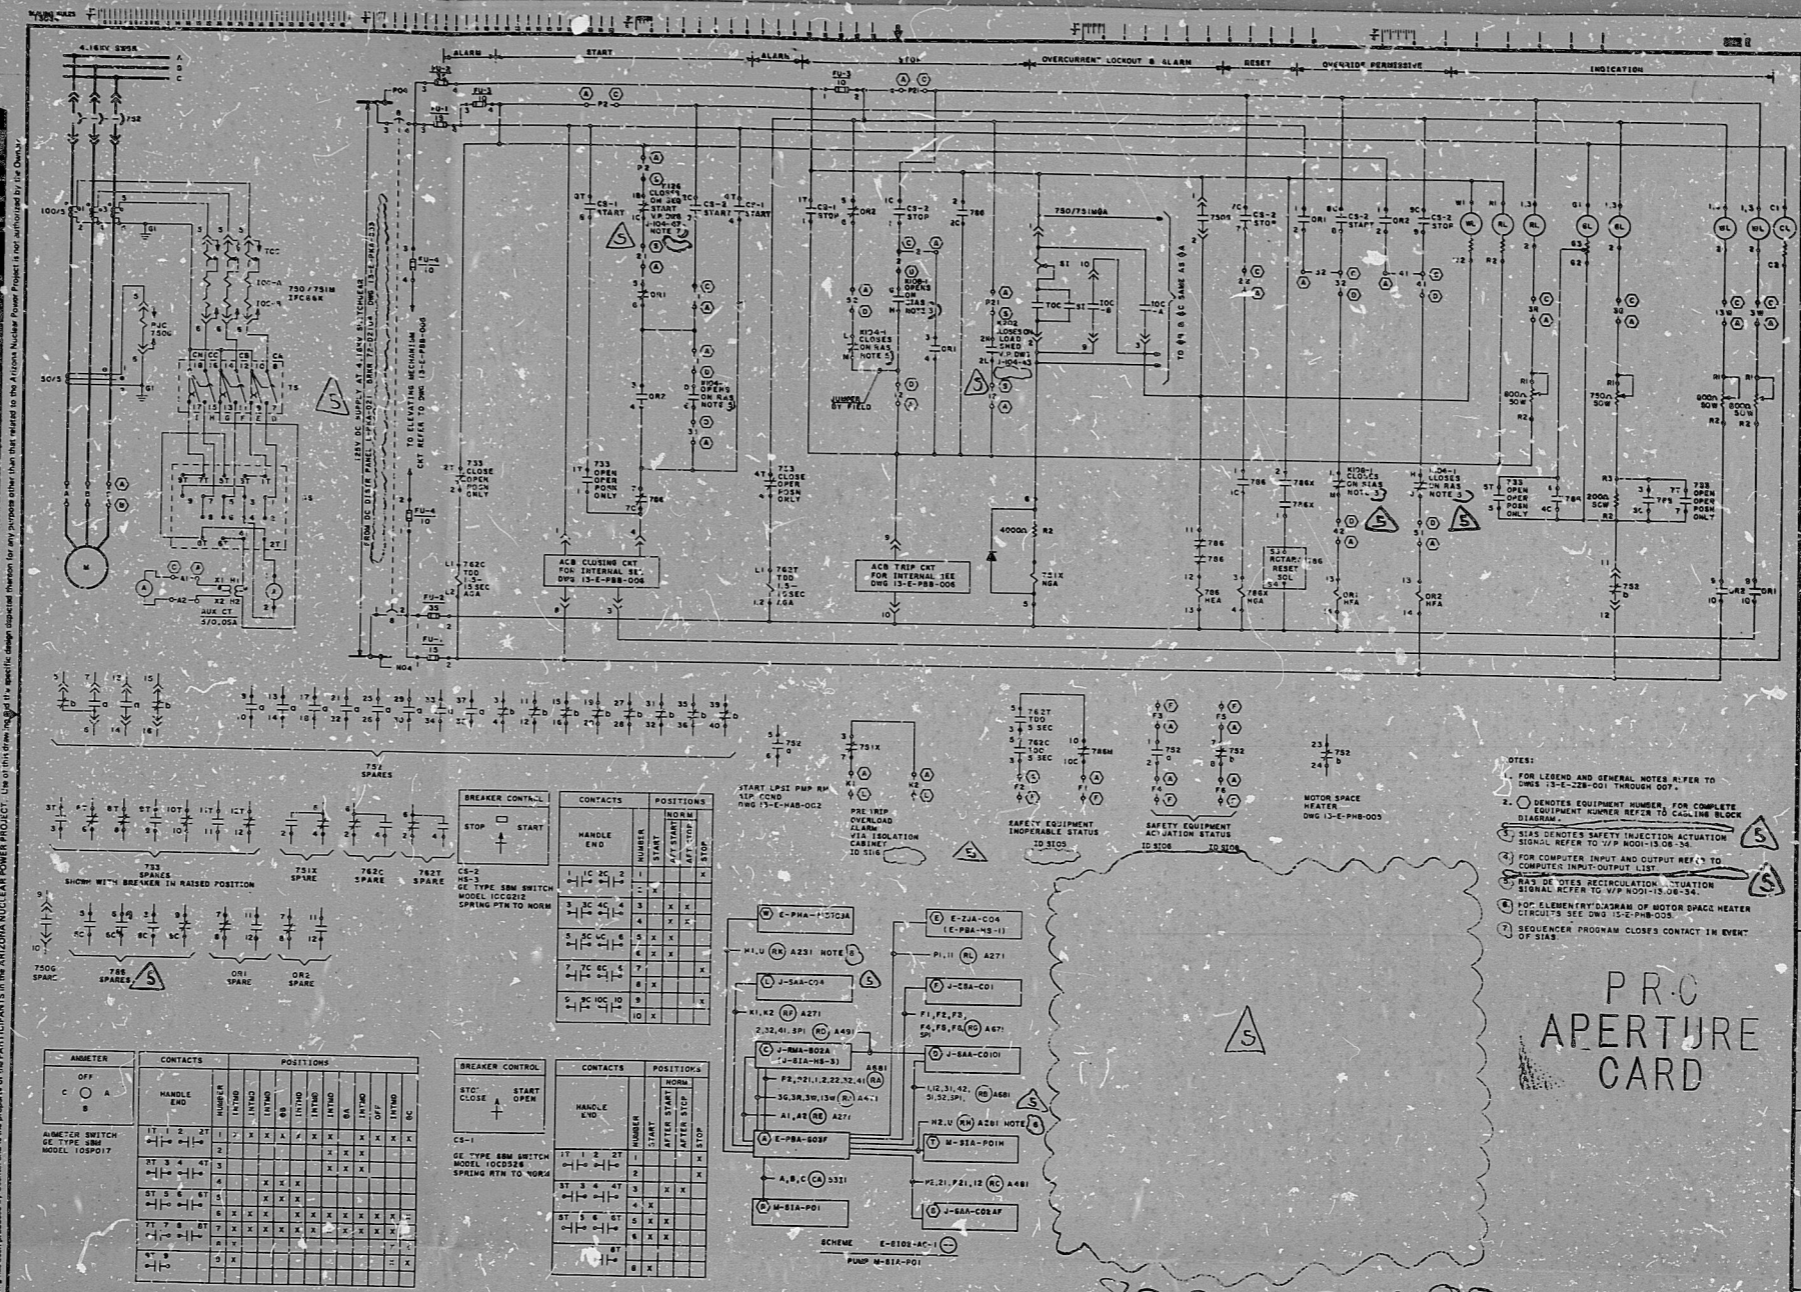

**733 SPARE**

**732 SPARE**

- NOTES:
- FOR LEGEND AND GENERAL NOTES REFER TO DWG 13-E-228-001 THROUGH 007.
  - IDENTIFY EQUIPMENT NUMBER, FOR COMPLETE DIAGRAM NUMBER REFER TO CALLING BLOCK.
  - FOR COMPUTER INPUT AND OUTPUT REFER TO COMPUTER INPUT/OUTPUT LINE.
  - SEQUENCE PROGRAM CLOSES CONTACT IN EVENT OF SIA.

PRC APERTURE CARD

830 1250288


NUCLEAR SAFETY RELATED

**BECHTEL**  
LOS ANGELES

ARIZONA NUCLEAR POWER PROJECT  
PALO VALDE NUCLEAR  
GENERATING STATION

ELEMENTARY DIAGRAM  
SAFETY INJECTION & SHUTDOWN CLOSURE  
LP SAFETY INJECTION PUMP  
M-STA-POI

DATE: 10/15/78

DWG NO: 13-E-228-002

REV: 5

RIDS

8301250288

