
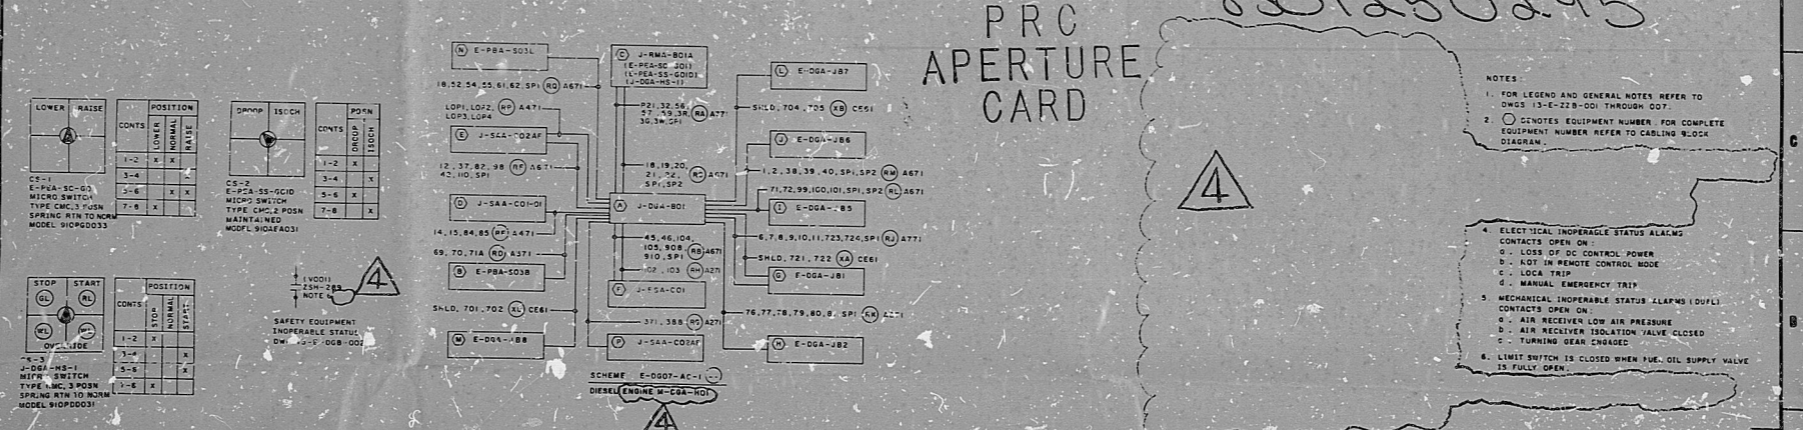
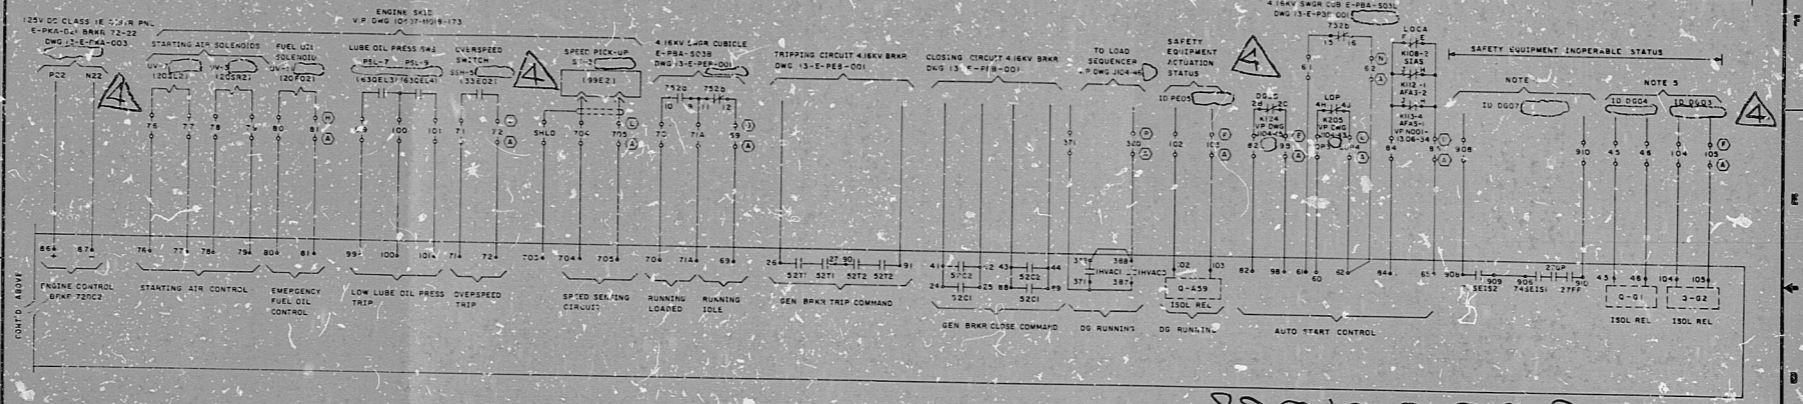


CERTIFIED DRAWING

BOTH SHEETS MUST BE ISSUED TOGETHER

13-E-068-007 SHEET 1 OF 2

10407

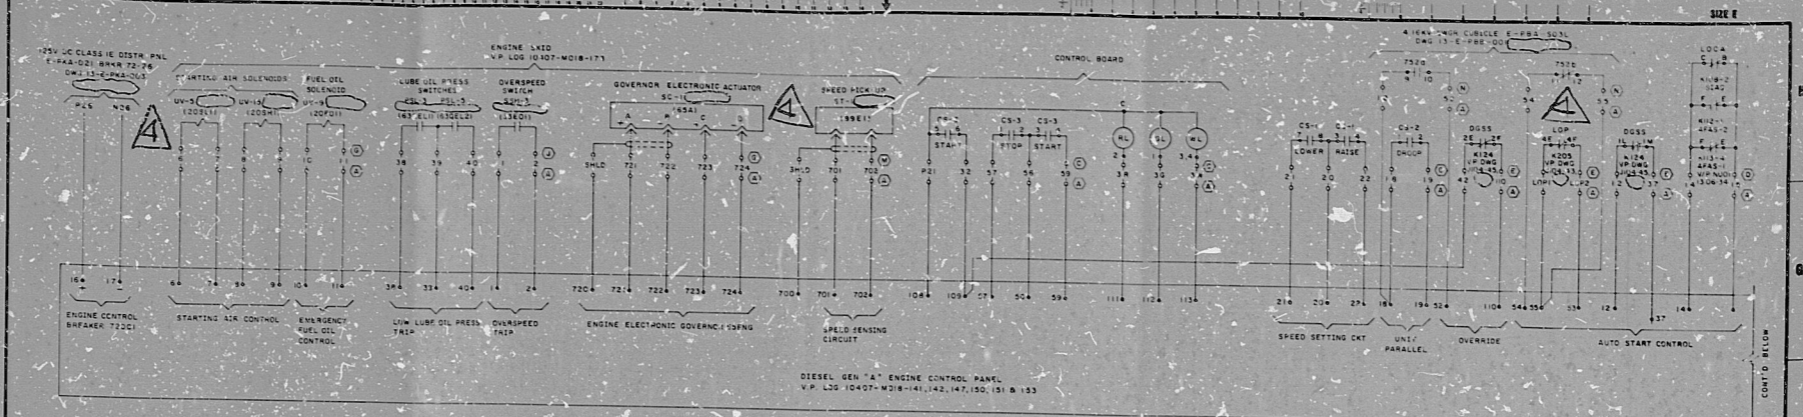

NO.	DATE	REVISIONS	BY	CHKD	APP'D	NO.	DATE	REVISIONS	BY	CHKD	APP'D
1						1					
2						2					
3						3					
4						4					
5						5					
6						6					
7						7					

8301250295

- NOTES
- FOR LEGEND AND GENERAL NOTES REFER TO DWG 13-E-228-001 THROUGH 007.
 - NOTES EQUIPMENT NUMBER FOR COMPLETE EQUIPMENT NUMBER REFER TO CARLING W-054 DIAGRAM.
 - ELECTRICAL INOPERABLE STATUS ALARMS CONTACTS OPEN ON:
 - LOSS OF DC CONTROL POWER
 - NOT IN REMOTE CONTROL MODE
 - LOCAL TRIP
 - MANUAL EMERGENCY TRIP
 - MECHANICAL INOPERABLE STATUS ALARMS (O/F/L) CONTACTS OPEN ON:
 - AIR RECEIVER LOW AIR PRESSURE
 - AIR RECEIVER ISOLATION VALVE CLOSED
 - TURBINE GEAR CHANGED
 - VALVE SWITCH IS CLOSED WHEN P.M. OIL SUPPLY VALVE IS FULLY OPEN

DEGTEL
LOS ANGELES

ARIZONA NUCLEAR POWER PROJECT
PAJO VERDE NUCLEAR GENERATING STATION

ELEMENTARY DIAGRAM
DIESEL GENERATOR SYSTEM
DIESEL ENGINE (A-DGA-HO) CONTROL

DATE PLOD: 10/07
JOB NO: 13-E-068-007
SHEET NO: 1 OF 2

RIDS

8301250295

