


10407

CERTIFIED DRAWING

13-E-CHB-025

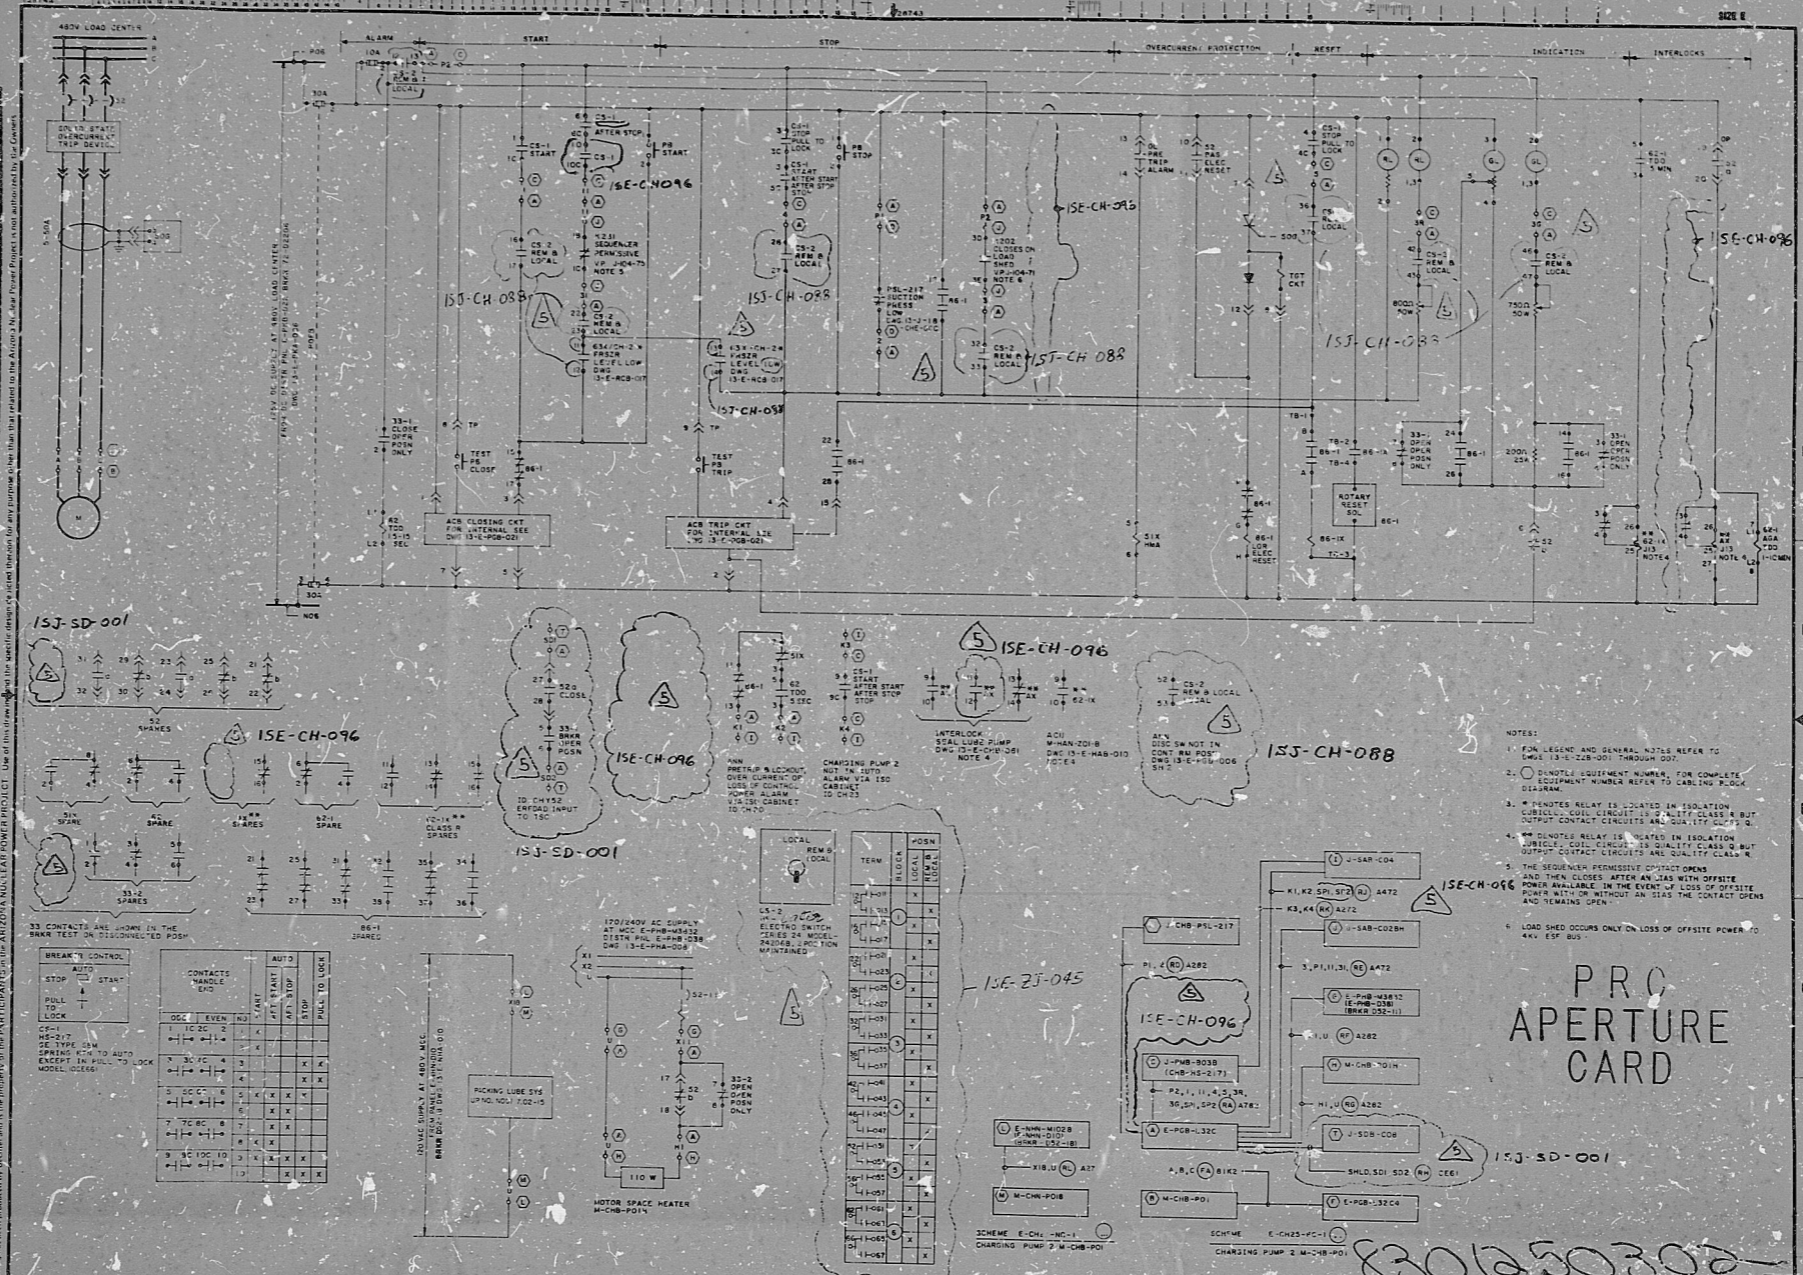

NO.	DATE	REVISION	BY	CHKD	APP'D	DESCRIPTION
1						INCORP DENYS & GENERAL REVISION
2						INCORP DENYS P-23, 4 AND LOCAL REVISION
3						INCORP DENYS 18 GEN REV
4						ADDED CE SITE INFORMATION
5						REVISION FOR CONSTRUCTION

SECTEL
LOS ANGELES

ARIZONA NUCLEAR POWER PROJECT
LAO VERDE NUCLEAR GENERATING STATION

NUCLEAR SAFETY RELATED
ELEMENTARY DIAGRAM
CHEMICAL & VOLUME CONTROL SYSTEM
CHARGING PUMP 2
M-CHB-PO2

SCALE: NONE DRAWING NO. 10407 13-E-CHB-025 5

8301250302

RIDS

8301250302

