

17"

11"

8.5"

8.5"

11"

17"

17"

11"


8.5"

8.5"

11"

17"

This drawing and the design it covers are the property of BECHTEL. They are hereby loaned and on the borrower's section agreement that they will not be reproduced, copied, loaned, exhibited, or used except in the limited way and private use permitted by any written consent given by the lender to the borrower.

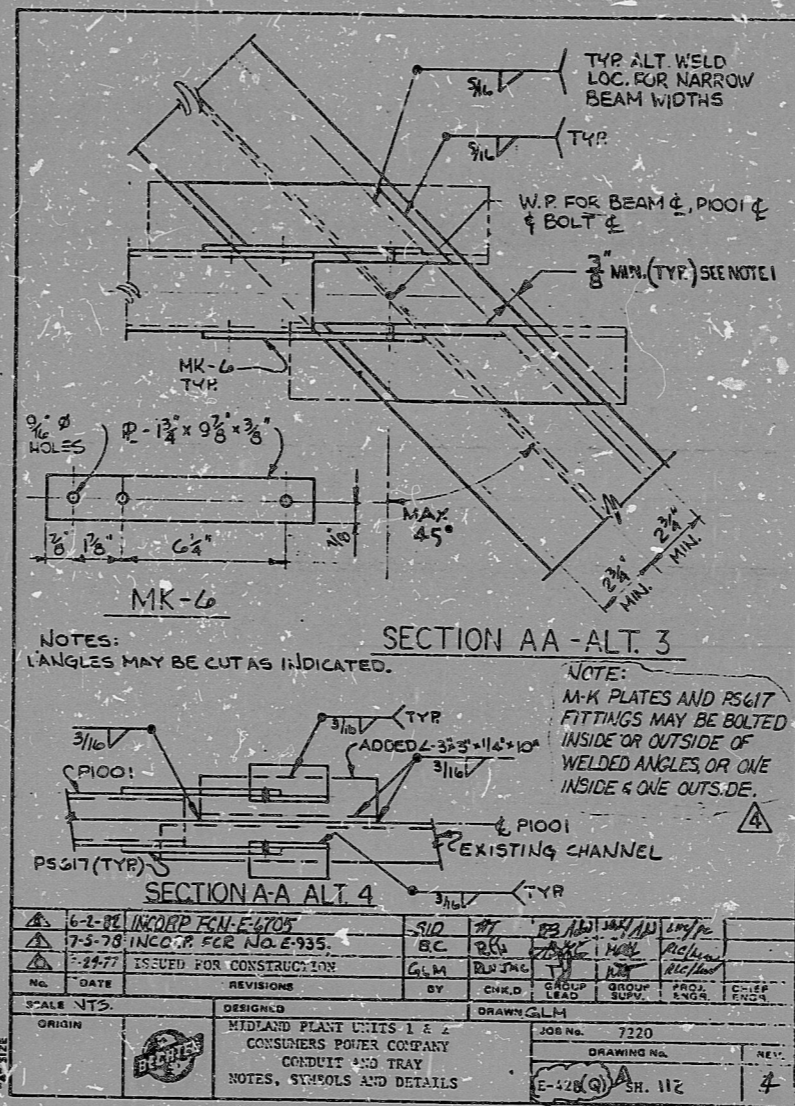

SCALE NTS.		DESIGNED		DRAWN		JOB No.		DRAWING No.		REV.
ORIGIN		MIDLAND PLANT UNITS 1 & 2 CONSUMERS POWER COMPANY CONDUIT AND TRAY NOTES, SYMBOLS AND DETAILS		DRAWN G.L.M.		7220		E-426 (Q) SH. 112		4

PRC  
APERTURE  
CARD

I certify that the image contained on this frame was made in the normal and regular course of business, on the date stated below and that it is an accurate reproduction of the document submitted to reprographics.

8302020453

RIDS

