


17"  
11"  
8.5"  
11"  
8.5"  
17"

This drawing and the design it covers are the property of BECHTEL. They are hereby loaned to you for the purpose of carrying out the work specified in the contract. No part of this drawing or design is to be reproduced, copied, loaned, exhibited, or used except in the limited way and for the limited purpose intended by the lender, to the borrower.

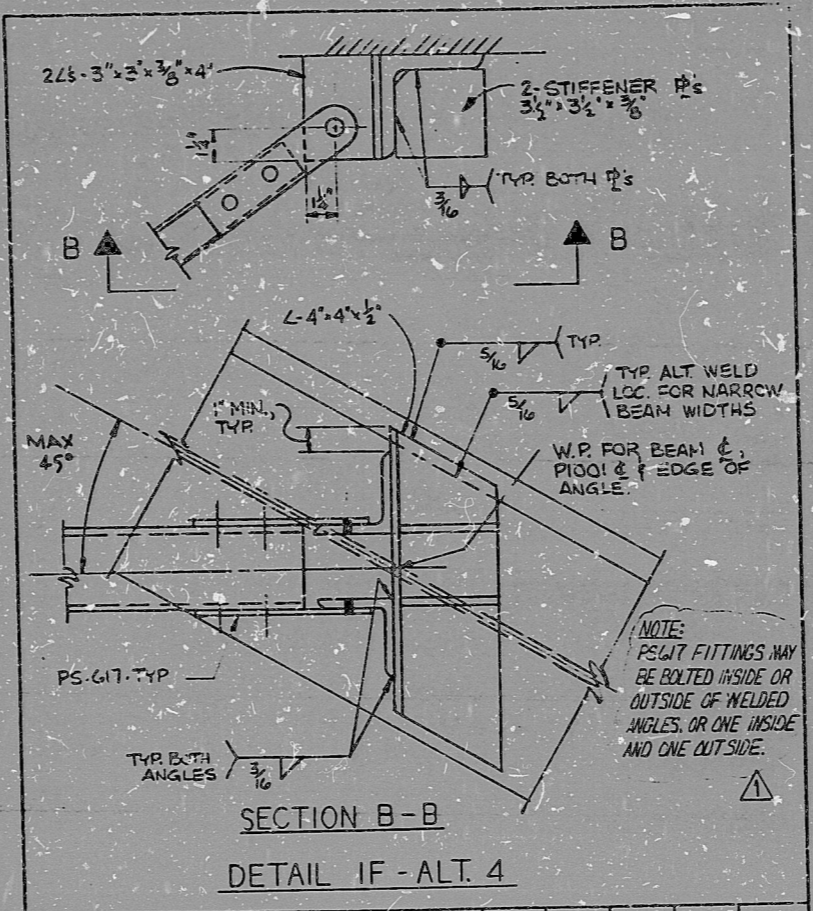

6-2-81	INCORP. FCN-F-6705	SID	HT	PS	W	SK	LD	W	LD
4-17-77	ISSUED FOR CONSTRUCTION	GLM	BUJMC	W	W	W	W	W	W
NO.	DATE	REVISIONS	BY	CHKD	GROUP	GROUP	PROGR	CHIEF	ENGR.
SCALE NTS		DESIGNED		DRAWN G.L. MARTIN					
ORIGIN		MIDLAND PLANT UNITS 1 & 2 CONSISTENS POWER COMPANY CONDUIT AND TRAY NOTES, SYMBOLS AND DETAILS		JOB NO. 7220		DRAWING NO. REV.			
				E-42B(G) SH. 113		1			

PRO APERTURE CARD

I certify that the image contained on this frame was made in the normal and regular course of business, on the date stated below and that it is an accurate reproduction of the document submitted to reprographics.

17"  
11"  
8.5"  
11"  
8.5"  
17"

8302020457

RIDS

