

17"

11"

8.5"

8.5"

11"

17"

17"

11"


8.5"

8.5"

11"

17"

This drawing and its details are the property of BECHTEL. They are hereby loaned and on the borrower's contract agreement that they will not be reproduced, copied, loaned, exhibited, or used except in the limited way and for the limited purpose permitted by a written contract given by a member of the loaning party.

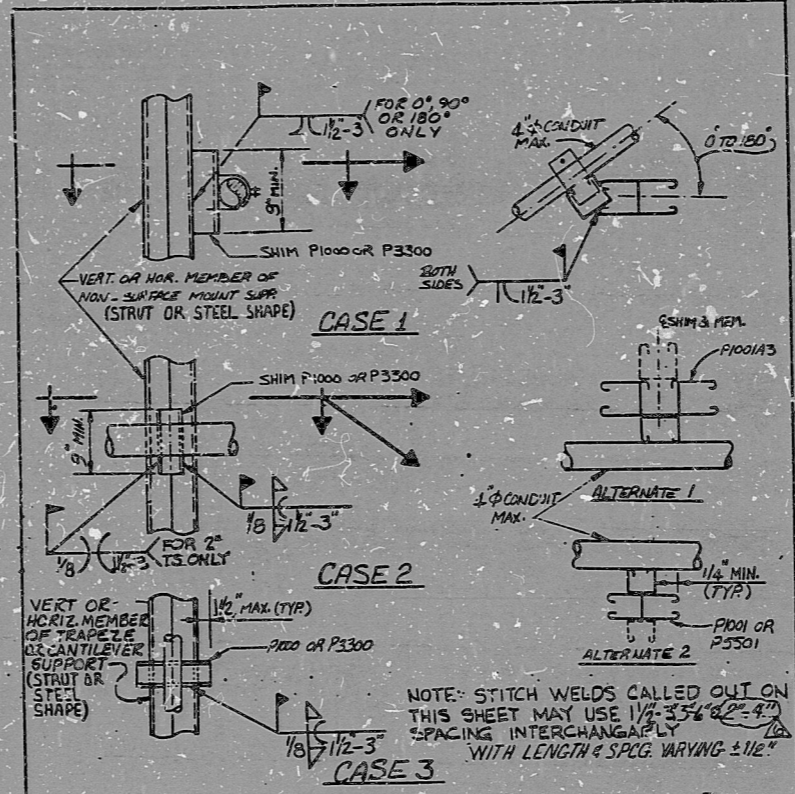

DETAIL 600 TYPICAL SHIM DETAILS FOR TRAPEZE AND CANTILEVER TYPE SUPPORTS

NO.	DATE	REVISIONS	BY	CHKD.	GROUP	GROUP	PAGE	CHIEF
11-2-82		UNCLIP FROM 778						
8-14-82		REVISED AS NOTED						
8-1-82		UNCLIP FROM REV. TITLE BLOCK						
11-13-77		ISSUED FOR CONSTRUCTION						

SCALE	N/A	DESIGNED	MIDLAND PLANT UNITS 1 & 2		JOB No.	7220
ORIGIN			CONSUMERS POWER COMPANY		DRAWING No.	
			CONDUIT AND TRAY		E-428(G) SR. 362	REV. 6
			NOTES, SYMBOLS AND DETAILS			

PRO APERTURE CARD

I certify that the image contained on this frame was made in the normal and regular course of business, on the date stated below and that it is an accurate reproduction of the document submitted to reprographites.

16X

RIDS

8302020478

