

17"

11"

8.5"

8.5"

11"

17"

17"


11"

8.5"

8.5"

11"

17"

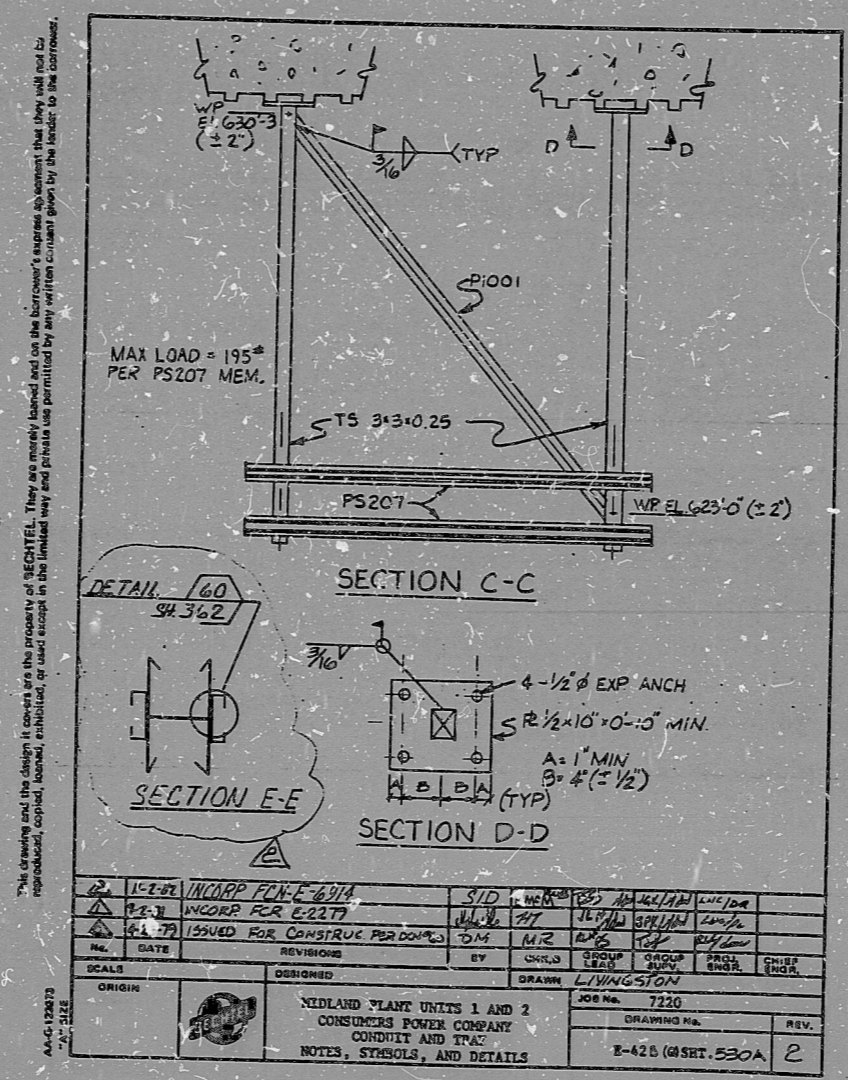

16X

I certify that the linings contained on this frame was made in the normal and regular course of business, on the date stated below and that it is an accurate reproduction of the document submitted to reprographics.

11-16-82
DATE

Don Buckholz
CAMERA OPERATOR
REPROGRAPHICS

PRC APERTURE CAP

RIDS

8302020489

