


17" 11" 8.5" 8.5" 11" 17"

This drawing and the design it covers are the property of BECHTEL. They are merely loaned and on the borrower's express agreement that they will not be reproduced, copied, loaned, exhibited, or used except in the limited way and please as permitted by the written consent given by the lender to the borrower.

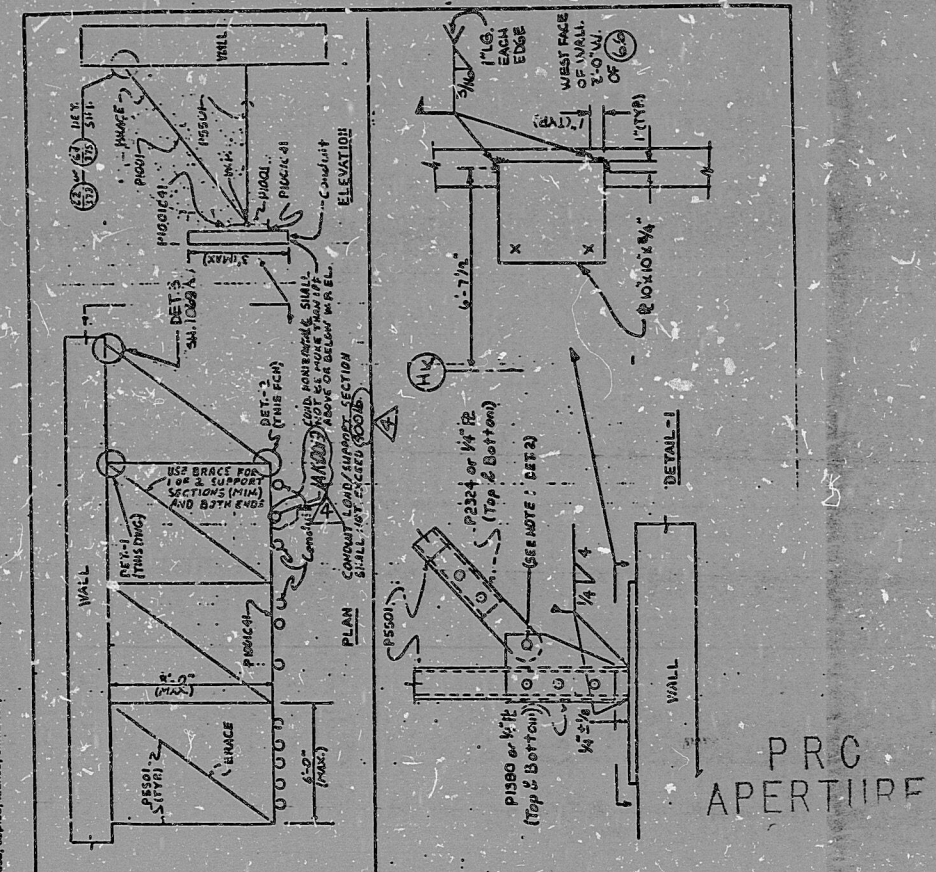

11-2-02	INCORP FOR E-2468	Q/D	SW/CM	BE	AL	J-L	HAD	REVISED
11-1-00	INCORP FOR E-2454	Q/D	SW/CM	BE	AL	J-L	HAD	REVISED
12-1-99	ISSUED FOR CONSER. IN DRP FOR E-313	PPP	CLD	PLS	REV	ENG	ENGR	REVISED
No.	DATE	REVISIONS	BY	CHK'D	GROUP LEAD	GROUP SVR	ENGR	ENGR
SCALE	N/A	DESIGNED		DRAWN	PPP			
ORIGIN	MIDLAND PLANT UNITS 1 AND 2		CONSOLIDATED POWER COMPANY		CONDITRY AND TRAY		NOT'S, SYMBOLS, AND DETAILS	
					JOB No.	7220	DRAWING No.	REV.
						E428 (Q) SH. 1068	4	

I certify that the image contained on this frame was made in the normal and regular course of business, on the date stated below and that it is an accurate reproduction of the document submitted to reprographer.

ALGX

17" 11" 8.5" 8.5" 11" 17"

8302020503

RIDS

