


17"
11"
8.5"
8.5"
11"
17"

17"
11"
8.5"
8.5"
11"
17"

This drawing and the design it covers are the property of BECHTEL. They are merely loaned and on the borrower's express agreement that they will not be reproduced, copied, loaned, exhibited, or used except in the limited way and private use permitted by any written consent given by the lender to the borrower.

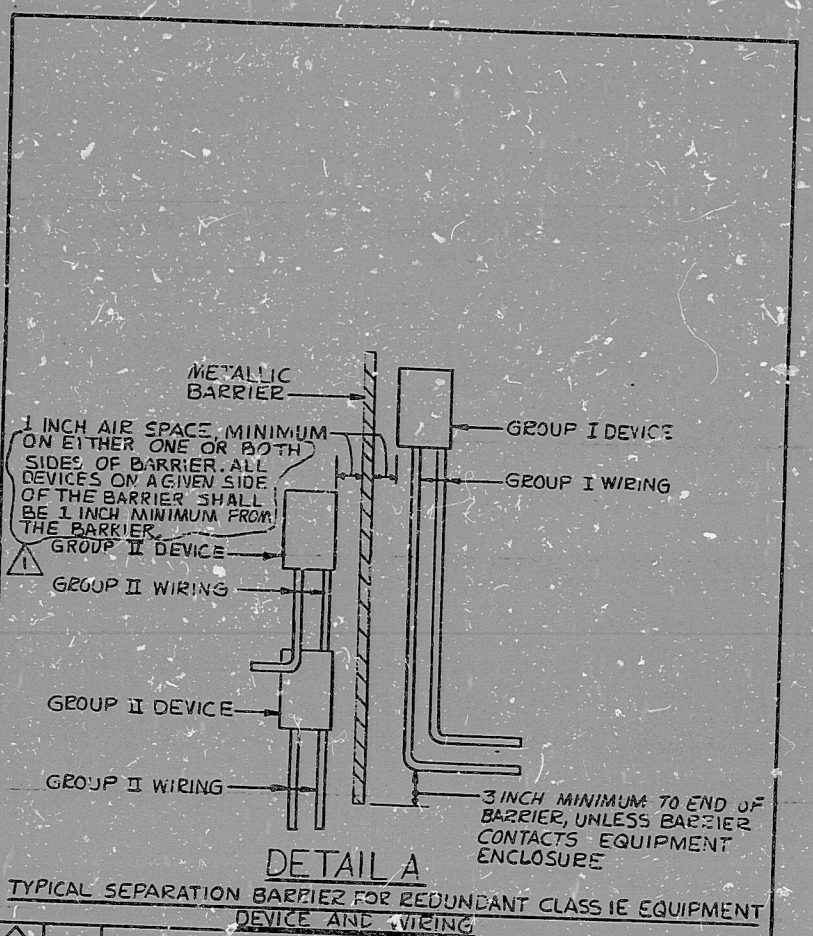

DETAIL A
TYPICAL SEPARATION BARRIER FOR REDUNDANT CLASS 1E EQUIPMENT DEVICE AND WIRING

NO.	DATE	REVISIONS	BY	CHKD.	GROUP LEAD	GROUP SUPV.	PROJ. ENGR.	CHIEF ENGR.
SCALE		DESIGNED		DRAWN		JOB No.		
ORIGIN		MIDLAND PLANT UNITS 1 AND 2		CONSUMERS POWER COMPANY		DRAWING No.		
AS TO SIZE		NOTES AND DETAILS FOR SEPARATION OF CLASS 1E EQUIPMENT AND CIRCUITS		E-47(R) SH. 13		REV.		

PRO APERTURE CARD

I certify that the image contained on this frame was made in the normal and regular course of business, on the date stated below and that it is an accurate reproduction of the document submitted to reprographics.

RIDS

8302030156

