

17"

11"

8.5"


17"

11"

8.5"

This drawing and the design it covers are the property of BECHTEL. They are hereby loaned and on the borrower's express agreement that they will not be reproduced, copied, loaned, exhibited, or used except in the limited way and permits as permitted by any written consent given by the lender to the borrower.

REV.	LOAD DESCRIPTION	EQUIP. No.	MCC No.	SCHEM. No.	CONT. No.	BREAKER				STARTER		WIRE SIZE (AWG)	LOAD KVA	FULL LOAD AMPS	CONT. AMPS.	
						FRAME SIZE	TRIP SETTING	INST. TRIP	TRIP TYPE	STARTER TYPE	REMARKS					
3	CONTROL ROOM AIR HANDLING UNIT HEATER OVM-01A	OVM-01A	0B4923	E-457	0A24923	100	100									
8	EMERGENCY FUEL AREA EXHAUST FAN OVV-36A	OVV-36A	0B4926	E-492	0A24926	100	150			4	IA-30	#2	40.9KW	78.3		
8	ESF PUMP ROOM FILTRATION DAMPER CMO-54007	CMO-54007	0B4527	E-452	0A24527	100	3			1	2A	#14	2.6KW	.55		
5	CONTROL ROOM MAKE UP HUMIDIFIER HEATER OVE-63A	OVE-63A	0B4925	E-456	0A24925	100	25					#6	15 KW	22.14		
4	DELETED															
7	ESF PUMP ROOM FILTRATION FAN OVV-134	OVV-134	0B4930	E-452	0A24930	100	30			1	IA-13	#10	7.5	10.5		
6	INSTRUMENT TRANSFORMER OX-57	OX-57	0B4931	E-47	0A24931	100	60					2/C	25 KVA	52.1		

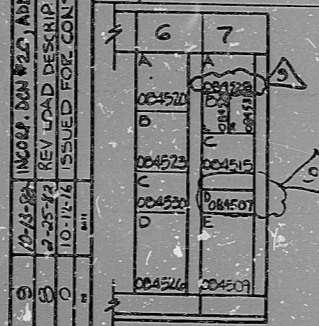

CLASS I E 460V MOTOR CONTROL CENTER No. 0B45  
 LOCATION: AUX BLDG AREA 3 EL. 689'-0"  
 REF. DWG: 7220-E7-29

BECHTEL  
ANN ARBOR, MICHIGAN

MIDLAND PLANT UNITS 1 & 2  
CONSUMERS POWER COMPANY

CLASS I E 460V MOTOR CONTROL CENTER  
SCHEDULE UNIT 2 & COMMON

JOB No.	DRAWING No.	REV.
7220	E-181Q	SH15 9

16X

CERTIFICATE OF MICROFILMING  
 I certify that the image contained on this frame was made in the normal and regular course of business, on the date stated below and that it is an accurate reproduction of the document submitted to the contractor for filming, by Bechtel Power Corporation.

DATE: 0-20-87  
 CAMERA OPERATOR: Pam Smith  
 CONTRACTOR SUPERVISOR: Sue Crockett

P.R.C APERTURE CARD

8.5"

11"

8.5"

11"

17"

17"

RIDS

8302030287

