


17  
11  
8.5  
8.5  
11  
17

17  
11  
8.5  
8.5  
11  
17

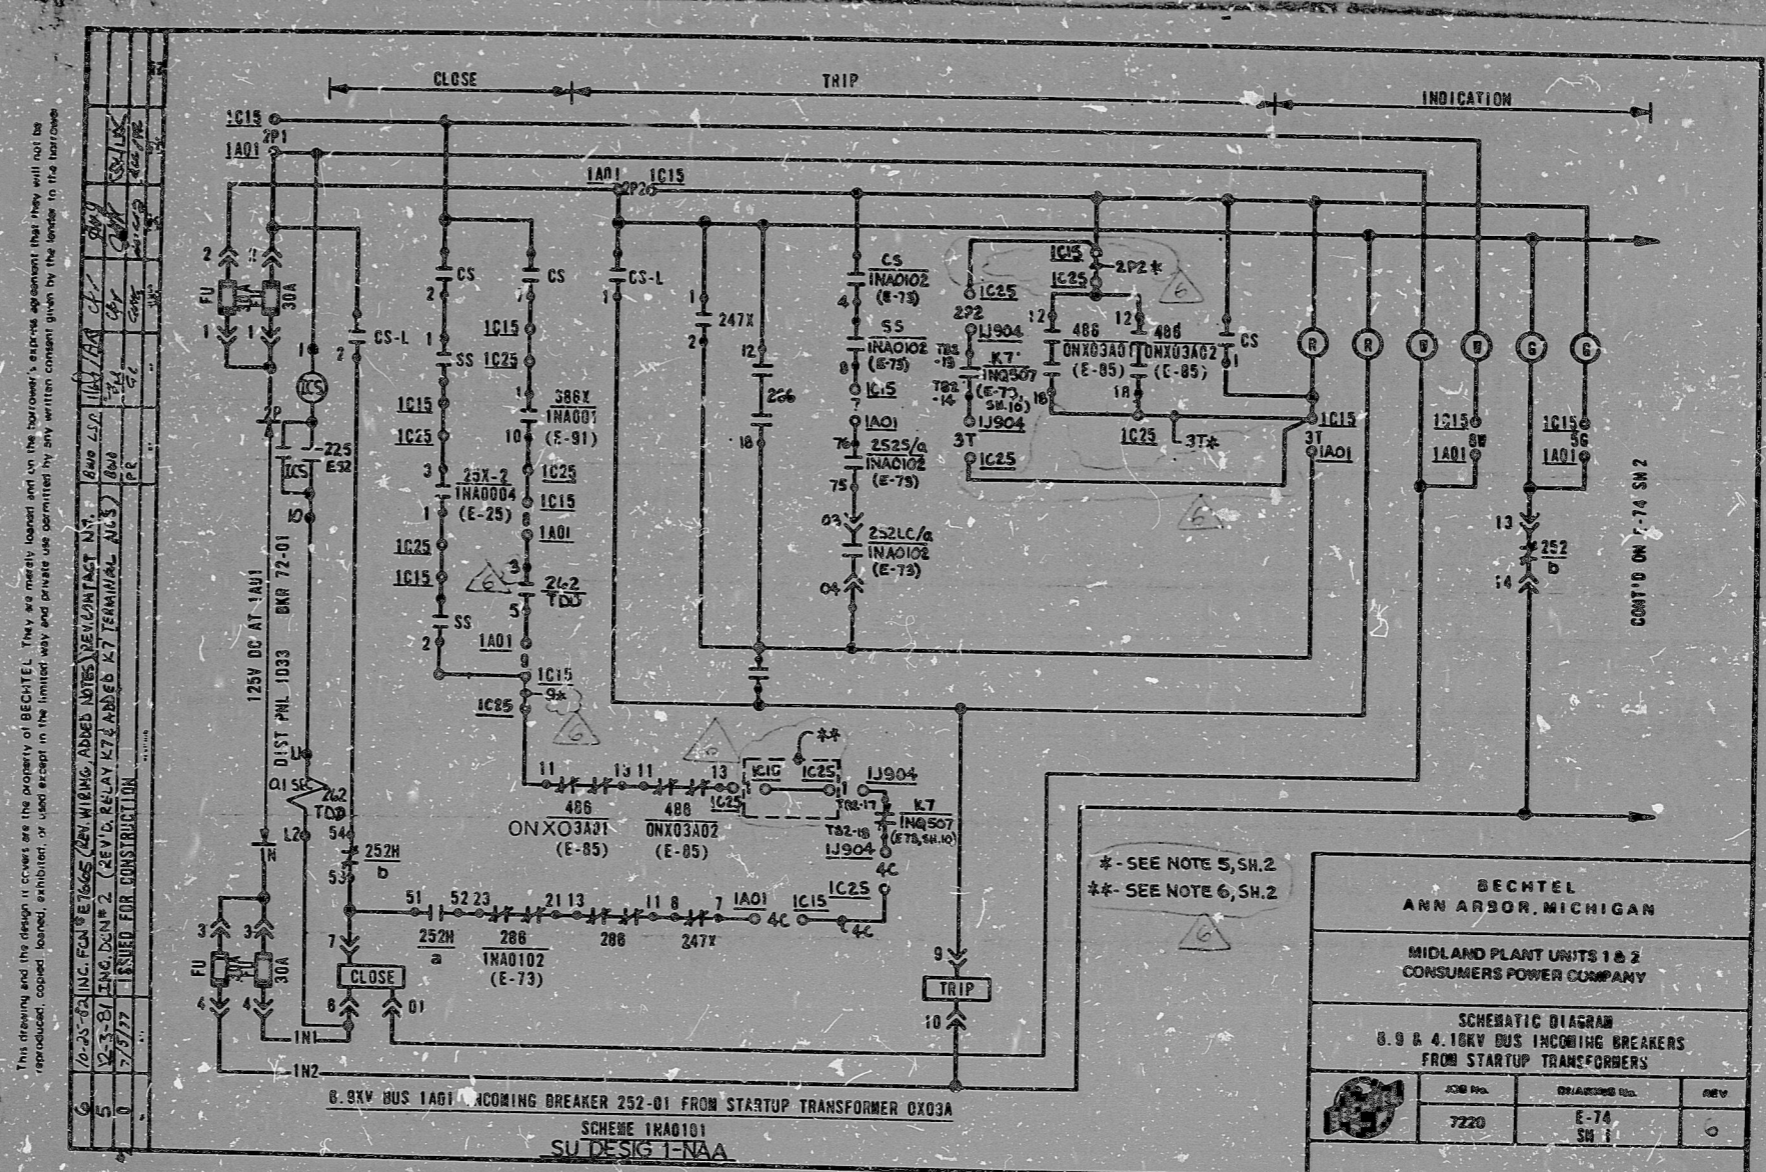

This drawing and the design it covers are the property of BECHTEL. They are hereby loaned and on the borrower's express agreement that they will not be reproduced, copied, loaned, exhibited, or used except in the limited way and private use permitted by any written consent given by the issuer in the form hereon.


I certify that the image contained on this frame was made in the normal and regular course of business, on the date stated below and that it is an accurate reproduction of the document submitted to the contractor for filming, by Bechtel Power Corporation.

DATE: 10-27-62  
CAMERA OPERATOR: M. G. ...  
CONTRACTOR'S SUPERVISOR OR MANAGER: M. G. ...

16X

PRC APERTURE CARD



RIDS

8302030493

