


THIS DRAWING AND THE DESIGN IT CARRIES ARE THE PROPERTY OF BECHTEL. THEY ARE HEREBY LOANED AND NOT TO BE REPRODUCED, COPIED, LOANED, REPRODUCED, OR USED IN ANY MANNER WITHOUT THE WRITTEN CONSENT GIVEN BY THE LICENSE TO THE ENGINEER.

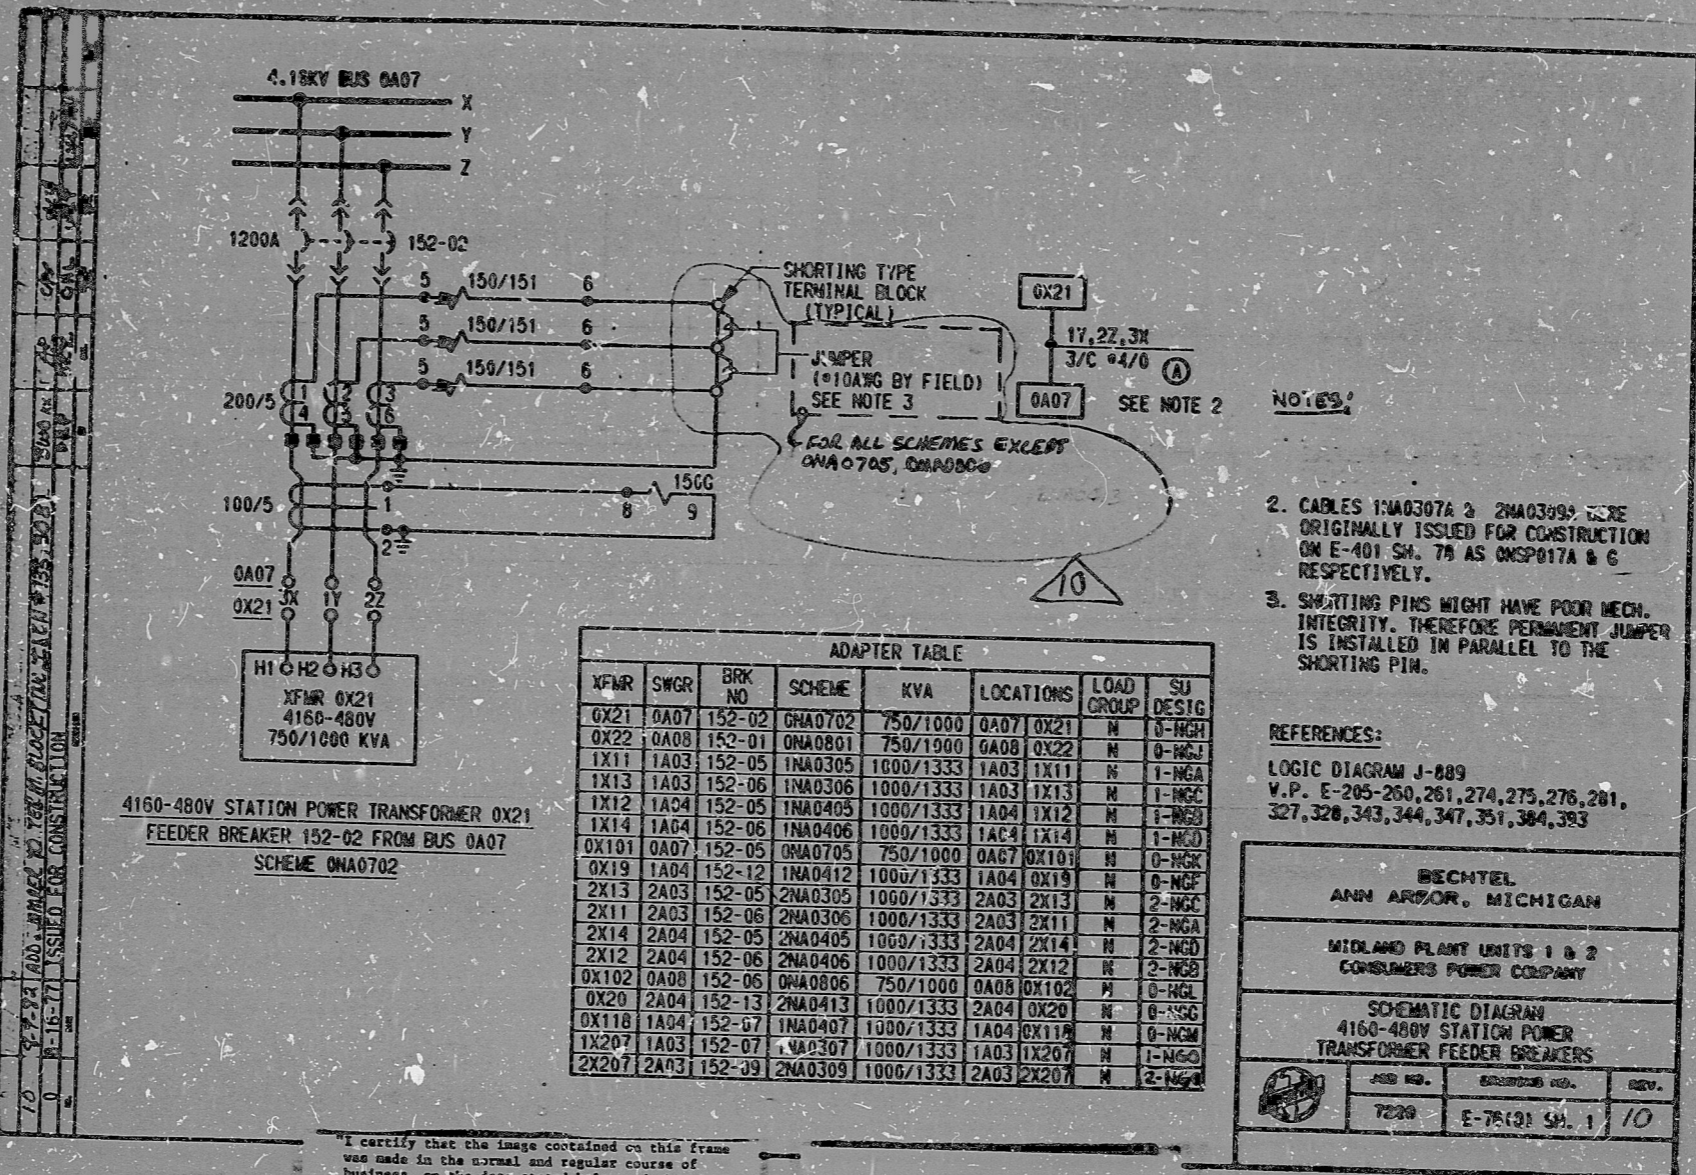

10	2-2-73	ADD JUMPER TO TERMINAL BLOCK
0	8-16-77	ISSUED FOR CONSTRUCTION

XFMR	SWGR	BRK NO	SCHEME	KVA	LOCATIONS	LOAD GROUP	SU DESIG

- NOTES:**
- CABLES 1A0307A & 2A0309A WERE ORIGINALLY ISSUED FOR CONSTRUCTION ON E-401 SH. 75 AS ONSP017A & C RESPECTIVELY.
 - SHORTING PINS MIGHT HAVE POOR MECH. INTEGRITY. THEREFORE PERMANENT JUMPER IS INSTALLED IN PARALLEL TO THE SHORTING PIN.
- REFERENCES:**
- LOGIC DIAGRAM J-889
V.P. E-205-250, 261, 274, 275, 276, 281, 327, 328, 343, 344, 347, 351, 384, 393

BECHTEL ANN ARBOR, MICHIGAN		
MIDLAND PLANT UNITS 1 & 2 CONSUMERS POWER COMPANY		
SCHEMATIC DIAGRAM 4160-480V STATION POWER TRANSFORMER FEEDER BREAKERS		
JOB NO.	ENGINEER NO.	REV.
7229	E-76131 SH. 1	10

I certify that the image contained on this frame was made in the normal and regular course of business, on the date stated below and that it is an accurate reproduction of the document submitted to the contractor for filming, by Bechtel Power Corporation.

8-10-52 DATE
M. C. 12541 CAMERA OPERATOR
J. C. Thomas CONTRACTOR'S SUPERVISOR OR MANAGER

16X PRC APERTURE CARD

RIDS

8302030513

