

17"


11"

8.5"

17"

11"

8.5"

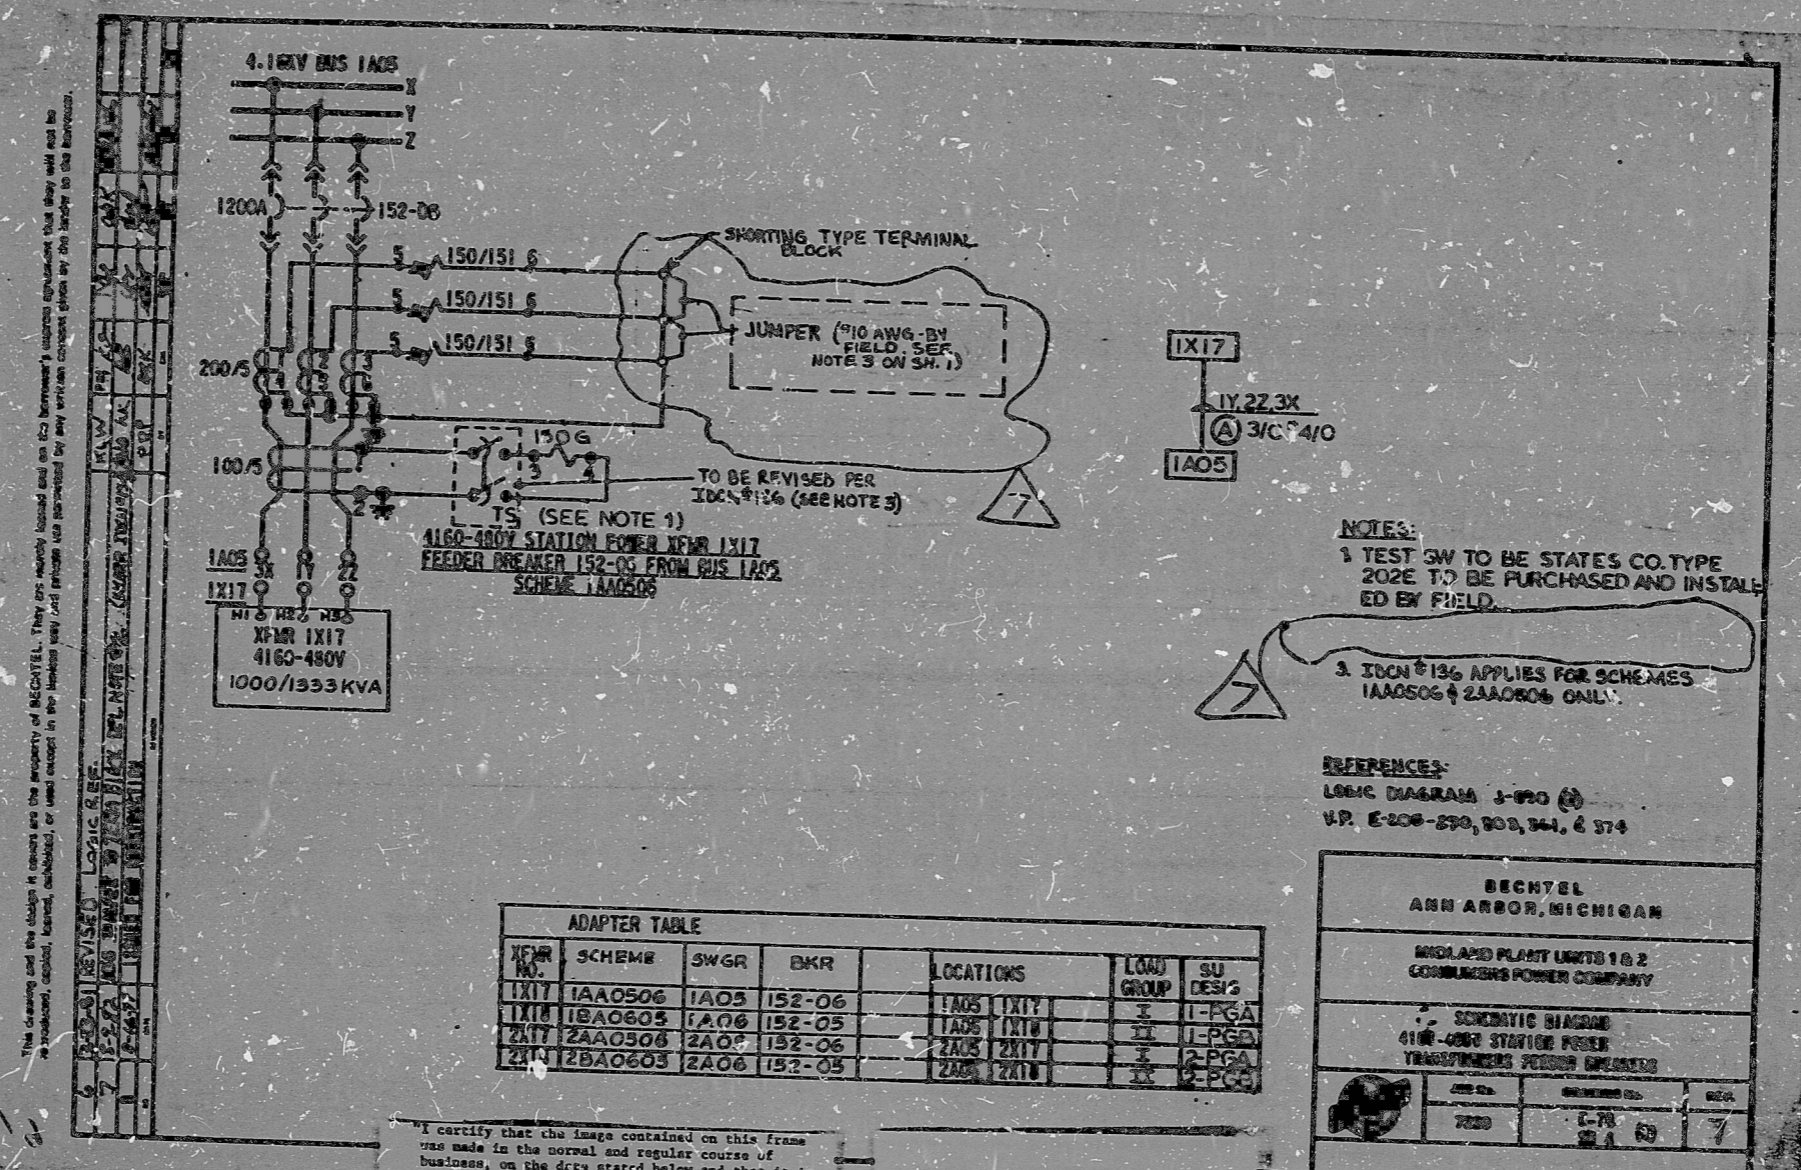

The drawing and the design it covers are the property of BECHTEL. They are hereby loaned and are to be returned to BECHTEL. They are not to be reproduced, copied, loaned, exhibited, or used except in the limited way and for the limited purpose intended by BECHTEL. The drawing is to be returned to BECHTEL.

NOTES:
 1 TEST SW TO BE STATES CO. TYPE 202E TO BE PURCHASED AND INSTALLED BY FIELD.

2 ICON #136 APPLIES FOR SCHEMES 1AA0506 & 2AA0606 ONLY.

REFERENCES:
 LOGIC DIAGRAM 3-790 (C)
 U.P. E-206-270, 303, 341, & 374


BECHTEL ANN ARBOR, MICHIGAN		
SCHEMATIC DIAGRAM 4160-480V STATION POWER TRANSFORMERS FEEDER BREAKERS		
REV. NO.	REVISION	DATE
7000	C-70 S.A. 10	7

I certify that the design contained on this frame was made in the normal and regular course of business, on the day stated below and that it is an accurate reproduction of the document submitted to the contractor for filing, by Bechtel Power Corporation.

8/12/52 DATE
 M. C. ... CAMERA OPERATOR
 J. Ottamer CONTRACTOR'S SUPERVISOR OR MANAGER

16X

PRO APERTURE CARD

8.5"

11"

17"

8.5"

11"

17"

RIDS

8302020516

