
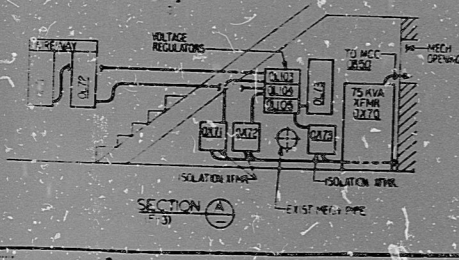


E-554 SH. 1 OF 1

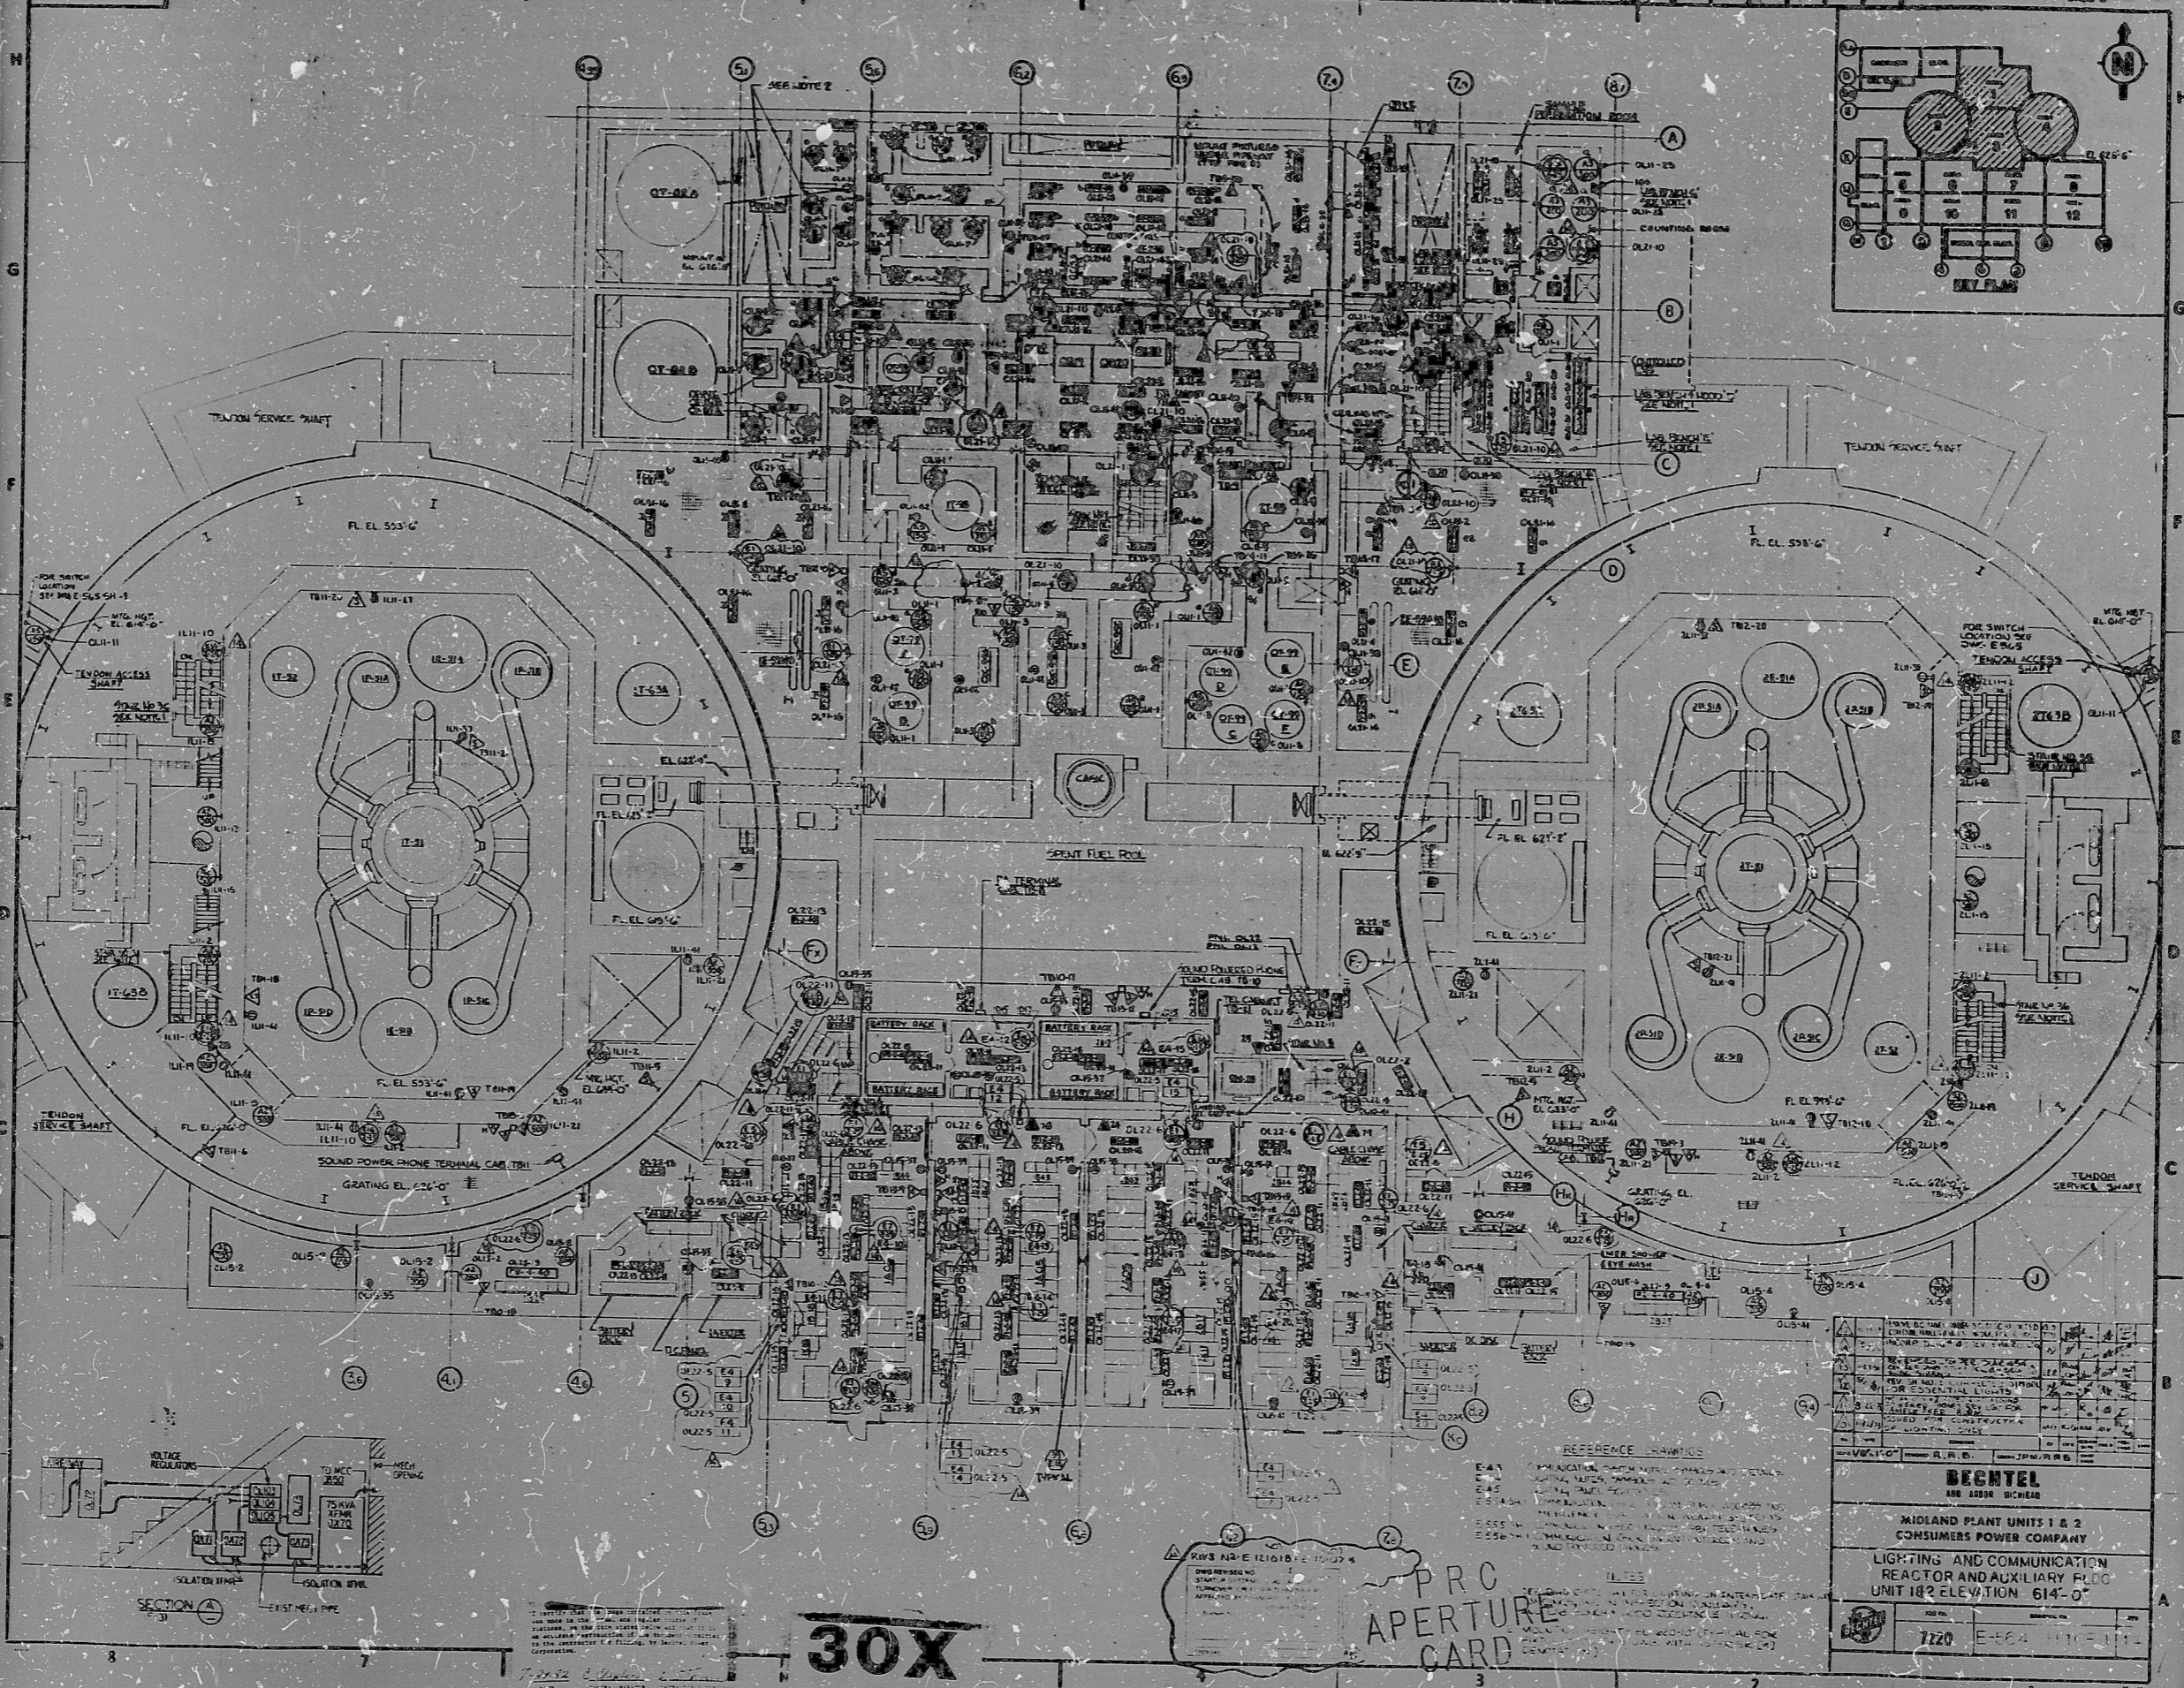

NOTES:

30X

PRO APERTURE CARD

- REFERENCE DRAWINGS
NO.	DESCRIPTION	DATE	BY	CHKD.

BECHTEL
 MIDLAND PLANT UNITS 1 & 2
 CONSUMERS POWER COMPANY
 LIGHTING AND COMMUNICATION
 REACTOR AND AUXILIARY FLOOR
 UNIT 182 ELEVATION 614'-0"

7120 E-554 SH. 1 OF 1

RIDS

8302030550

