
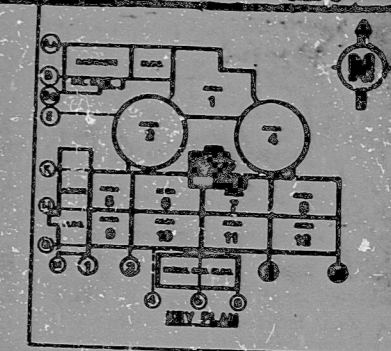





E-569 SH1 OF 1

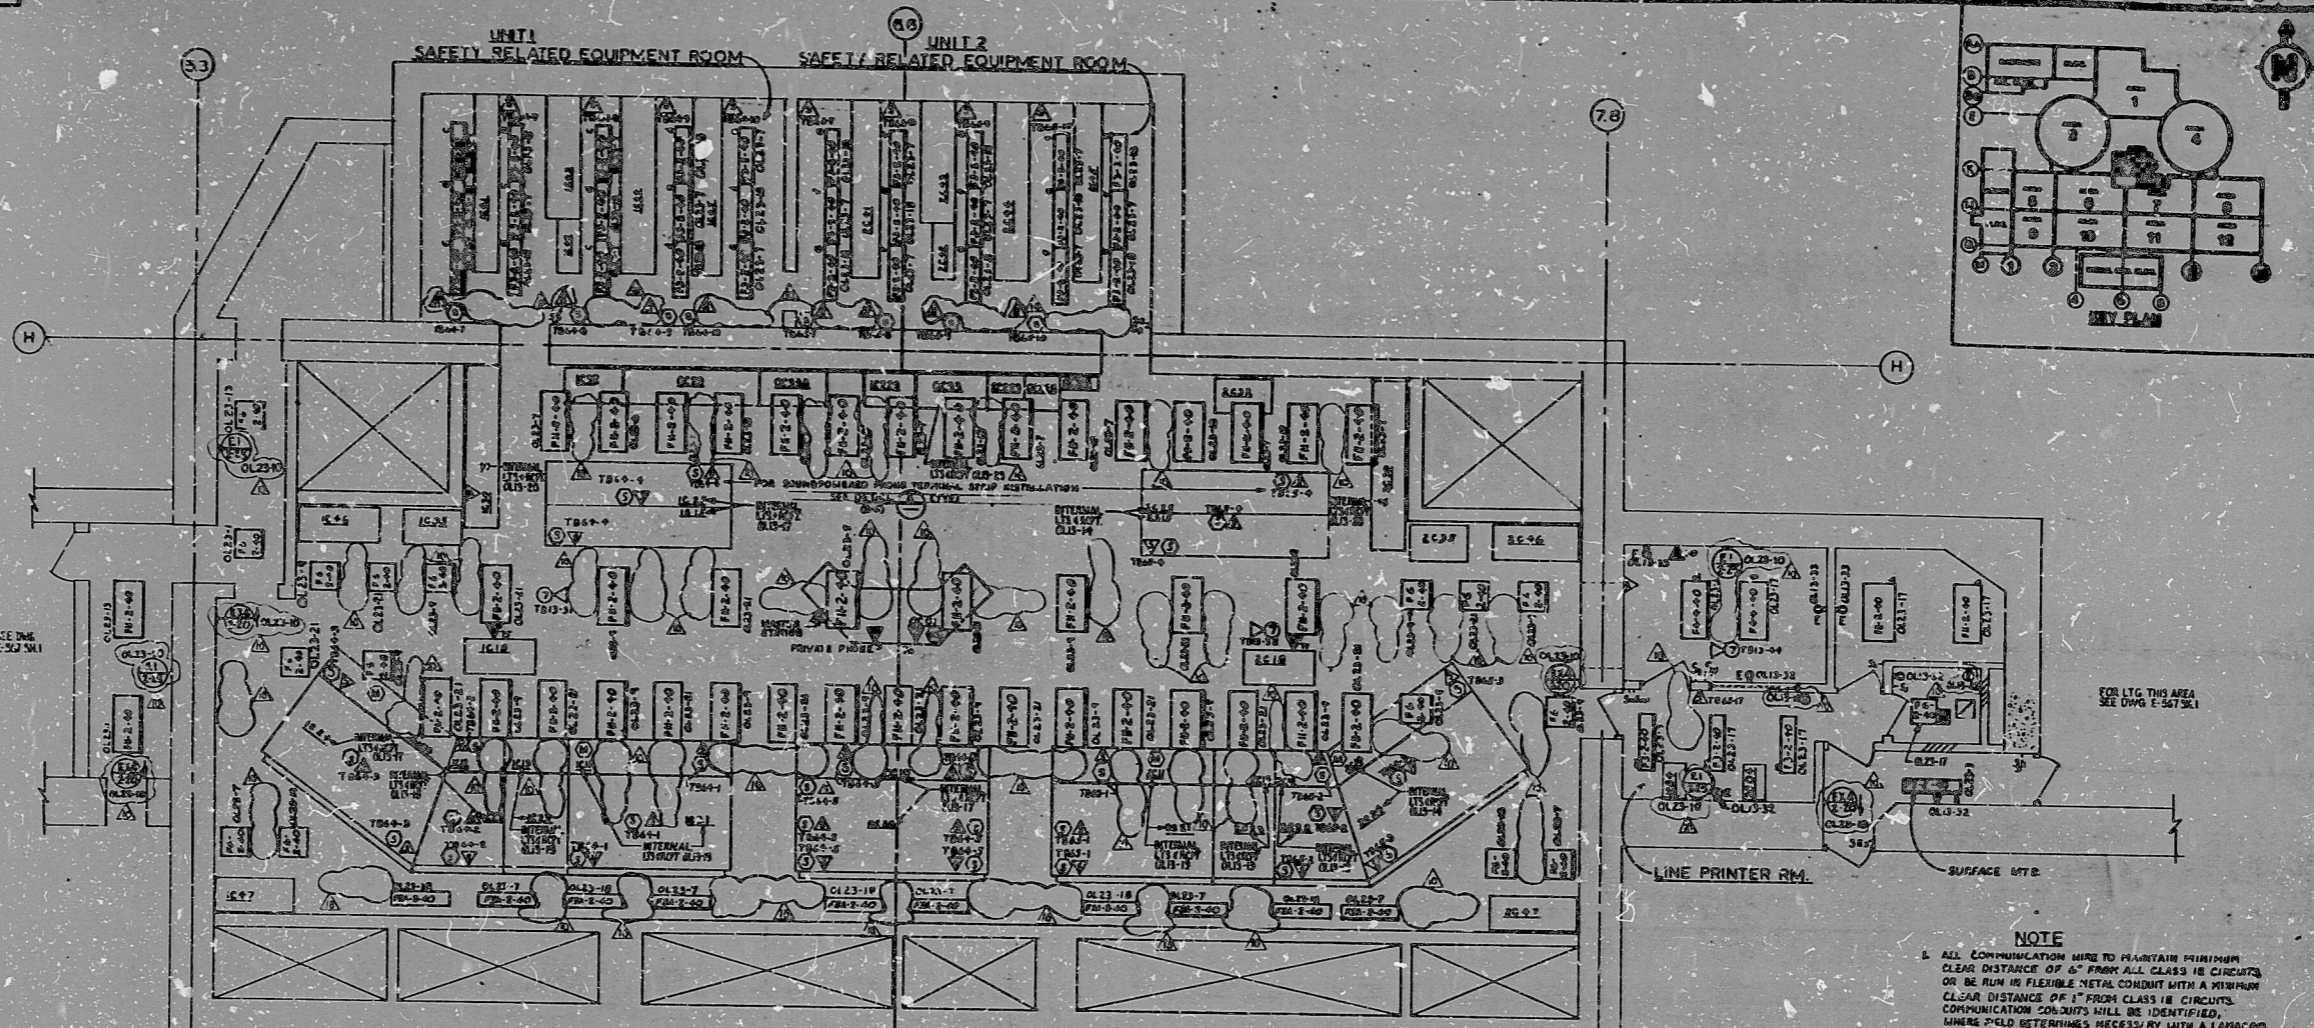

NOTE

1. ALL COMMUNICATION WIRE TO MAINTAIN MINIMUM CLEAR DISTANCE OF 6" FROM ALL CLASS 1B CIRCUITS OR BE RUN IN FLEXIBLE METAL CONDUIT WITH A MINIMUM CLEAR DISTANCE OF 1" FROM CLASS 1B CIRCUITS. COMMUNICATION CONDUITS SHALL BE IDENTIFIED. UNLESS FIELD DETERMINES NECESSARY WITH A LAMP-COD TAG TIE WIRE TO THE CONDUIT.

- REFERENCE DRAWINGS**
- E-4.3 COMMUNICATION SYSTEM NOTES / DETAILS
 - E-4.6 LIGHTING NOTES BY SYMBOLS / DETAILS
 - E-9.5 LIGHTING PANEL SCHEDULE
 - E-35.0 SMI COMMUNICATION RISER DISMANT - PUBLIC ADDRESS AND EMERGENCY EVACUATION ALARM SYSTEMS
 - E-35.5 SMI COMMUNICATION RISER DISMANT - PAX TELEPHONES
 - E-35.6 SMI COMMUNICATION RISER DISMANT - INTERCOM AND SOUND REINFORCED PHONE
 - A-75.00 REFLECTED CEILING PLANS

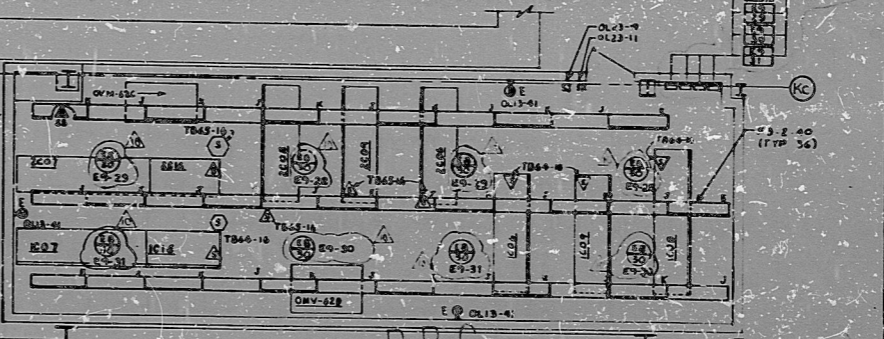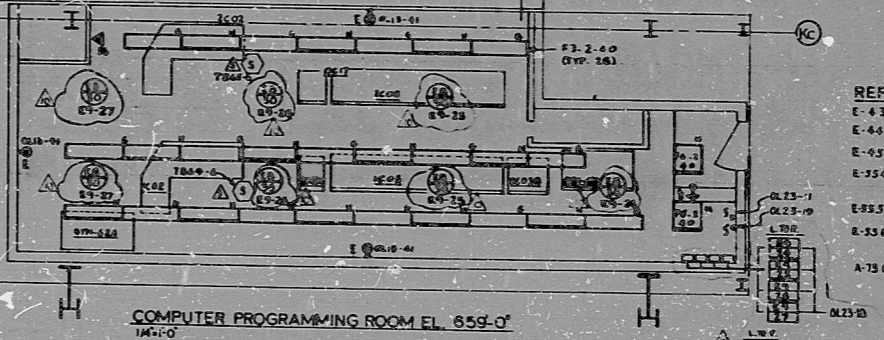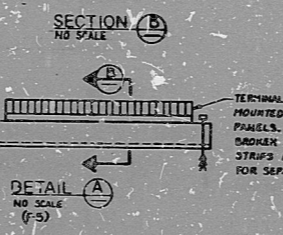

NO.	DESCRIPTION	DATE	BY	CHKD.
BECHTEL

CONSUMERS POWER COMPANY

LIGHTING AND COMMUNICATIONS
CONTROL ROOM

AWI
DATE: 10/15/68
DRAWING NO.: E-569 SH1 OF 1
REV.: 10

30X

COMPUTER INPUT ROOM
APERTURE CARD

THIS DRAWING IS FOR ELECTRICAL WORK ONLY FOR ALL OTHER DATA REFER TO APPLICABLE DRAWINGS


RIDS

8302030572

