
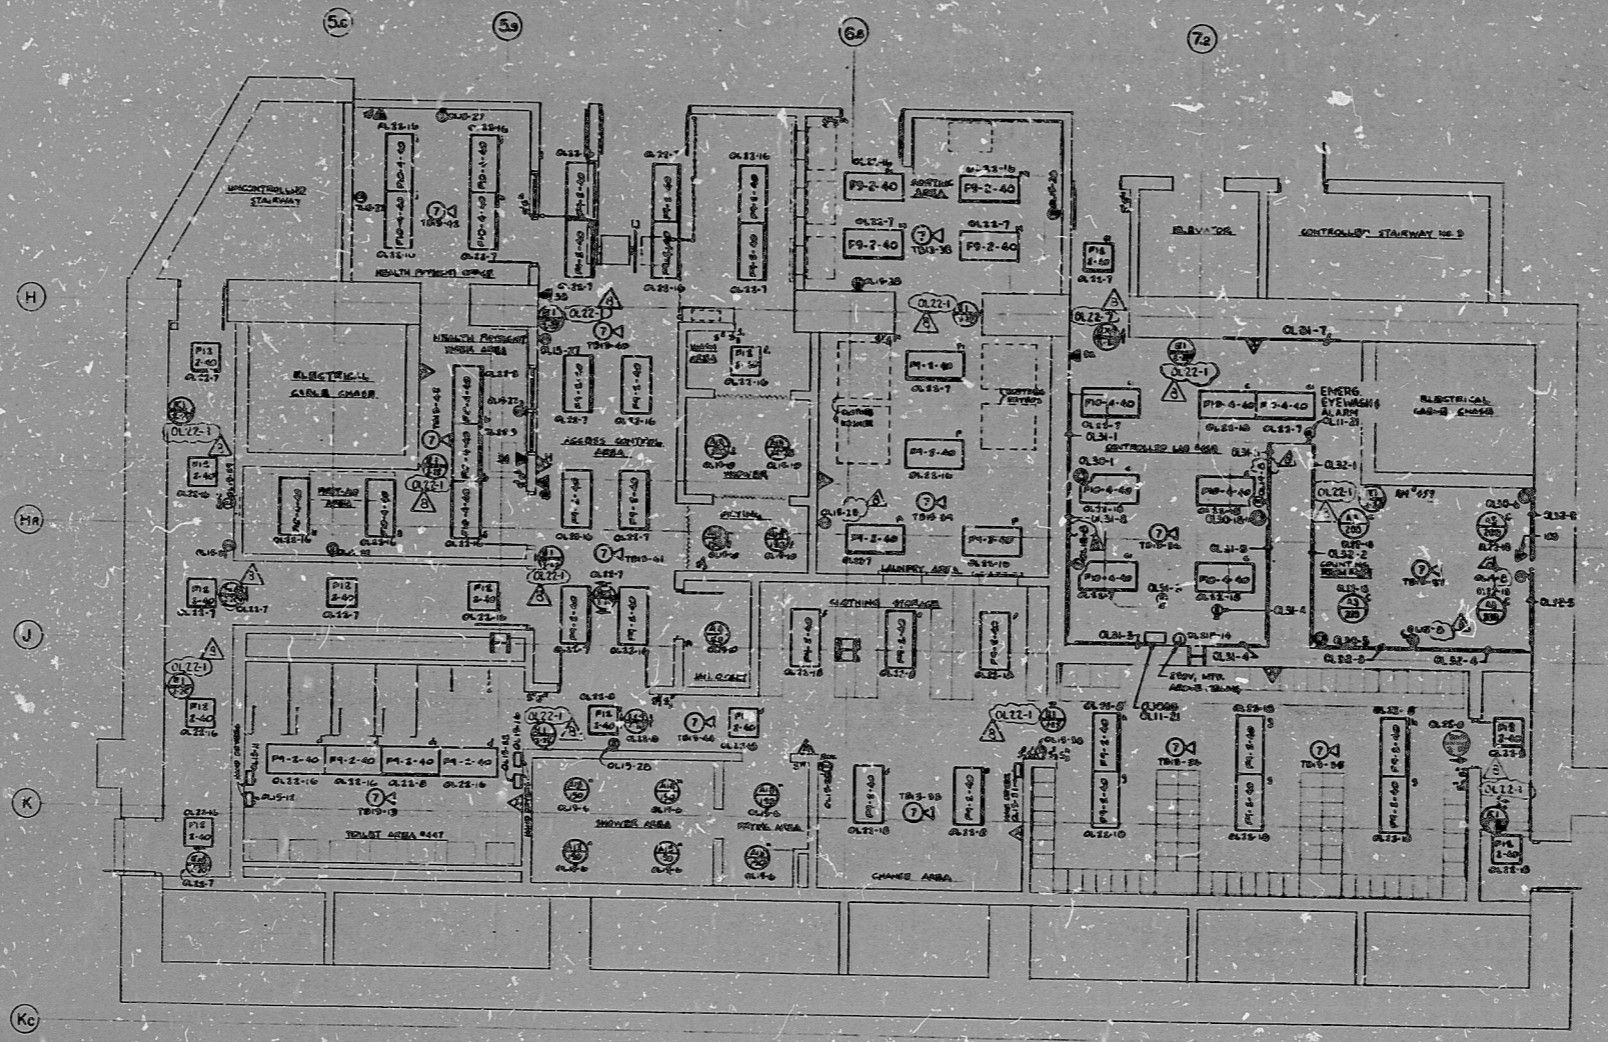


E-570 SH1 OF 1

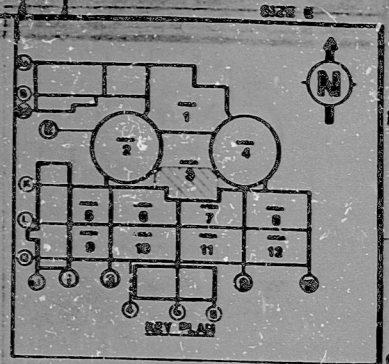

30X

THIS DRAWING IS THE PROPERTY OF THE U.S. GOVERNMENT AND IS LOANED TO YOU. IT AND ITS CONTENTS ARE NOT TO BE DISTRIBUTED OUTSIDE YOUR ORGANIZATION. IT IS TO BE RETURNED TO THE OFFICE OF ORIGIN UPON REQUEST.

- REFERENCE DRAWINGS
- E-43 COMMUNICATIONS SYSTEMS, SYMBOLS & LEGENDS
 - E-44 LIGHTING, WIRING, SYMBOLS & LEGENDS
 - E-45 LIGHTING SYMBOLS
 - E-569 30X COMMUNICATIONS ROOM DIAGRAM, PLAN, ADDRESS AND EXHAUSTION SYMBOLS
 - E-553 30X COMMUNICATIONS ROOM DIAGRAM, PLAN, TELEPHONE
 - A-60 ADDRESS CONTROL SYSTEM, 40X-60-6
 - A-60 COMMUNICATIONS LABORATORY, 40X-60-6
 - E-391 24 H. DISTRIBUTION PANEL, UNIT 1

APPROVED FOR CONSTRUCTION	DATE
REVISED FOR CONSTRUCTION	DATE
REVISED FOR CONSTRUCTION	DATE
REVISED FOR CONSTRUCTION	DATE
REVISED FOR CONSTRUCTION	DATE

BECHTEL
480 1830 BUCKNER

CONSUMERS POWER COMPANY

LIGHTING AND COMMUNICATIONS
ACCESS CONTROL AREA EL 534-6

NO.	DATE	REVISION
7320	E570SH1 OF 1	6

PRC APERTURE CARD

THIS DRAWING IS THE PROPERTY OF THE U.S. GOVERNMENT AND IS LOANED TO YOU. IT AND ITS CONTENTS ARE NOT TO BE DISTRIBUTED OUTSIDE YOUR ORGANIZATION. IT IS TO BE RETURNED TO THE OFFICE OF ORIGIN UPON REQUEST.

THIS DRAWING IS THE PROPERTY OF THE U.S. GOVERNMENT AND IS LOANED TO YOU. IT AND ITS CONTENTS ARE NOT TO BE DISTRIBUTED OUTSIDE YOUR ORGANIZATION. IT IS TO BE RETURNED TO THE OFFICE OF ORIGIN UPON REQUEST.

11

11

8.5

8.5

11

17

11

11

8.5

8.5

11

17

RIDS

8302030575

