

11


11

8.5"


8.5"

11"



17"

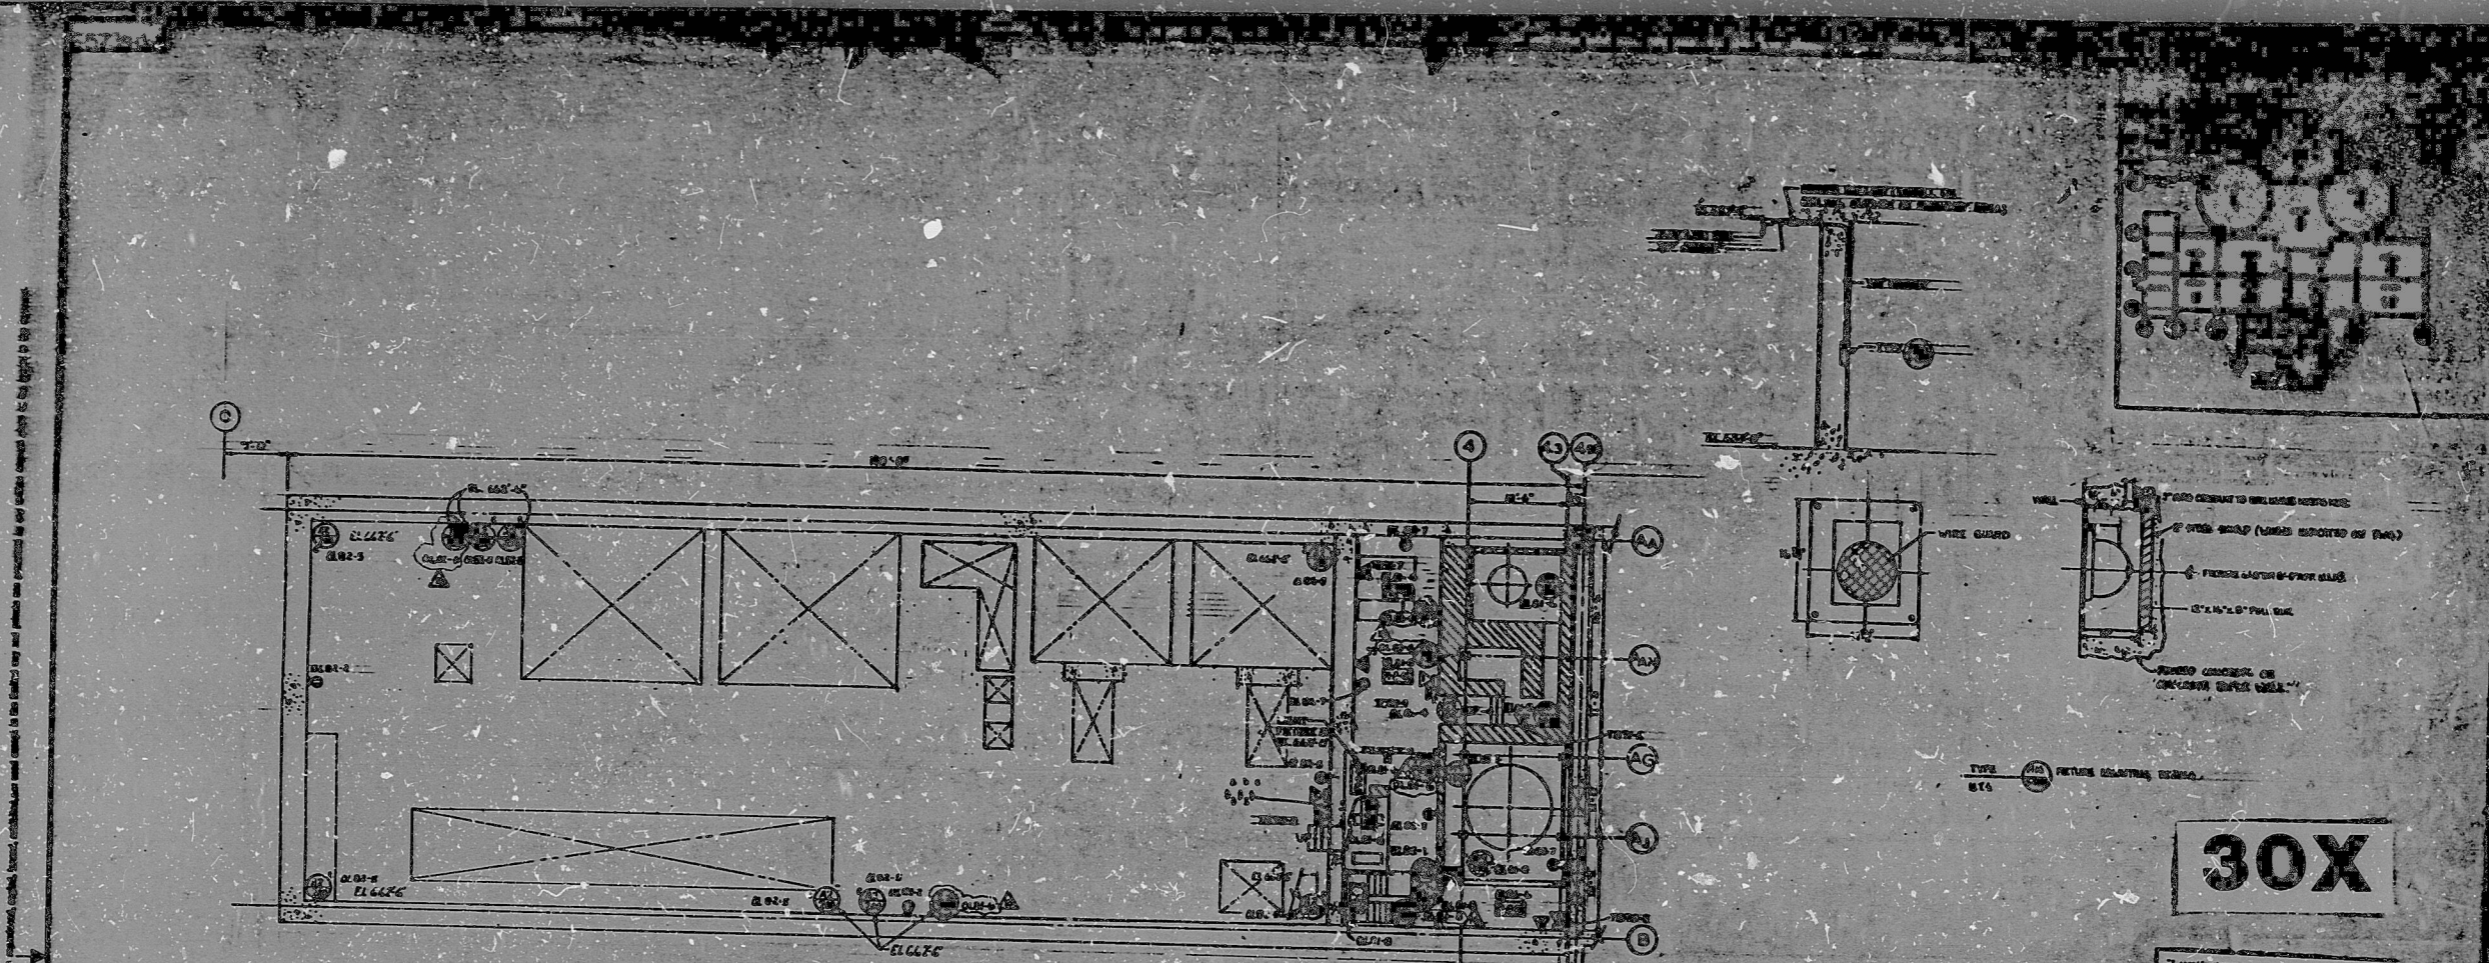

PLAN AT EL. 652'-0"

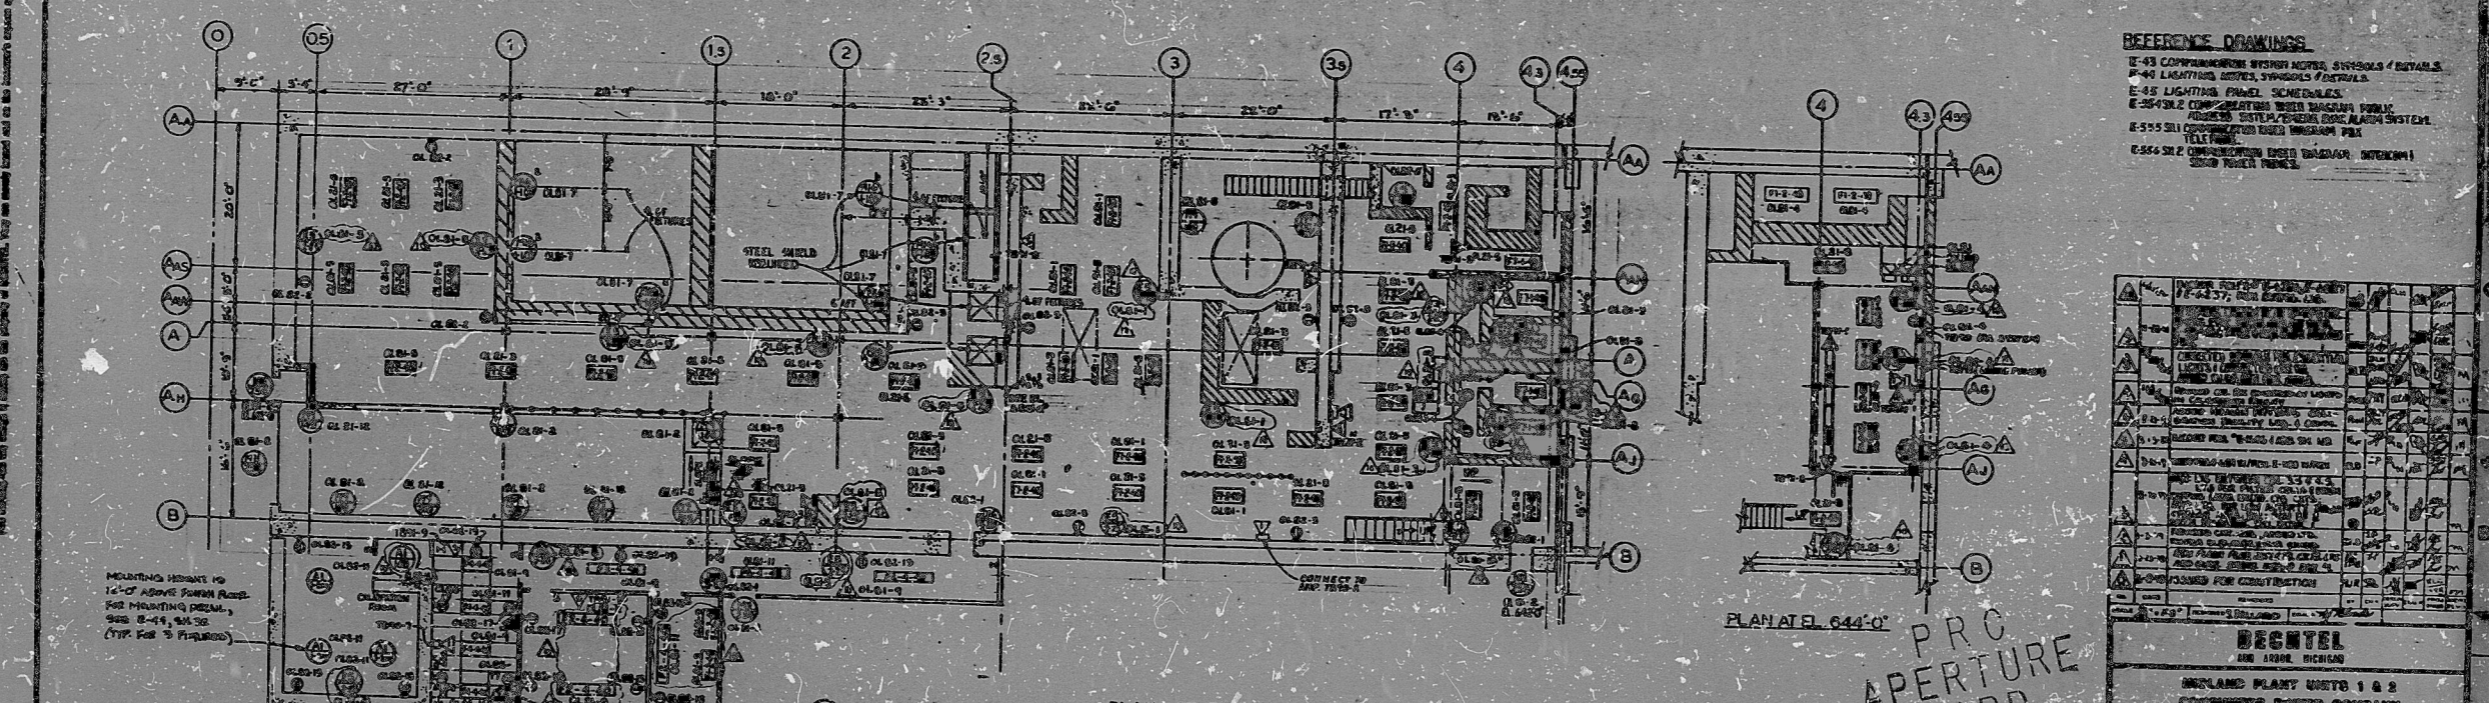

PLAN AT EL. 634'-6"

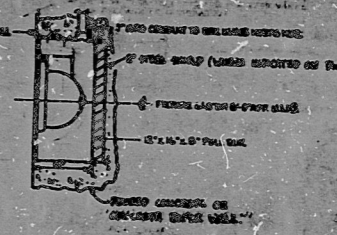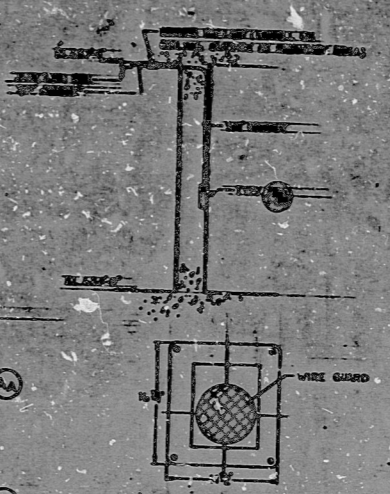



30X


- REFERENCE DRAWINGS
- E-43 COMMUNICATIONS WIRING NOTES, SYMBOLS & DETAILS
 - E-44 LIGHTING NOTES, SYMBOLS & DETAILS
 - E-45 LIGHTING PANEL SCHEDULES

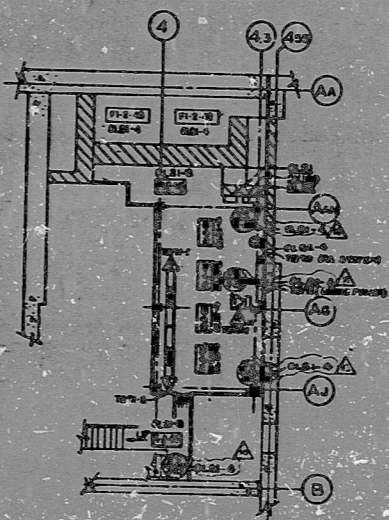

PLAN AT EL. 644'-0"

PRC APERTURE CARD


NO.	DESCRIPTION	DATE	BY
1	AS SHOWN		
2	REVISED		
3	REVISED		
BECHTEL
LIGHTING & COMMUNICATION
SOLID WASTE BLDG. & HEALTH PHYSICS
CALIBRATION FACILITY EL. 634'-6" & 652'-0"
DATE 10/20/54
E-573 SH10F1 10

11

11

8.5"

8.5"

11"

17"

RIDS

8302030583

