


E-575 SH.2 OF 4.

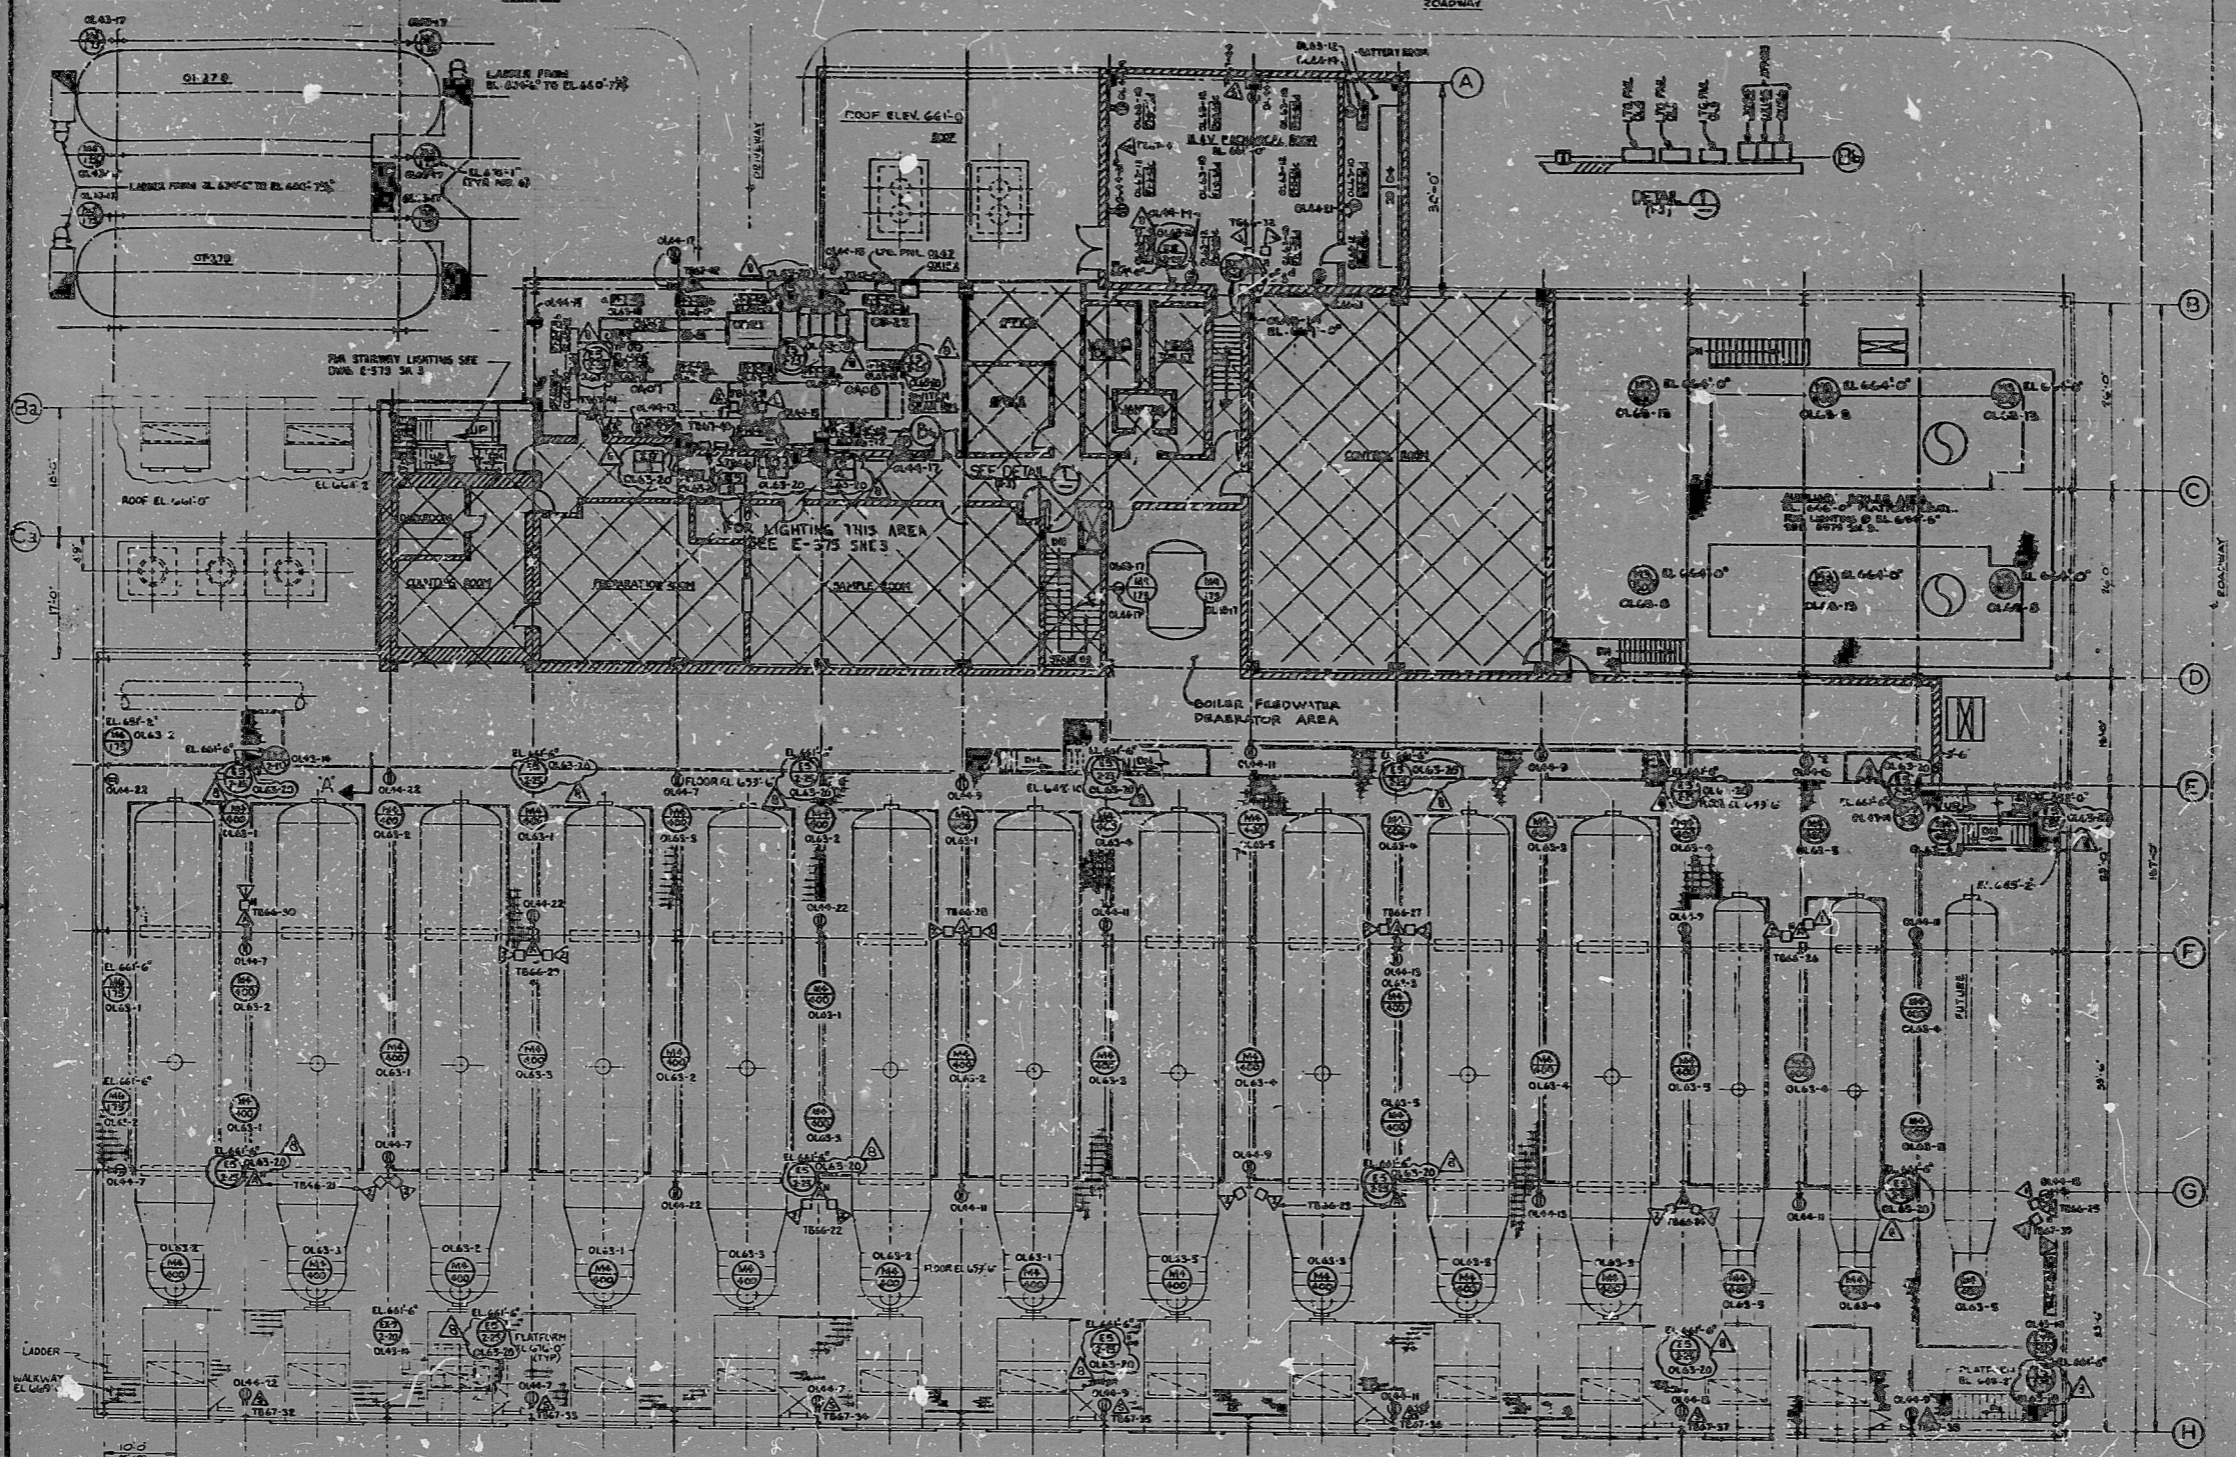

REFERENCE DRAWINGS

NOTES

REV.	DATE	DESCRIPTION
1		ISSUED FOR CONSTRUCTION
2		REVISION
3		REVISION
GENERAL
 AND AREA DESIGN
GENERAL
 AND AREA DESIGN
 CONSUMERS POWER COMPANY
 LIGHTING & COMMUNICATION
 EXHAUSTOR & AUX BOILER BLDG.
 EL. 603'-0"

DATE: 7/20/54
 DRAWING NO.: E-575 SH.2 OF 4
 SHEET NO.: 6

PRO
APPROV
CART

11

11

8.5'

8.5'

11'

17'

11

11

8.5'

0.5'

11'

17'

RIDS

8302030593

