




E-578 SH. 2 of 2

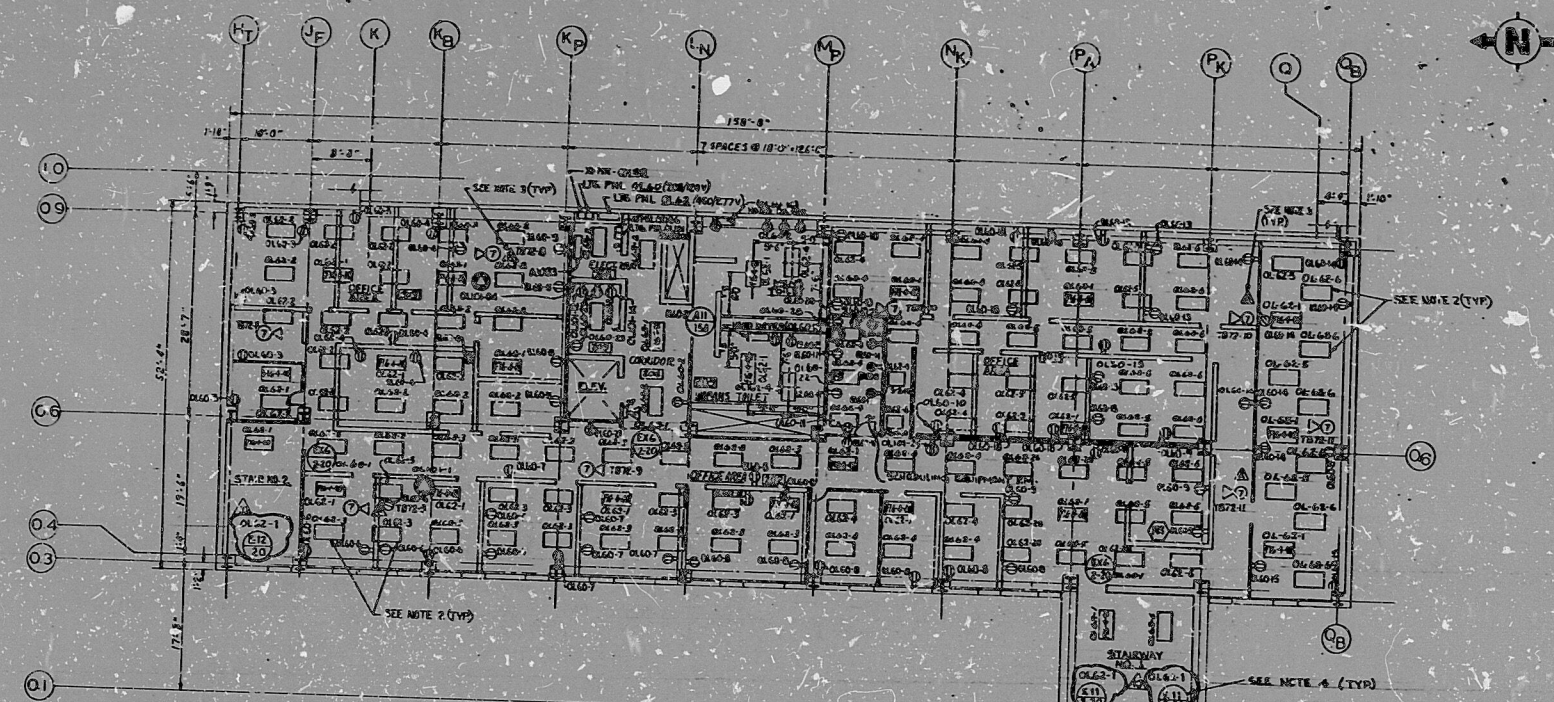

SECOND FLOOR PLAN ELEV. 648'-6"

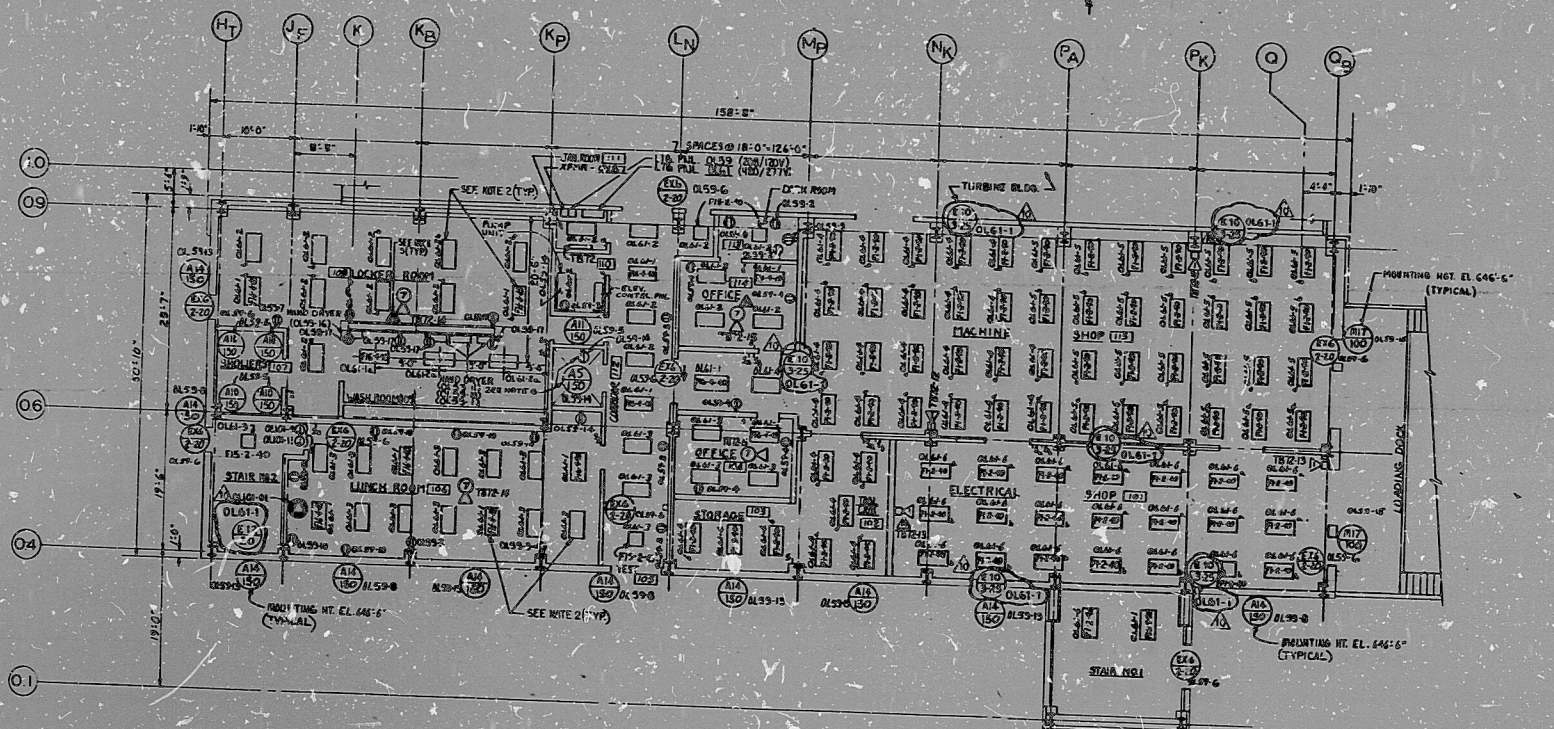

GROUND FLOOR PLAN ELEV. 634'-6"

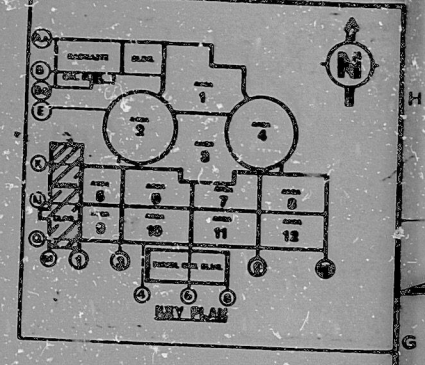

- REFERENCE DRAWINGS**
- E-48 COMMUNICATION SYSTEM NOTES, SYMBOLS & DETAILS
  - E-48 LIGHTING NOTES, SYMBOLS & DETAILS
  - E-48 LIGHTING PANEL SCHEDULES
  - E-554 SHEET 2 COMMUNICATIONS RISER DIAGRAM PA 1
  - E-554 SHEET 1 COMMUNICATIONS RISER DIAGRAM PSE
  - E-554 SHEET 1 COMMUNICATIONS RISER DIAGRAM PSE
  - E-570 SHEET 2 LIGHTING COMMUNICATION & GROUNDING ELEV. 634'-6" & 648'-6"

- NOTES**
- FOR EXACT LOCATIONS OF LIGHTING FIXTURES REFER TO ARCHITECTURAL REFLECTED CEILING PLAN DWG. 0A-83 & A-86
  - ALL FIXTURES SHOWN ARE TO BE TYPE F14-0-80 UNLESS INDICATED OTHERWISE
  - ALL COMMUNICATION AMPLIFIERS LOCATED IN RECESSED CEILING AREAS ARE TO BE MOUNTED ABOVE CEILING
  - EMERGENCY LIGHTS IN STAIRS TO BE MOUNTED ABOVE FINISHED FLOOR AT EACH INTERMEDIATE LANDING
  - FOR RECEPTACLES IN ROOMS 101, 102 & 115 SEE DWG. E-580 SH. 1 OF 1
  - LIGHT & RECEPTACLE TO BE MOUNTED IN ELEV. PT.

30X


PRO APERTURE CARD

NO. 10  
RWS # E-121618 E-701098

1A-15	INCORPORATE E-578 E-1228 E-1229, ADD NOTE 6				
**BECHTEL**  

**MIDLAND PLANT UNITS 1 & 2**  
**CONSUMERS POWER COMPANY**  
LIGHTING & COMMUNICATION  
OFFICE & SERVICE BLDG.  
ELEV. 634'-6" & 648'-6"

DATE: 4.9.86  
DRAWING NO.: 7220  
SHEET: E-578 SH. 2 OF 2  
SCALE: 1/8" = 1'-0"



RIDS

8302040059

