
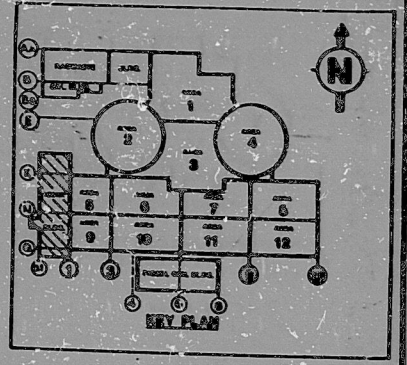


E-579 SH. 2 OF 2

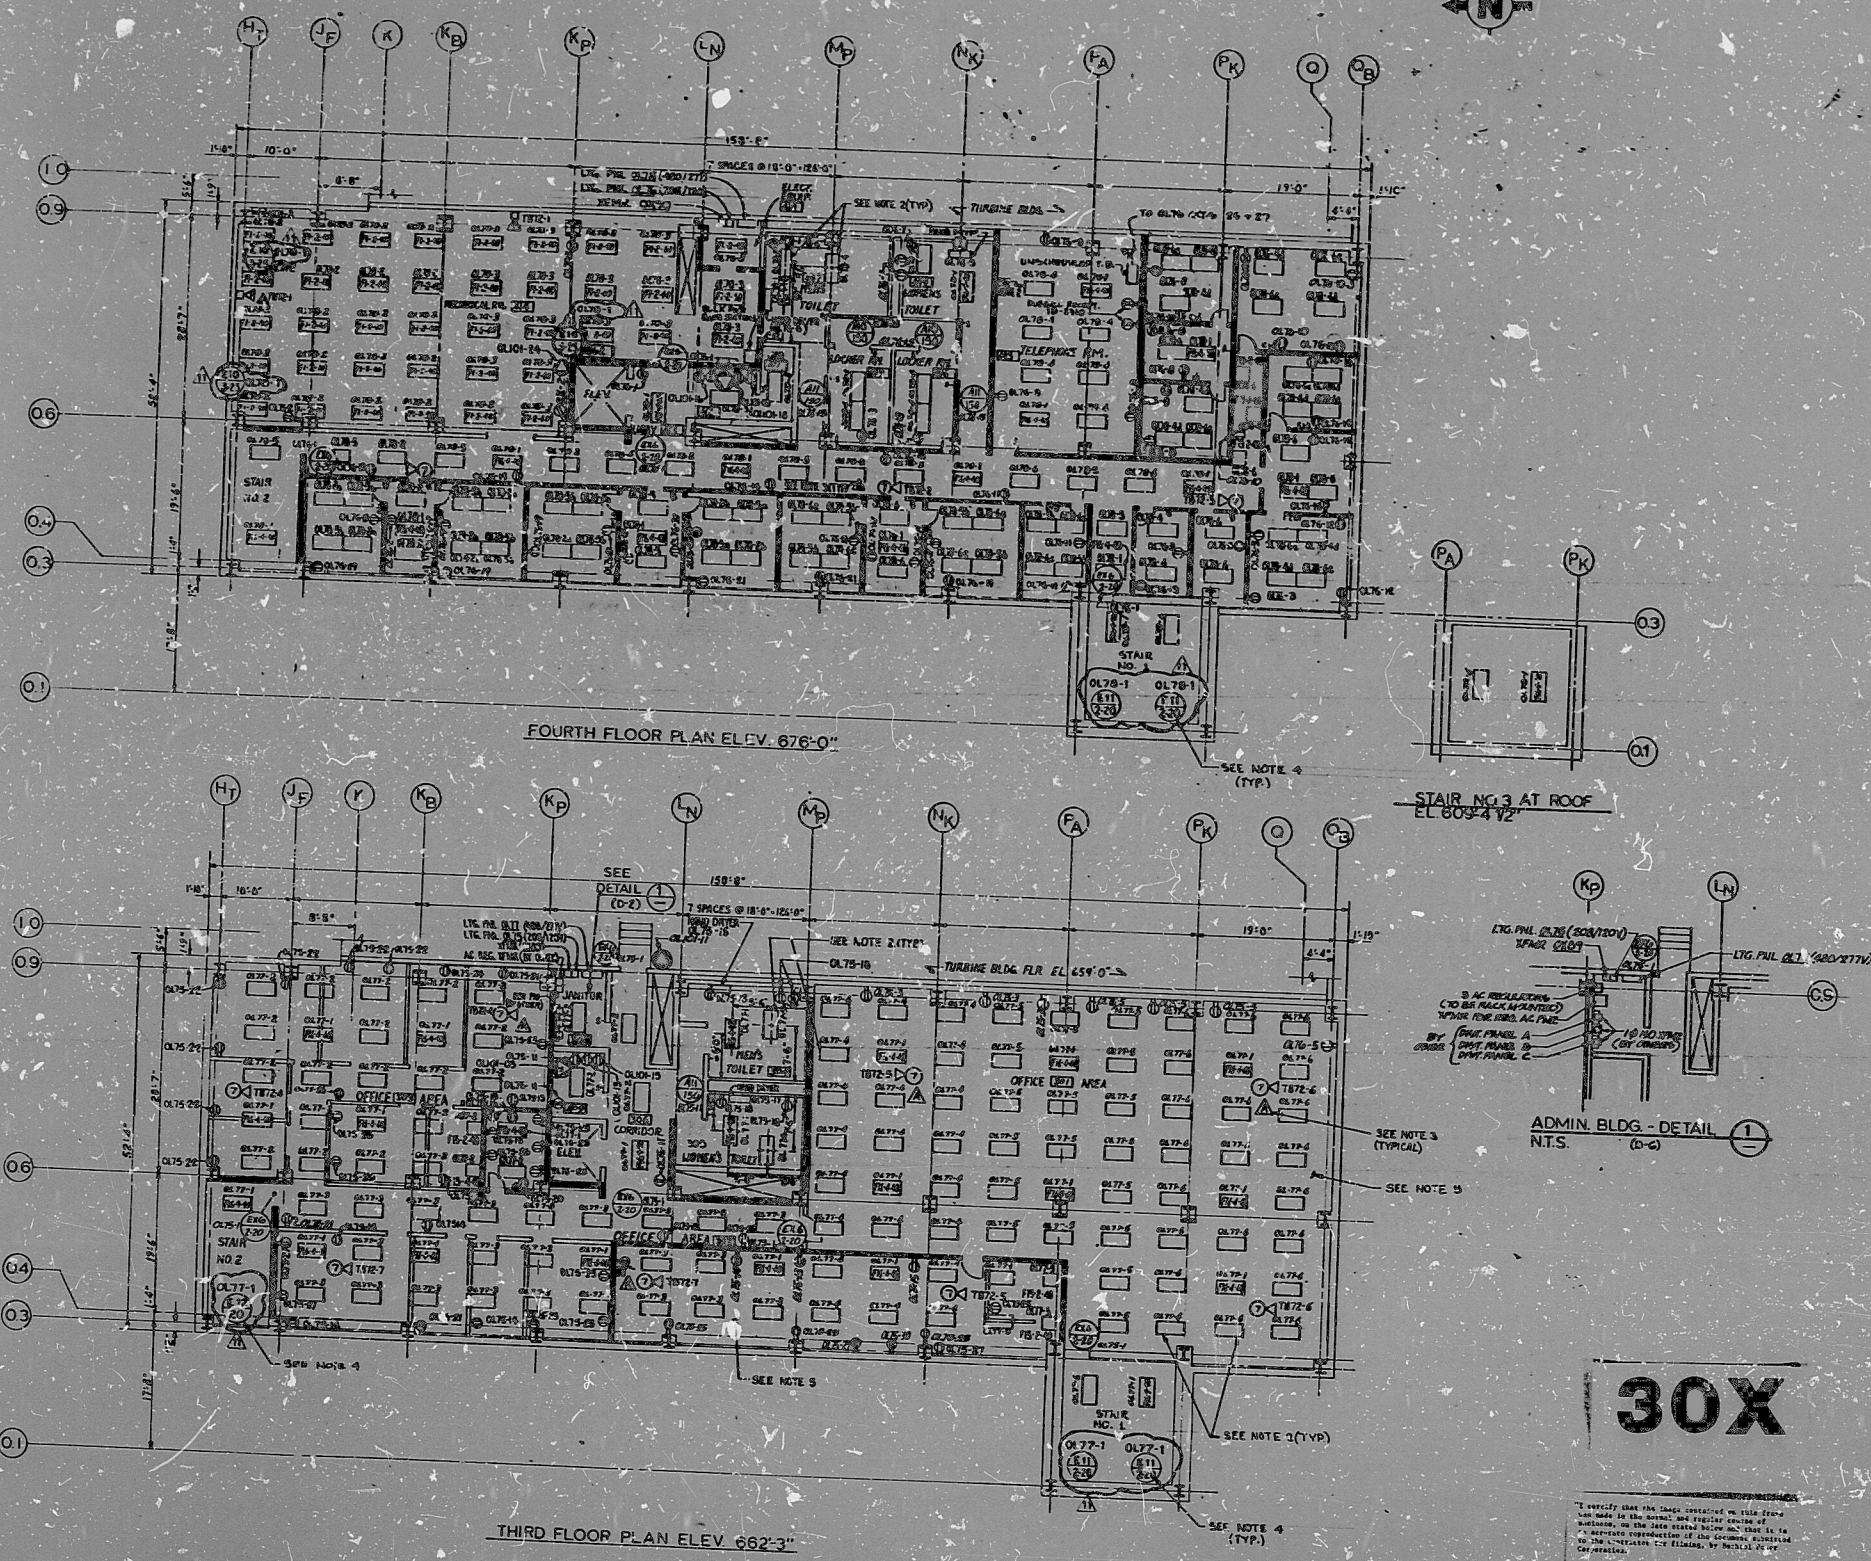

- REFERENCE DRAWINGS**
- E-45 COMMUNICATION SYSTEM NOISE, SYMBOLS & DETAILS
 - E-44 LIGHTING NOTES, SYMBOLS & DETAILS
 - E-43 LIGHTING PANEL SCHEDULES
 - E-579 SH. 1 COMMUNICATION RING DIAGRAM - ALL EMERGENCY EQUIPMENT RINGS SYSTEM
 - E-579 SH. 1 COMMUNICATION RING DIAGRAM - PBX TELEPHONE SYSTEM
 - E-579 SH. 1 COMMUNICATION RING DIAGRAM - INTERCOM & SOUND TRANSMISSION SYSTEM

- NOTES**
- FOR EXACT LOCATIONS OF LIGHTING FIXTURES, REFER TO ARCH. REFLECTED CEILING PLAN DWG. NO. 82-08 & A-D
 - ALL FIXTURES SHOWN ARE TO BE THROUGH-GLASS UNLESS INDICATED OTHERWISE
 - ALL COMMUNICATION APPLIANCES LOCATED IN DESIGNATED CEILING AREAS ARE TO BE FLUSH MOUNTED
 - EMERGENCY LIGHTS IN STAIRS TO BE MOUNTED 7'-6" ABOVE FINISH FLOOR AT EACH INTERMEDIATE LANDING
 - FOR DIMENSIONS, ARRANGEMENT & SPECIFICATIONS, REFER TO DWG. E-579 - C-1

NO.	REVISION	DATE	BY	CHKD.	APP'D.
NECHTEL
AND ASSOC. ENGINEERS


CONSUMERS POWER COMPANY

LIGHTING, COMMUNICATION & GROUNDING
OFFICE & SERVICE BLDG.

NO. DATE BY CHKD. APP'D.

7820 E-579 SH. 2 OF 2 11

RIDS

8302040062

