



E-585 SH.1 OF 1

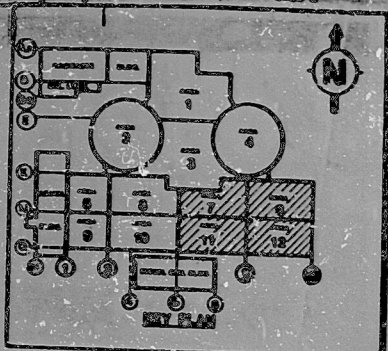



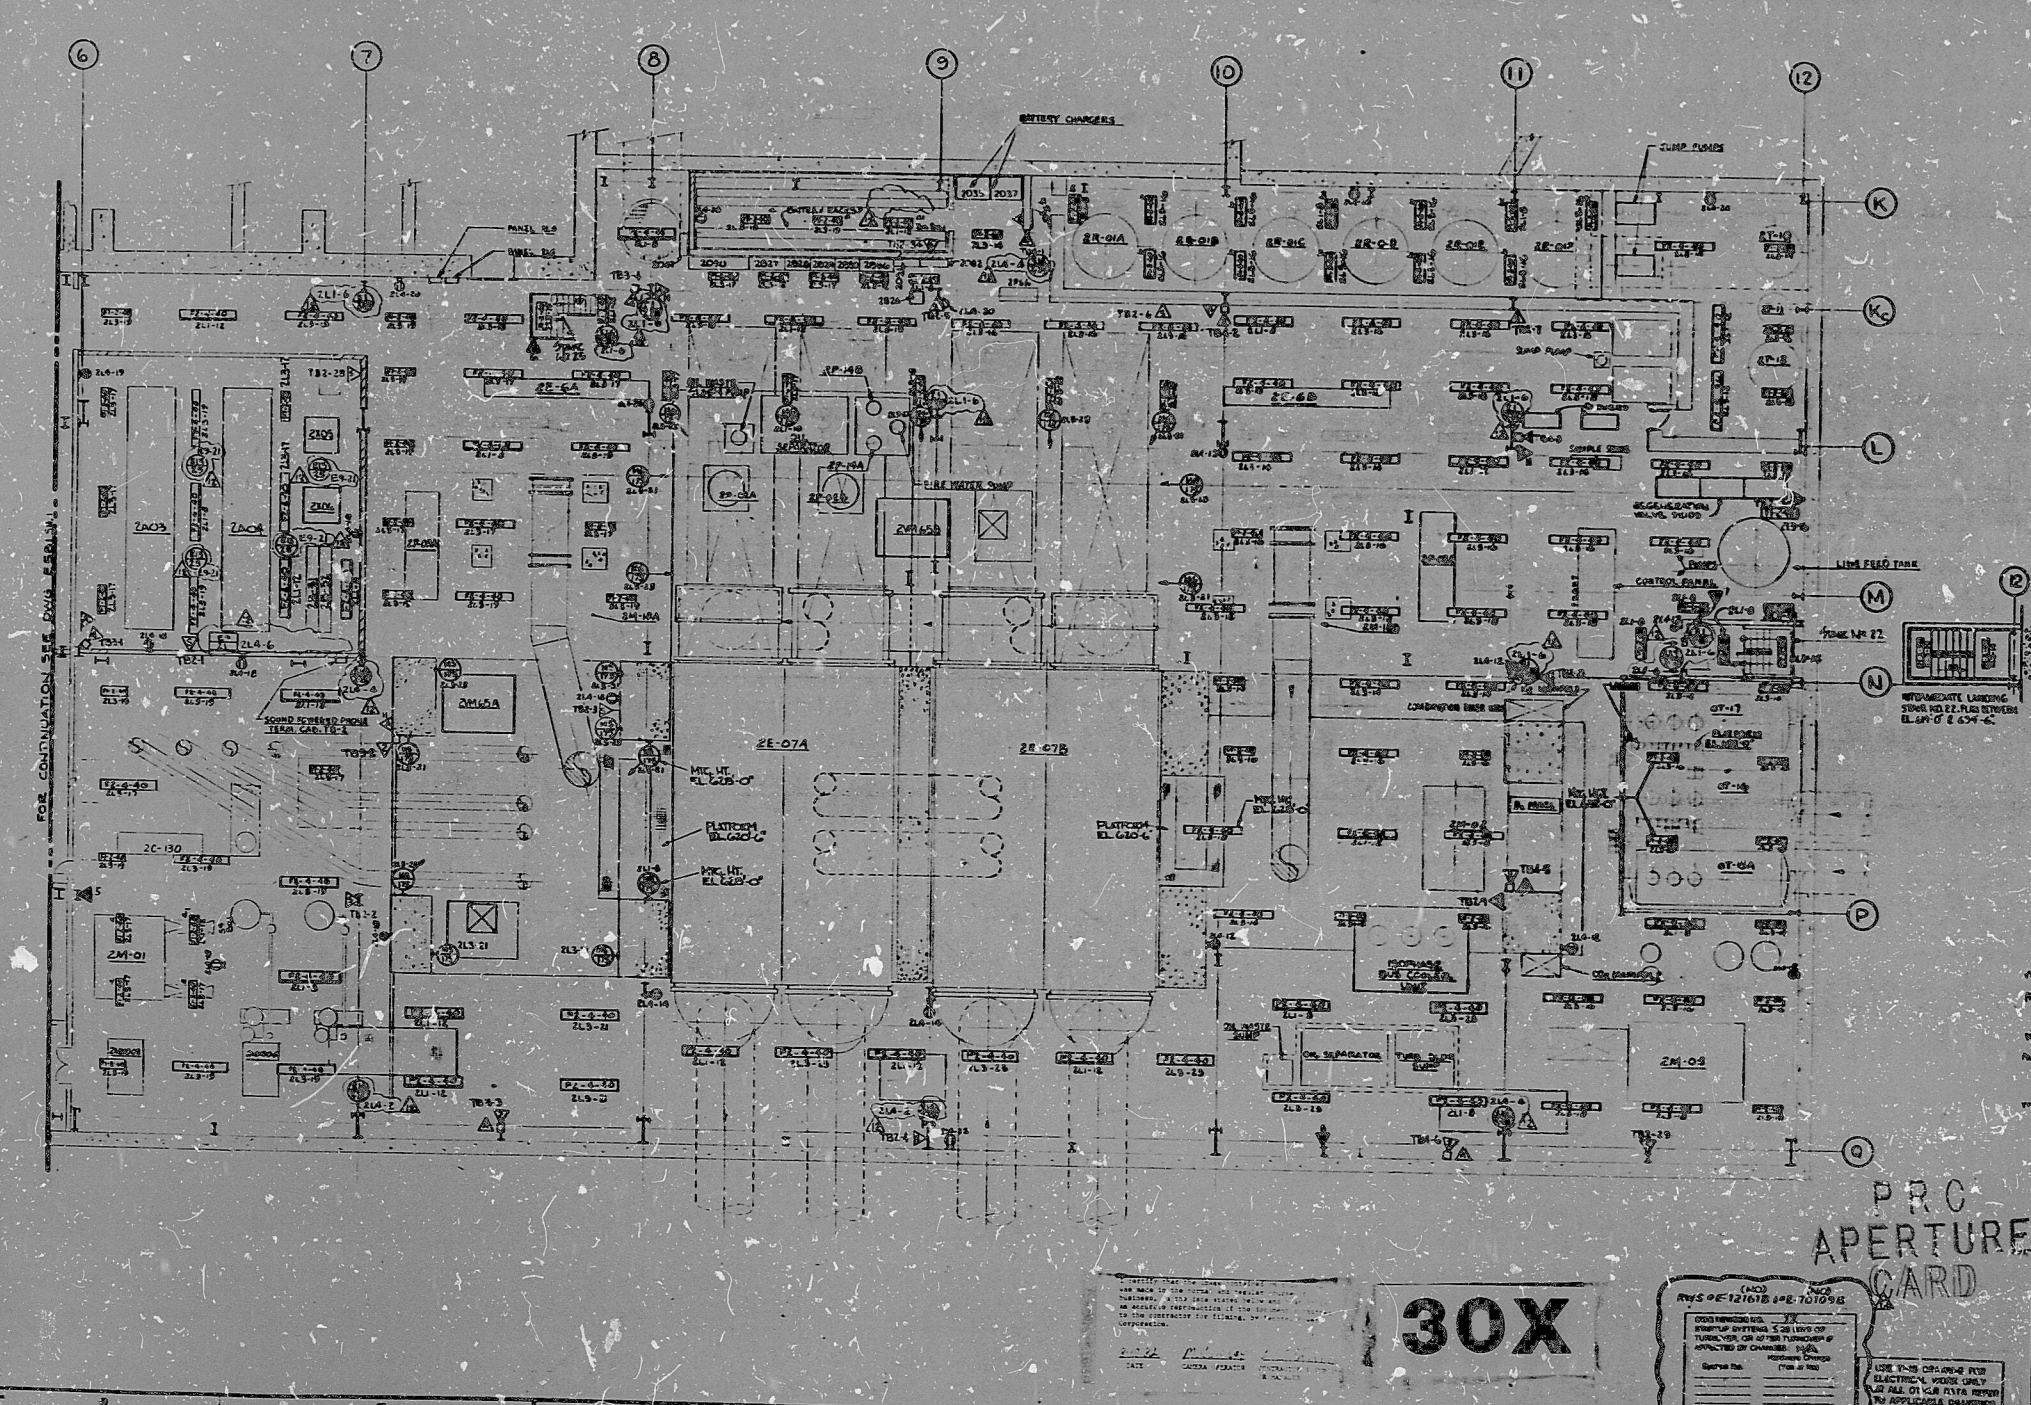

REFERENCE DRAWINGS
 E-43 COMMUNICATION SYSTEMS NOTES, SYMBOLS AND DETAILS
 E-44 LIGHTING NOTES, SYMBOLS AND DETAILS
 E-45 LIGHTING PANEL SCHEDULES
 E-5501 CONCRETE-TIE REBAR DRAINAGE, RISERS, AND EMERGENCY EVACUATION ALARMS SYSTEMS
 E-5502 CALL CORRELATION, BELL SIGNALS, POS TELEPHONES
 E-5503 CALL CORRELATION, BELL SIGNALS, INTERCOM AND SOUND POWERED PHONE

NO.	REV.	DESCRIPTION	DATE
1		REV EMERGENCY LIGHTING	
2		REV EMERGENCY LIGHTING	
 LIGHTING AND COMMUNICATION
 TURBINE BUILDING UNIT 2
 ELEVATION 6IN-C
 7220 E-585 SH.1 OF 1 12

RIDS

8302040072

