
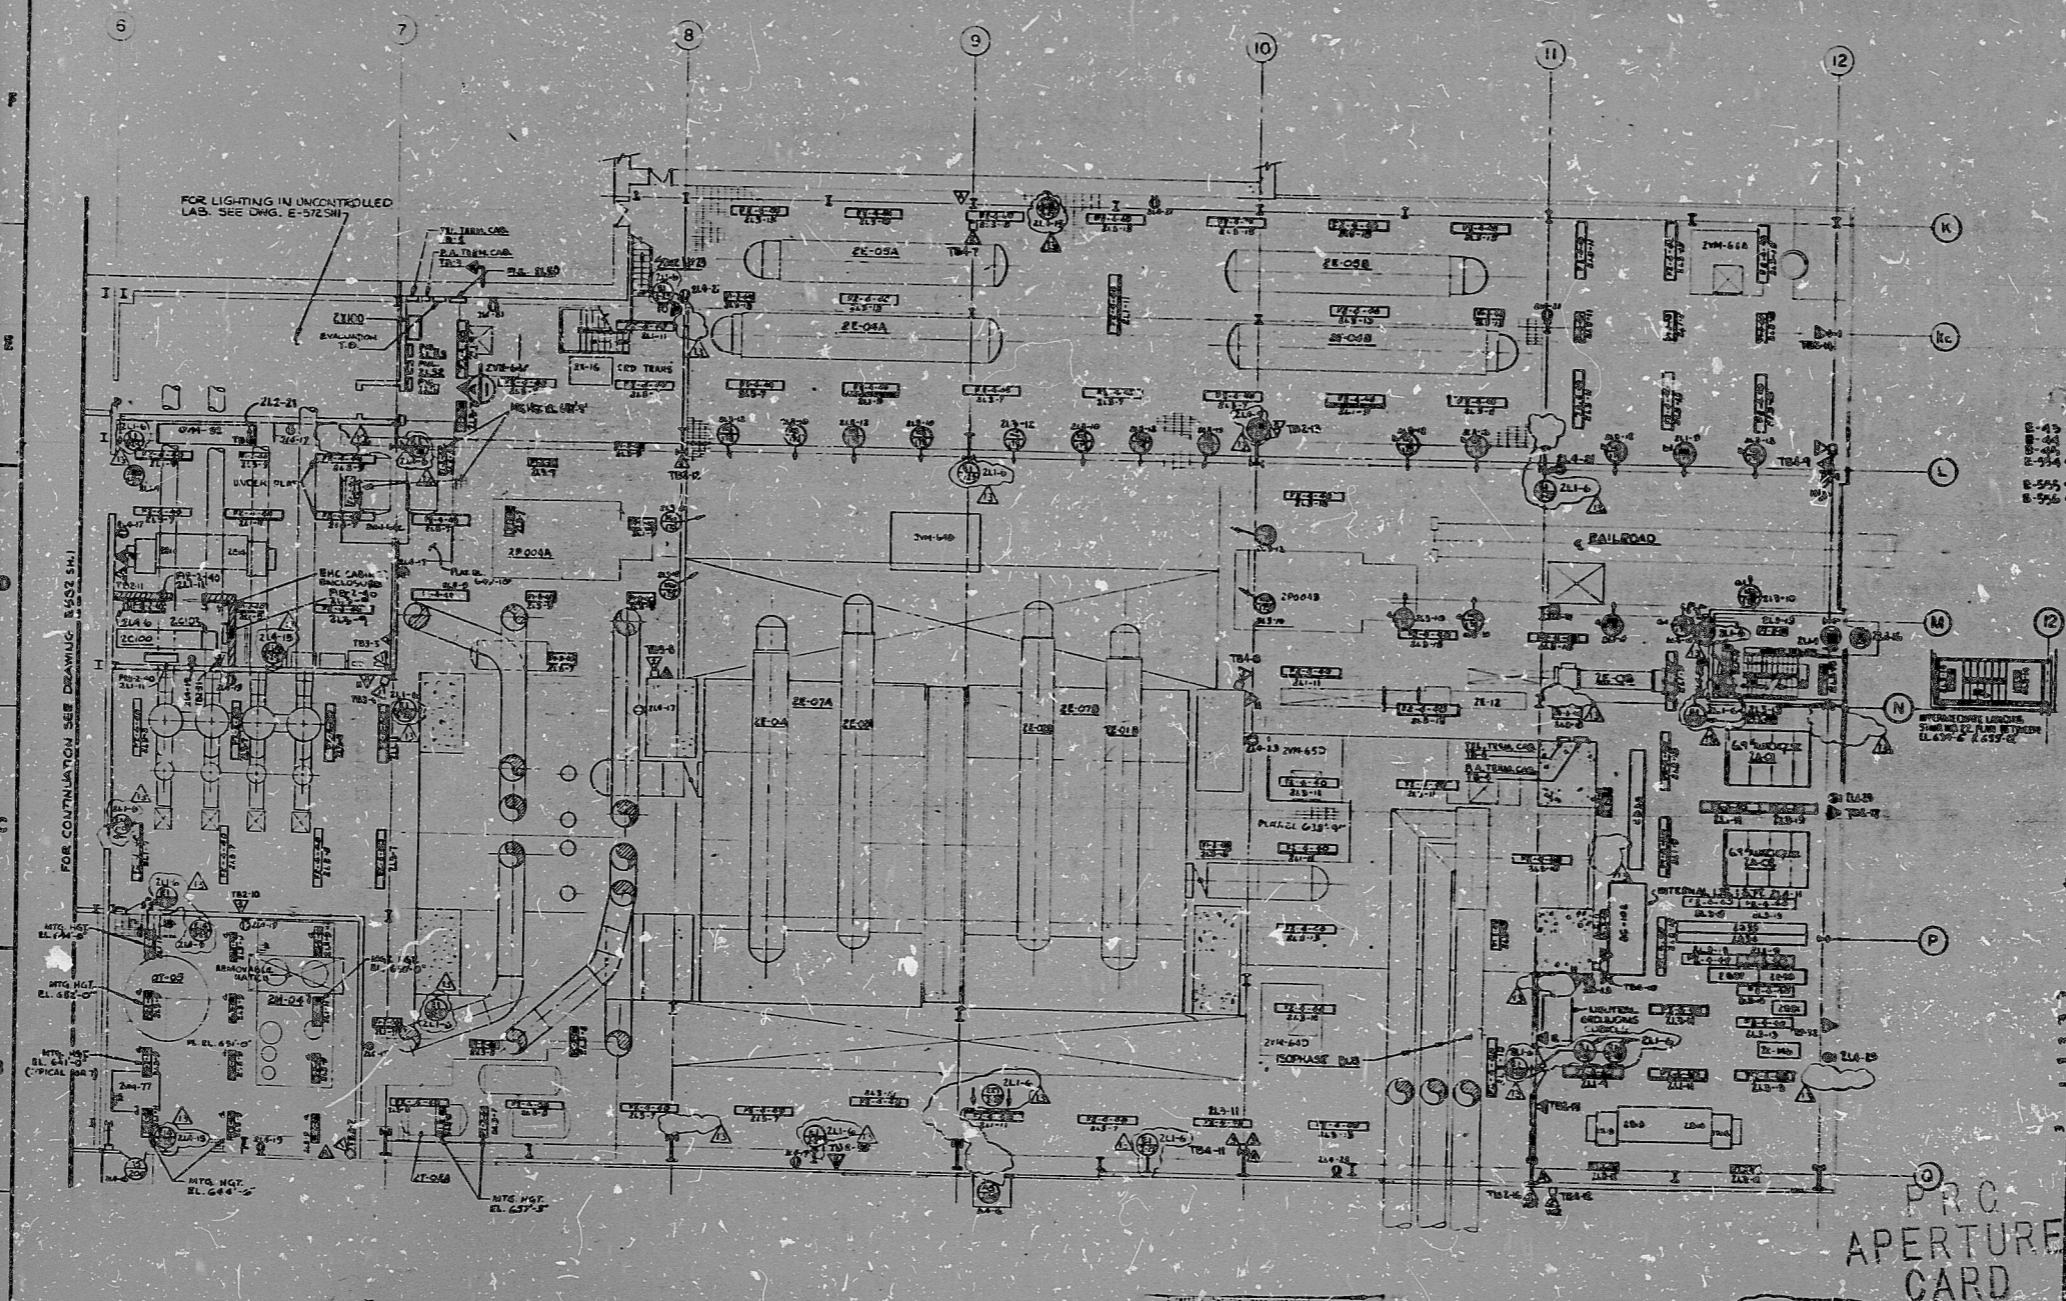
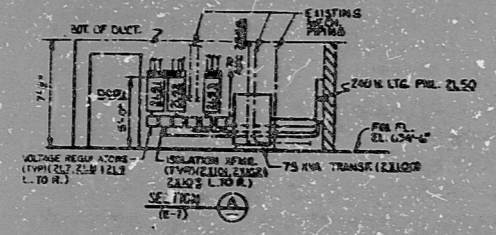


E-586 SH.10F1

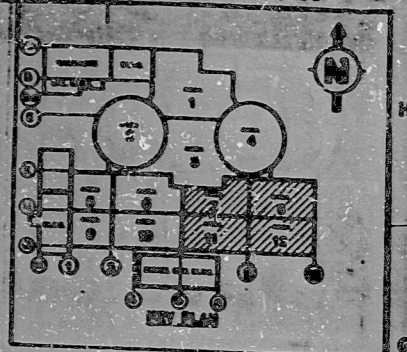

- REFERENCE DRAWINGS**
- E-43 COMMUNICATIONS SHEET NOTS, SYMBOLS AND LEGEND
 - E-44 LIGHTING NOTES, SYMBOLS AND LEGEND
 - E-45 LIGHTING PANEL, SYMBOLS AND LEGEND

| NO. | REV. | DESCRIPTION | DATE | BY | CHKD. |
|-----|------|-----------------------------|------|----|-------|
| 1 | | REV. EMERGENCY LIGHTING | | | |
| 2 | | REVISIONS TO E-586 SH.10F1 | | | |
| 3 | | ADDED SHEETS FOR REV. DUCTS | | | |
| 4 | | ADDED SHEETS FOR REV. DUCTS | | | |
PRO APERTURE CARD

30X

BEENTEL
 MIDLAND PLANT UNITS 1 & 2
 CONSUMERS POWER COMPANY
 LIGHTING AND COMMUNICATION
 TURBINE BUILDING UNIT 2
 ELEVATION 634'-6"

726 E-586 SH.10F1/13



RIDS

8302040081

