




17"  
11"  
8.5"  
11"  
8.5"  
17"


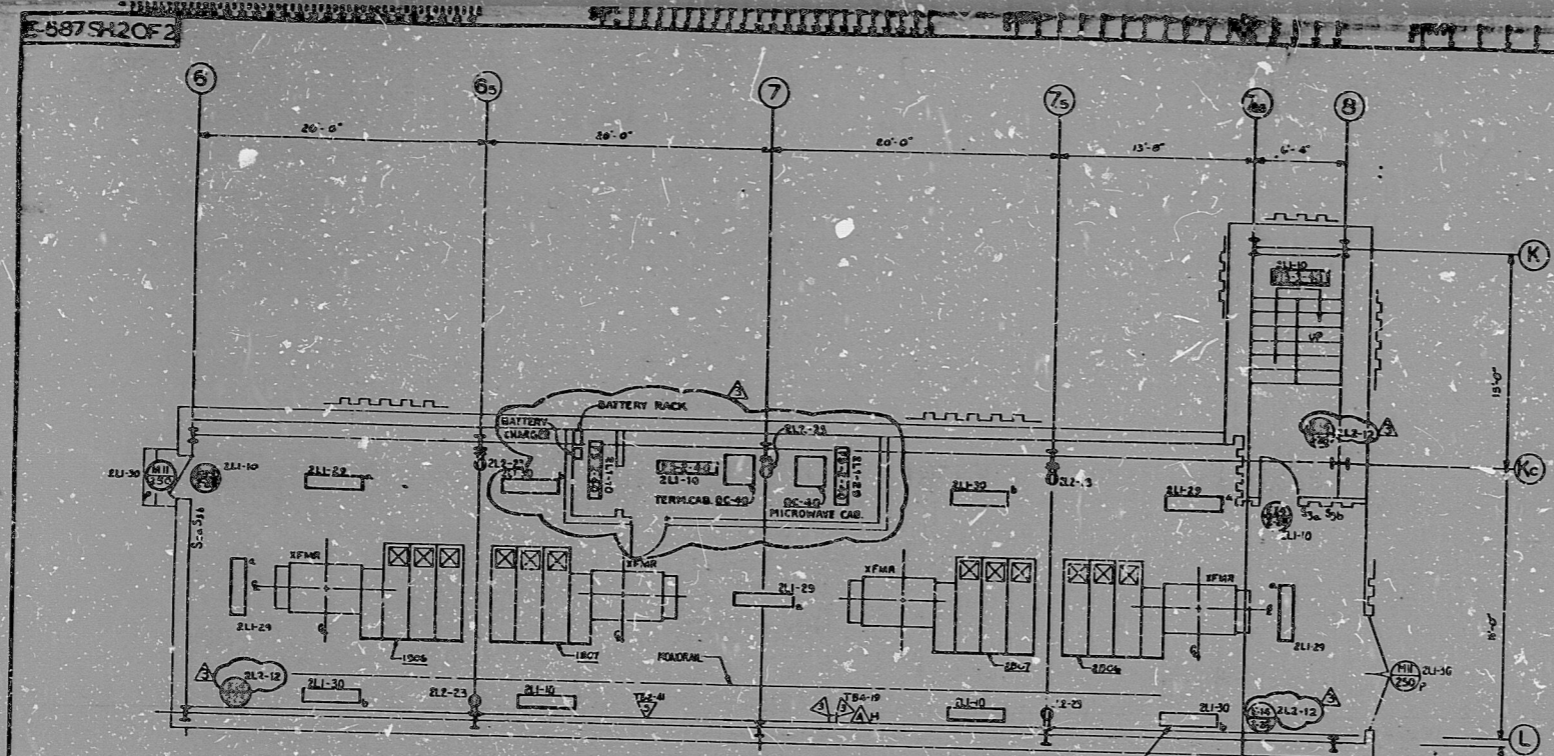

LIGHTING & COMMUNICATIONS PLAN FL. EL 715-7  
SCALE: (N.T.S.)

FIG. 3-40 (TYPE FOR B FIXTURES)  
MOUNTING HEIGHT IS 10'-0" ABOVE  
FINISH FLOOR. FOR MOUNTING LEVEL  
SEE E-44, 34, 46.

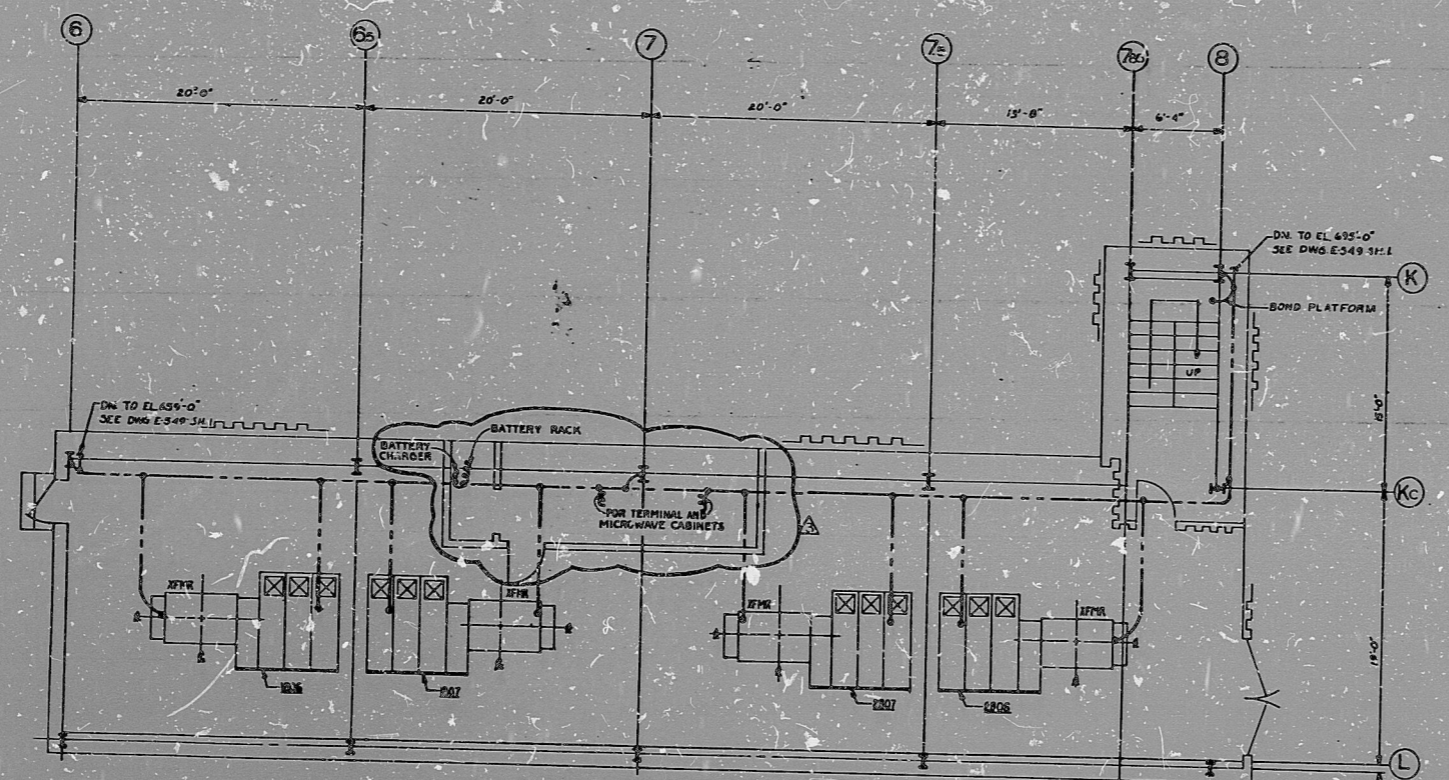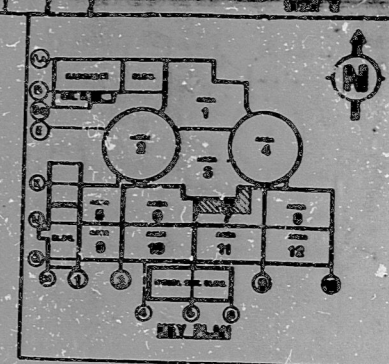

GROUNDING LAYOUT FL. EL 715-7  
SCALE: 1/4"=1'-0"

- REFERENCE DRAWINGS
- E-41 COMMUNICATIONS NOTES, SYMBOLS, AND DETAILS
  - E-42 COMMUNICATIONS NOTES, SYMBOLS, AND DETAILS
  - E-43 LIGHTING NOTES, SYMBOLS, AND DETAILS
  - E-44 LIGHTING POWER SCHEDULE



DATE: 03/15/72  
DESIGNER: [Signature]  
CHECKED BY: [Signature]  
DATE: 03/15/72

**30X**

PRO APERTURE CARD

IND. 1110  
RMS 2-121818-1 E-70162B

DATE: 03/15/72  
BY: [Signature]


BECHTEL  
ANN ARBOR, MICHIGAN

MOLAND PLANT UNITS 1 & 2  
CONSUMERS POWER COMPANY

LIGHTING, COMMUNICATIONS & GROUNDING  
TURBINE BUILDING UNIT 2  
EL. 715-7 & EXISTING ROOF

7220 E-587S12OF2 3

RIDS

8302040085

