


LIGHTING PLAN-FLOOR ELEV. 637'-0"

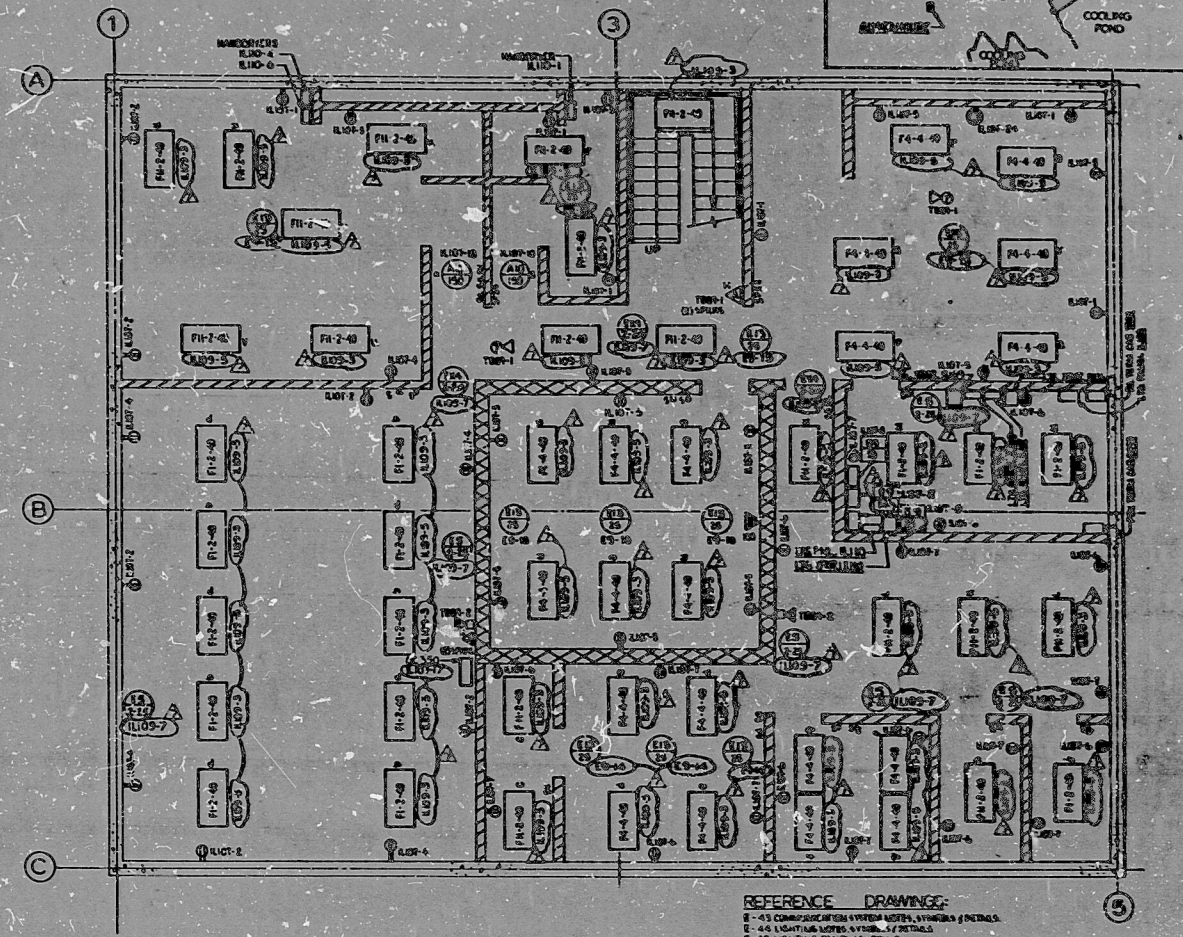

LIGHTING PLAN-BASEMENT ELEV. 624'-6"

REFERENCE DRAWINGS:
NOTES:
 1. SYMBOLS INDICATED FIELD TO BE PLACED FLOOR FINISH FLOOR FINISH RECEPTORS AT 637'-0" ELEV.



30X

PRC
 APERTURE
 CARD

LIGHTING & COMMUNICATIONS GUARDHOUSE		
NO.	REVISION	DATE
7227	E590 SH10F1	7

RIDS

8302040089

