
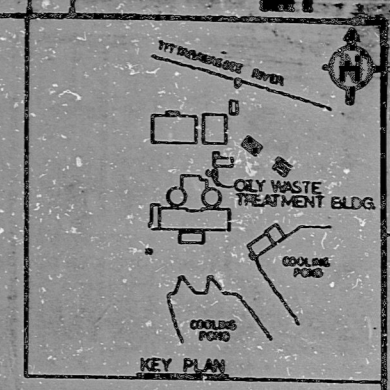


E-592 SH 10F1

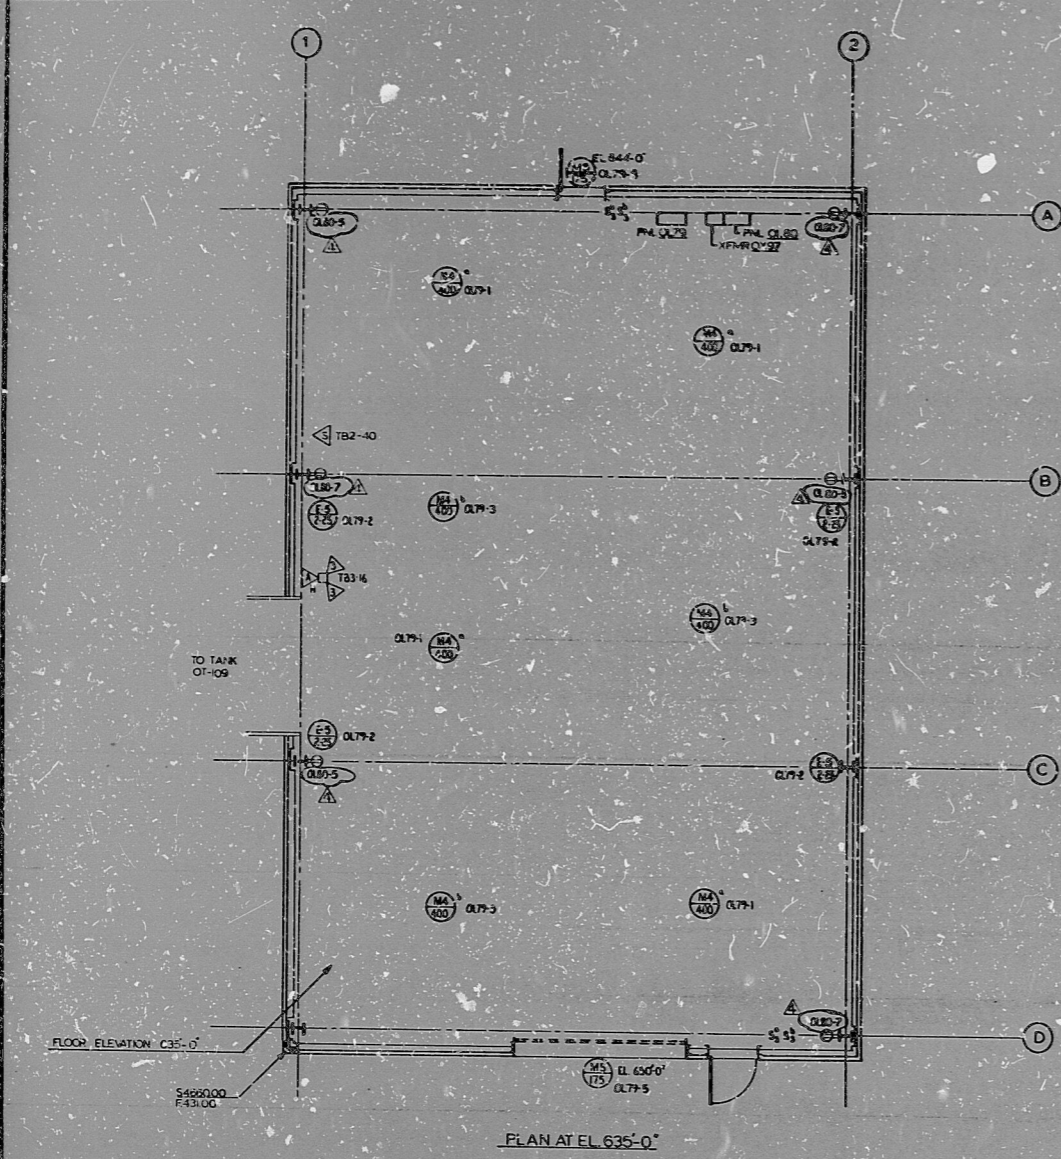

- REFERENCE DWGS.**
- E-43 COMMUNICATION SYSTEM NOTES, SYMBOLS & DETAILS
  - E-44 LIGHTING NOTES, SYMBOLS & DETAILS
  - E-45 LIGHTING PANEL SCHEDULE
  - E-501 SH 2 LIGHTING REFER DIAGRAM
  - E-504 SH 2 COMMUNICATION REFER DIAGRAM PUBLIC ADDRESS / EMERGENCY EVAC ALARM SYSTEM
  - E-555 SH 2 COMMUNICATION REFER DIAGRAM INTERCOM & STUN POWERED PHONES

**NOTES**

1. UNLESS OTHERWISE NOTED ALL NEW AND EXISTING FEATURES SHALL BE AS SHOWN.

DESIGNED BY: *[Signature]*  
 CHECKED BY: *[Signature]*  
 DATE: 11/11/77

**30X**

PRC  
 APERTURE  
 CARD

PWS # E-70150 B (10)


USE THIS DRAWING FOR ELECTRICAL WORK ONLY FOR ALL OTHER DATA REFER TO APPLICABLE DRAWINGS

REV	DATE	DESCRIPTION
1	11/11/77	REVISED EMERGENCY LIGHTING
2	11/11/77	REVISION FOR CONSTRUCTION

**RECEIVED**  
 AND APPROVED

MIDLAND PLANT UNITS 1 & 2  
 COMMERCIAL POWER COMPANY

LIGHTING AND COMMUNICATION  
 OILY WASTE TREATMENT BUILDING

JOB NO.	DRAWING NO.	REV.
7220	E-592 SH.10F1	4



RIDS

8302040094

