
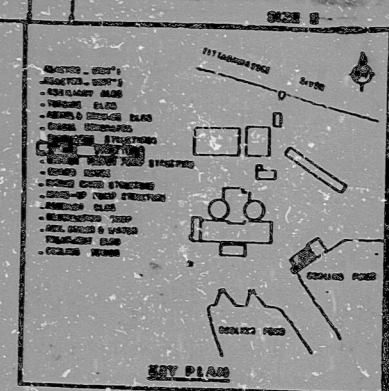


17"
11"
8.5"
11"
8.5"
17"

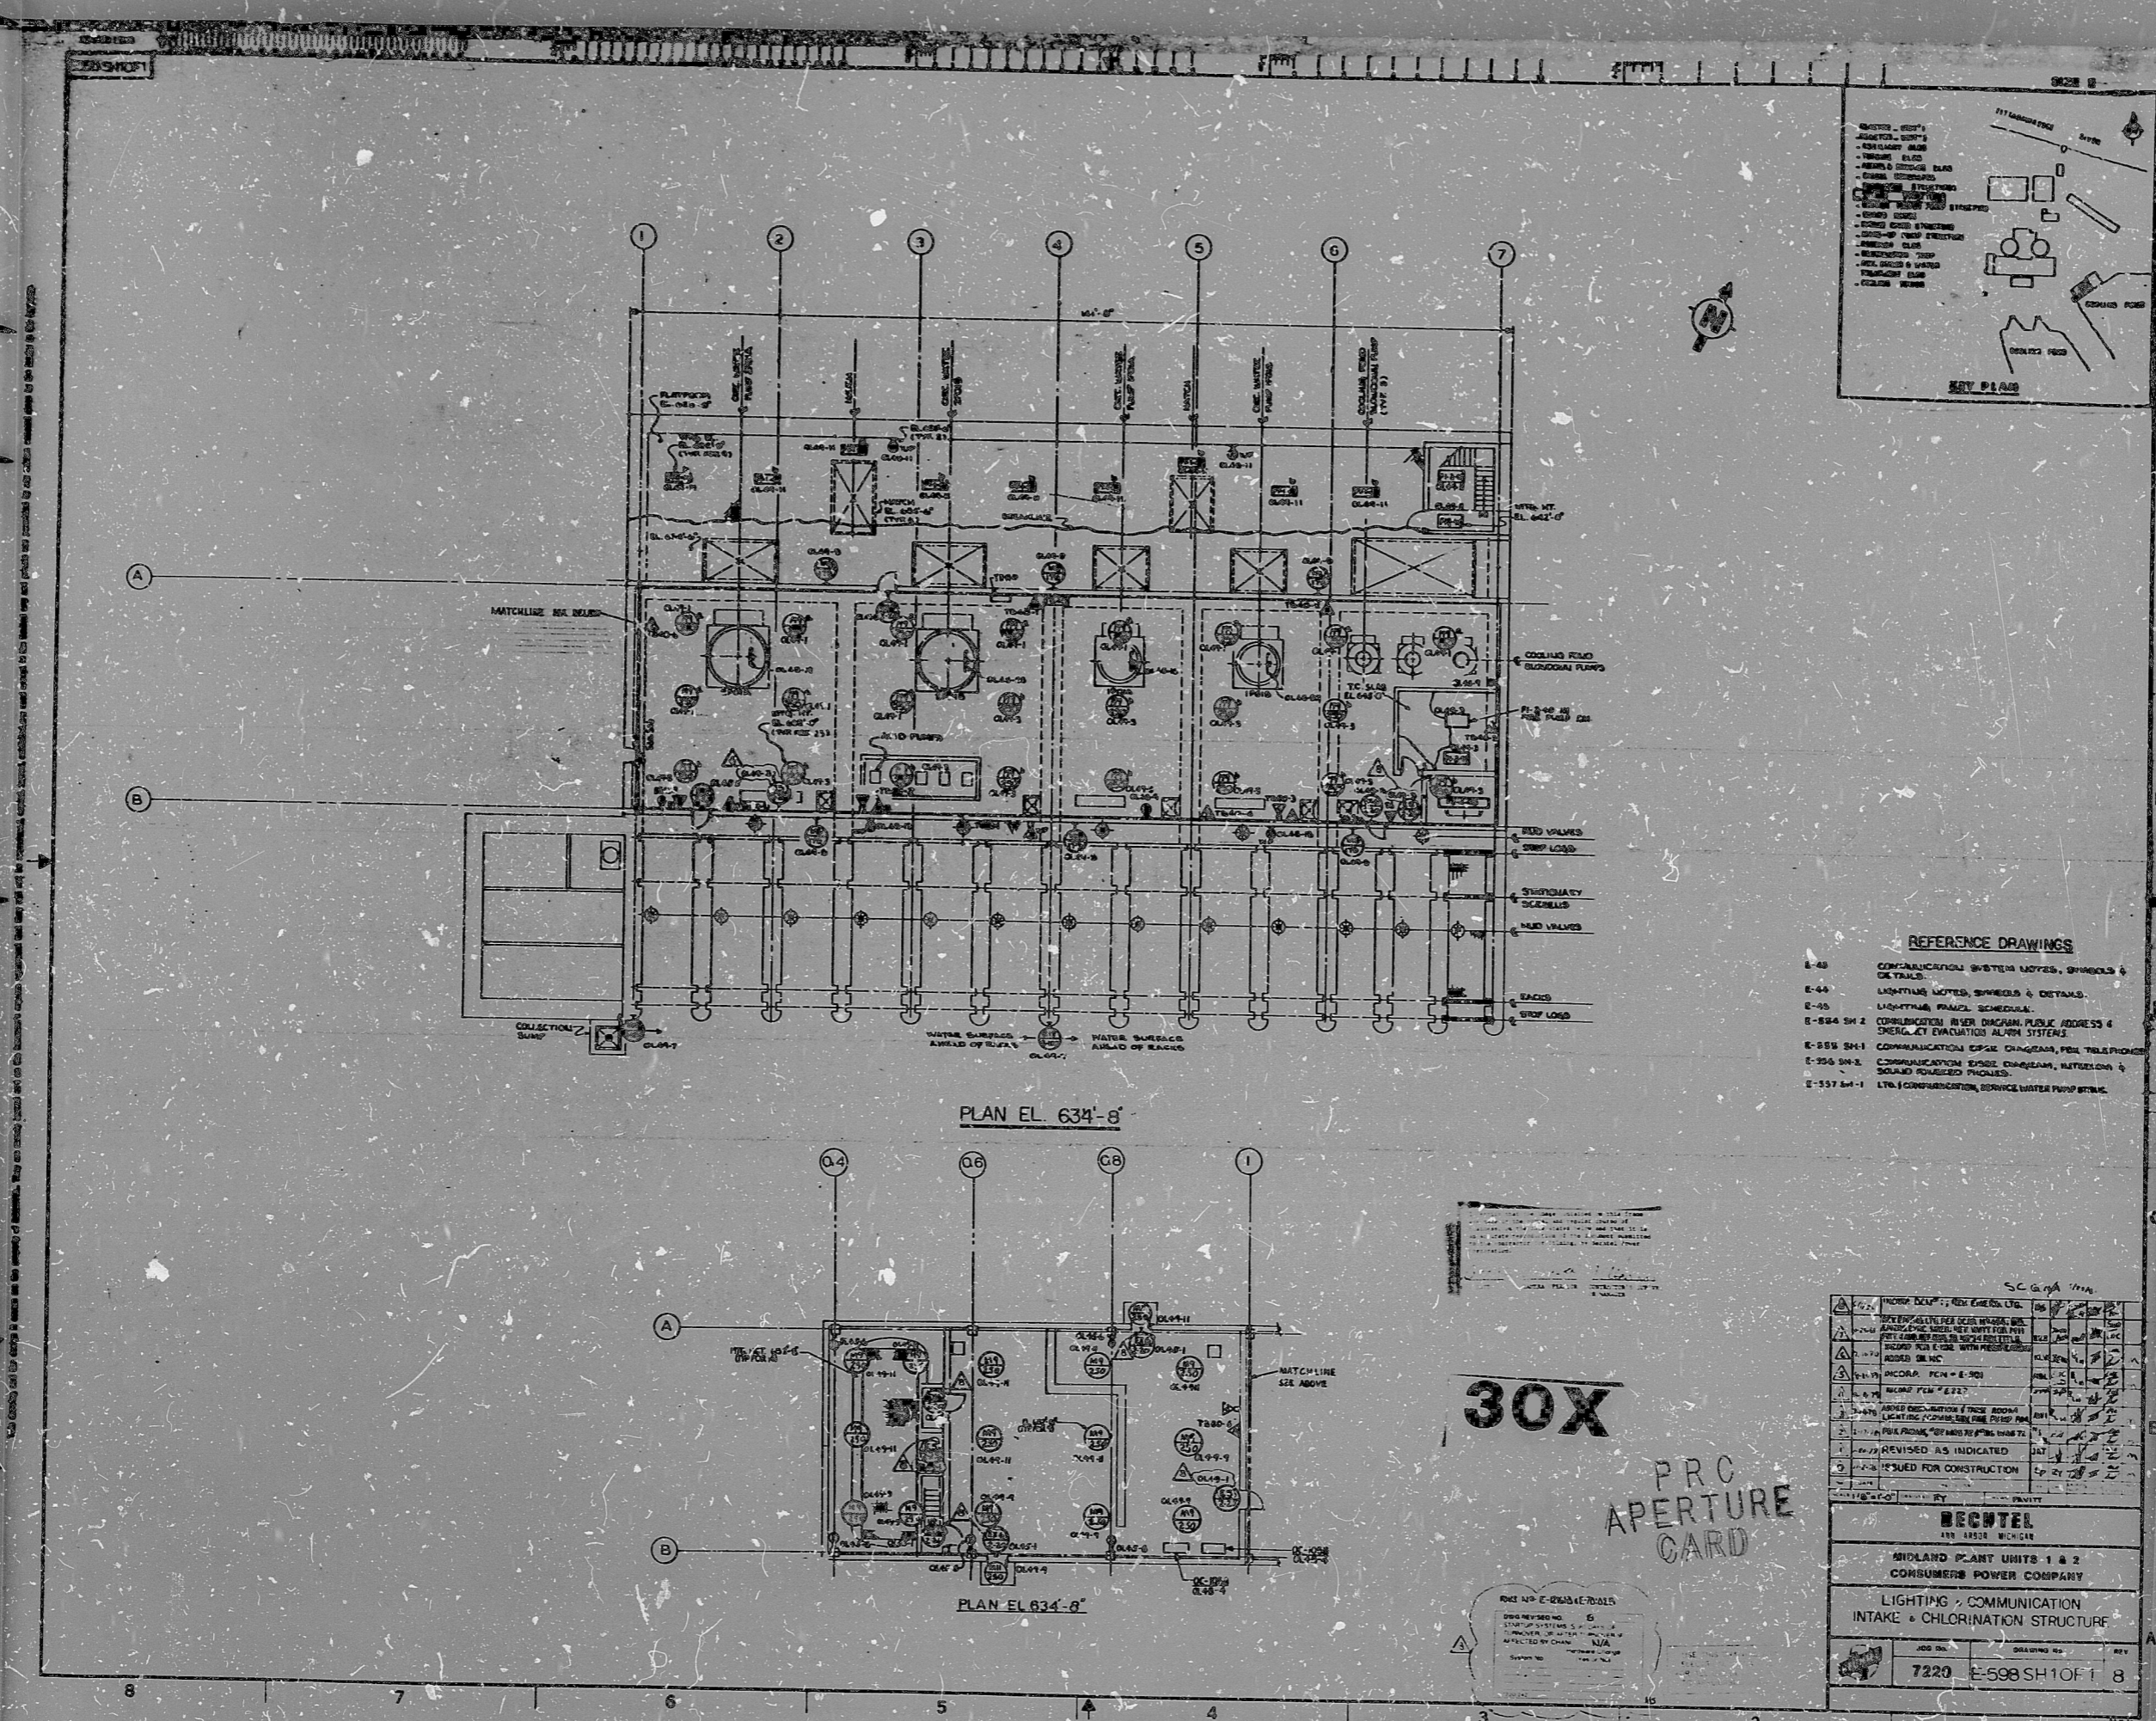

- REFERENCE DRAWINGS**
- E-48 COMMUNICATION SYSTEMS MOVES, SYMBOLS & DETAILS.
 - E-49 LIGHTING NOTES, SYMBOLS & DETAILS.
 - E-50 LIGHTING PANEL SCHEDULE.
 - E-504 SH-2 COMMUNICATION RISER DIAGRAM, PUBLIC ADDRESS & EMERGENCY EVACUATION ALARM SYSTEMS.
 - E-505 SH-1 COMMUNICATION RISER DIAGRAM, PUBLIC ADDRESS & EMERGENCY EVACUATION ALARM SYSTEMS.
 - E-506 SH-2 COMMUNICATION RISER DIAGRAM, PUBLIC ADDRESS & EMERGENCY EVACUATION ALARM SYSTEMS.
 - E-507 SH-1 LVA COMMUNICATION, SERVICE WATER PUMP STRIKE.

NO.	DESCRIPTION	DATE	BY	CHKD.

30X
PRC APERTURE CARD


BECHTEL
390 BRIDGE AVENUE
SAN FRANCISCO, CALIF. 94133

MIDLAND PLANT UNITS 1 & 2
CONSUMERS POWER COMPANY

LIGHTING & COMMUNICATION
INTAKE & CHLORINATION STRUCTURE

JOB NO. **7220** DRAWING NO. **E-598 SH10F1 8**

RIDS

8302040103

