



J-750 (Q)

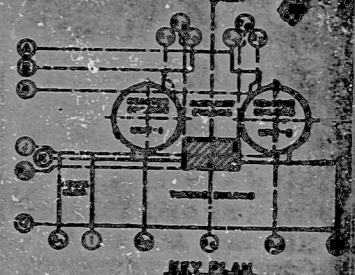

30X

7-11-52 R. C. ...  
AND ...  
CONTRACT NO. ...

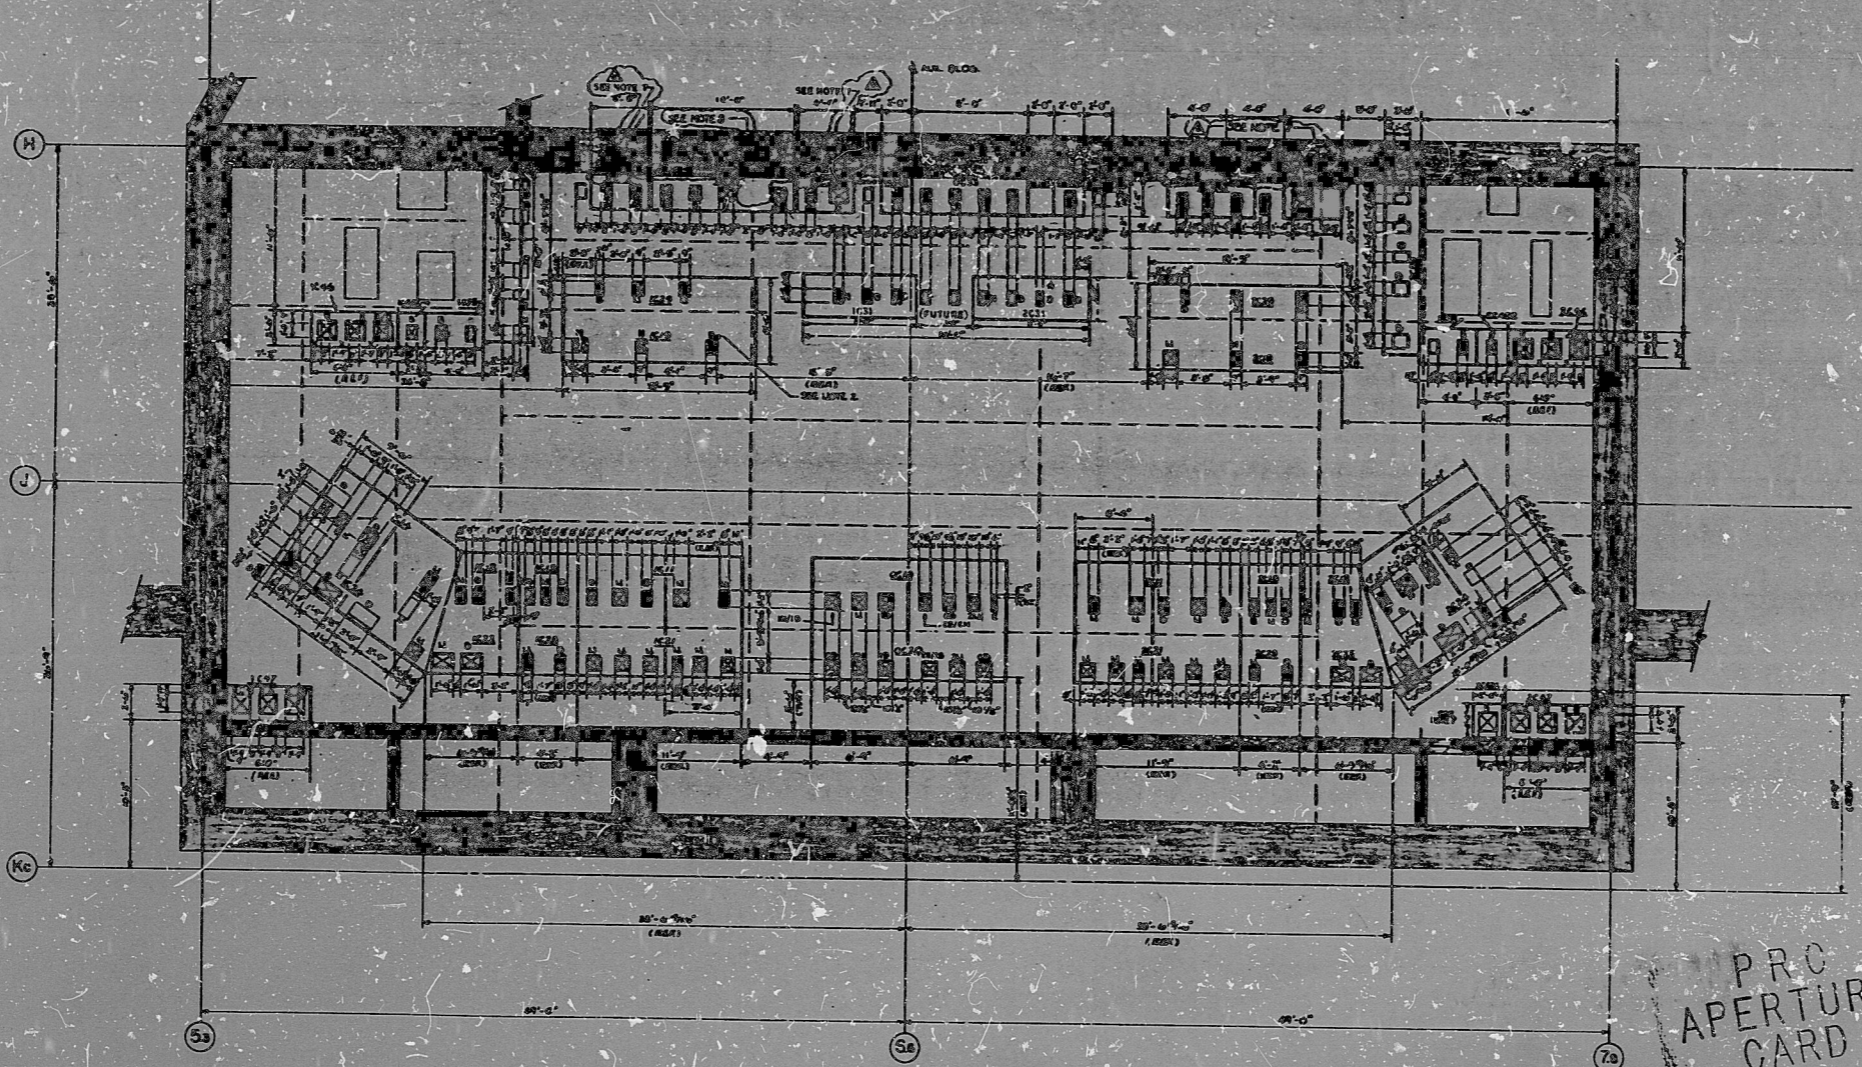

- NOTES**
1. PANEL & FLOOR PENETRATION DEETS
  9. PANEL DEET IS SET AT 1/2" OUT FROM SOUTH SIDE OF WALL FACE.

**Q LIST ITEMS**  
REVISIONS (COMMUNICATIONS) - 10, 11, 12

10	REVISED AS INDICATED	11/15/52	...
11	REVISED AS INDICATED	11/15/52	...
<b>BECHTEL</b> AND ASSOCIATES		
MIDLAND PLANT UNITS 1 & 2 CONDENSERS POWER COMPANY		
MAIN CONTROL ROOM FLOOR PENETRATION AND CONTROL PANEL LAYOUT		
7220	J-750 (Q)	8

PRO APERTURE CARD

POOR ORIGINAL

17  
11  
8.5  
9.5  
11  
17

17  
11  
8.5  
9.5  
11  
17



DDAINT

RIDS

830204013

