

17

6.5"

8.5"

17

17



11

8.5"

8.5"

11

17

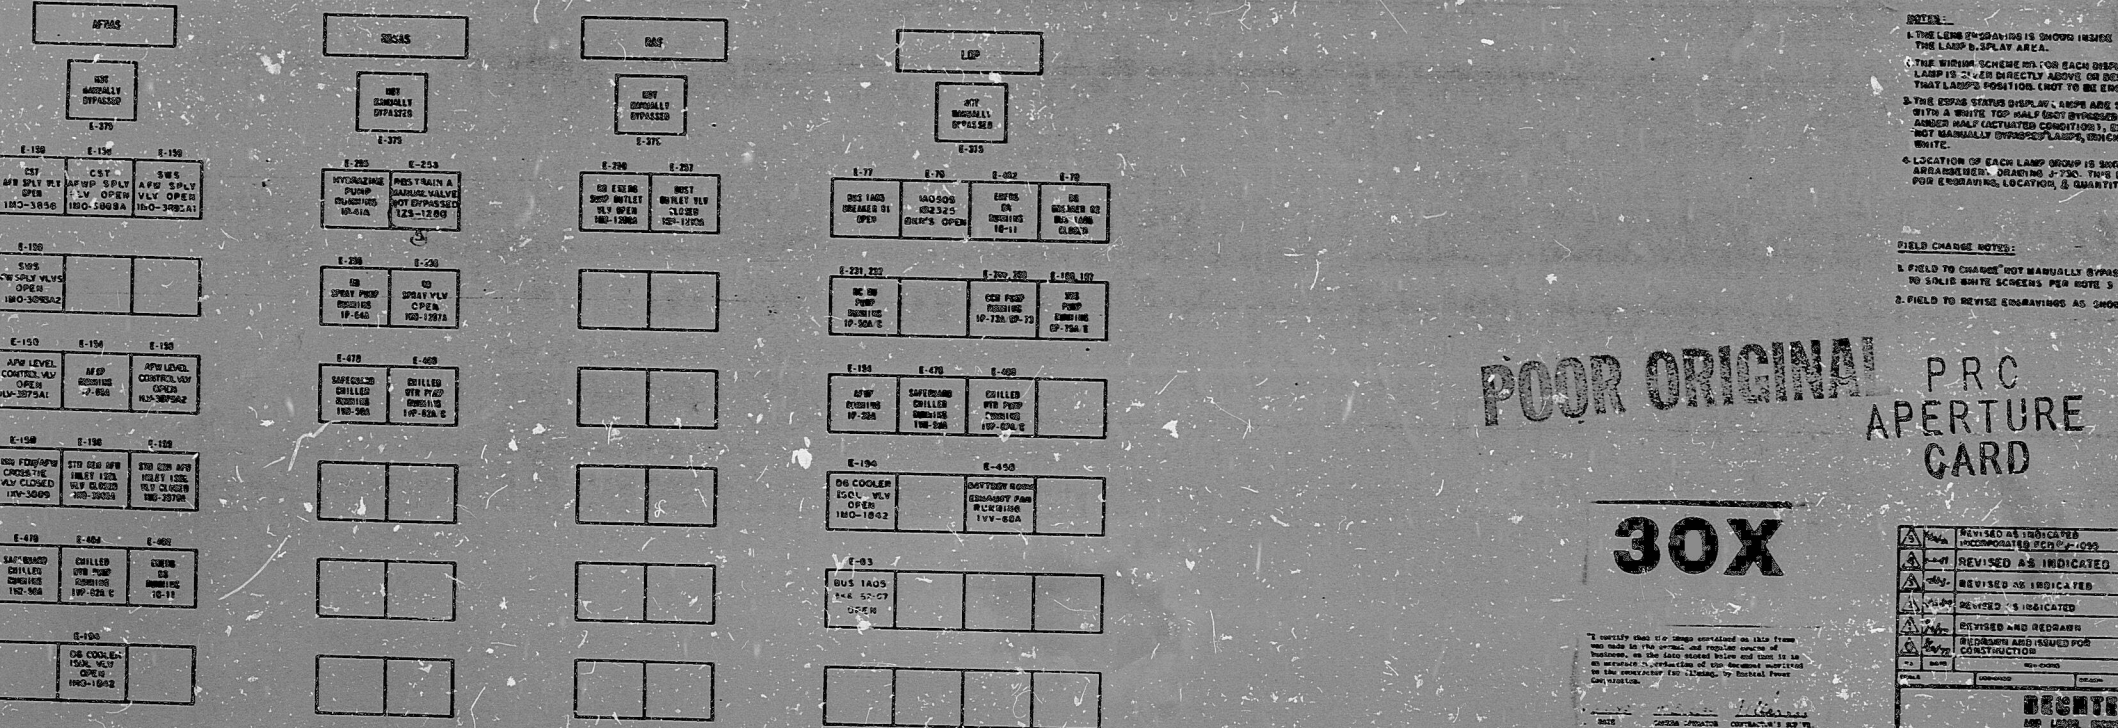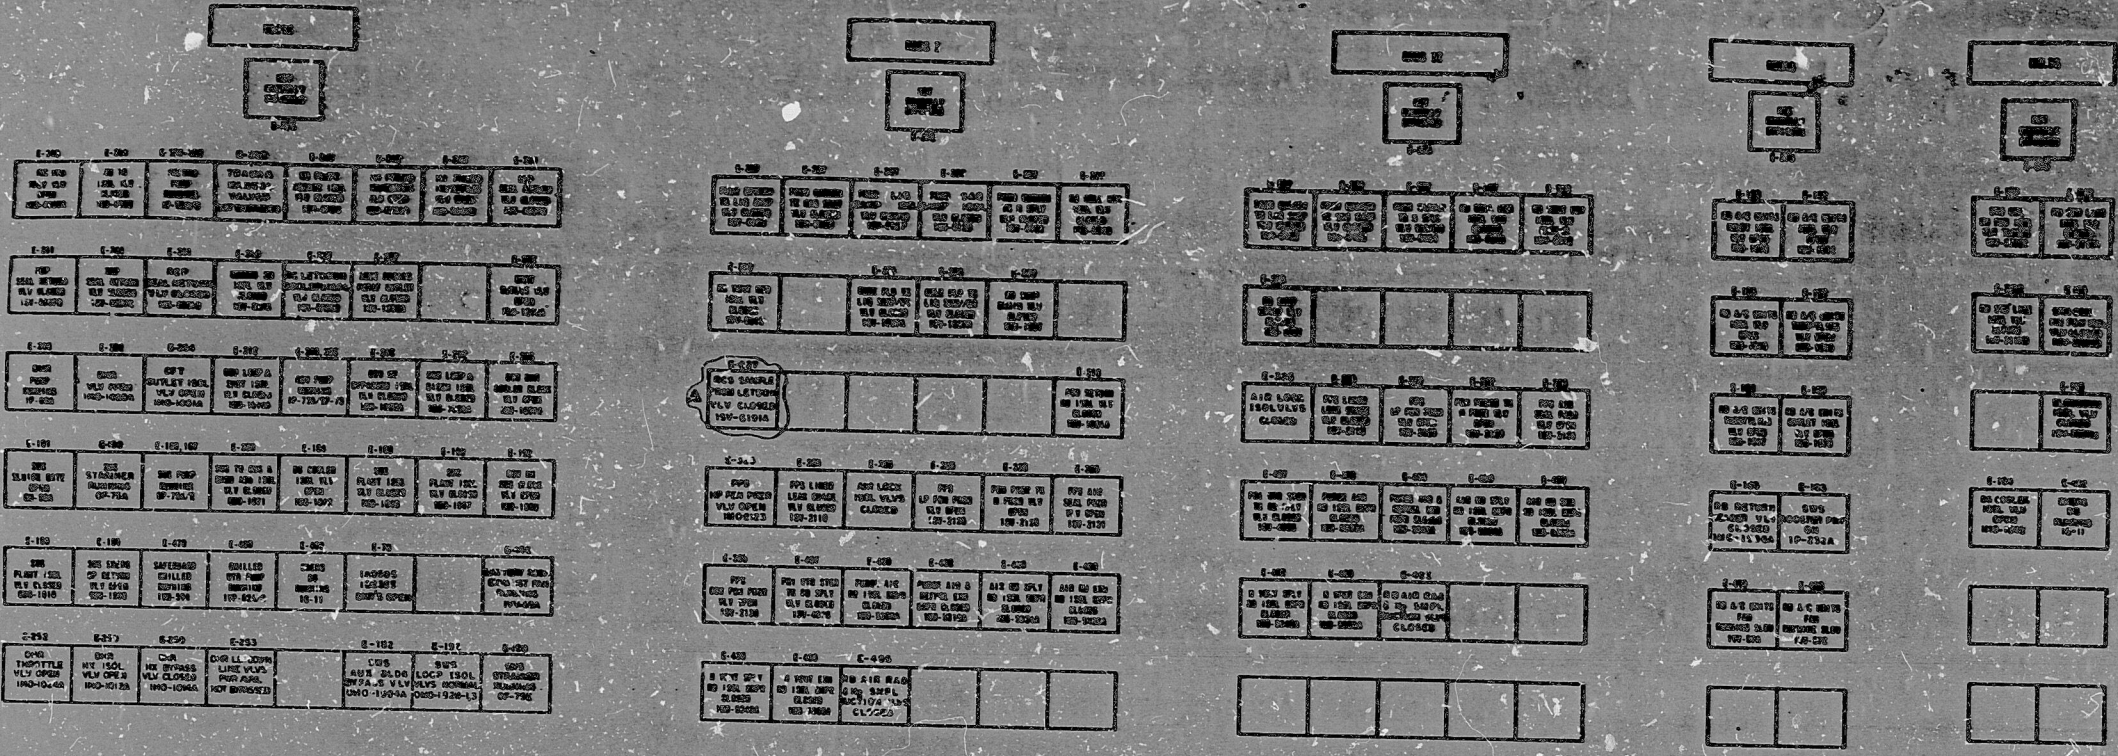

NOTES:

- THE LAMP POSITION IS SHOWN INSIDE THE LAMP DISPLAY AREA.
- THE WIRING SCHEME FOR EACH DISPLAY LAMP IS SHOWN DIRECTLY ABOVE OR BELOW THAT LAMP'S POSITION (NOT TO BE ENGRAVED).
- THE STATUS DISPLAY LAMP ARE SPILT SCREEN WITH A WHITE TOP HALF (NOT ENGRAVED) AND A RED HALF (FACTORY CONDITION), EXCEPT THE NOT MANUALLY OPERATED LAMP, WHICH ARE SOLID WHITE.
- LOCATION OF EACH LAMP GROUP IS SHOWN ON ATTACHED DRAWING 722. THE DRAWING IS FOR ENGRAVING, LOCATION & QUANTITY ONLY.

FIELD CHANGE NOTES:

- FIELD TO CHANGE "NOT MANUALLY OPERATED" SPILT SCREEN TO SOLID WHITE SCREENS PER NOTE 3 ABOVE.
- FIELD TO REVISE ENGRAVINGS AS SHOWN.

POOR ORIGINAL PRC APERTURE CARD

30X

30X

7380 J-722 SH 1 5

REVISED AS INDICATED	REVISED AS INDICATED	REVISED AS INDICATED	REVISED AS INDICATED	REVISED AS INDICATED
<input type="checkbox"/>	<input type="checkbox"/>	<input type="checkbox"/>	<input type="checkbox"/>	<input type="checkbox"/>
<input type="checkbox"/>	<input type="checkbox"/>	<input type="checkbox"/>	<input type="checkbox"/>	<input type="checkbox"/>
DECTEL
 AND ASSOCIATED COMPANIES
 ESFAS STATUS DISPLAY
 ICA
 CHAN A
 7380 J-722 SH 1 5

RIDS

8302040119

