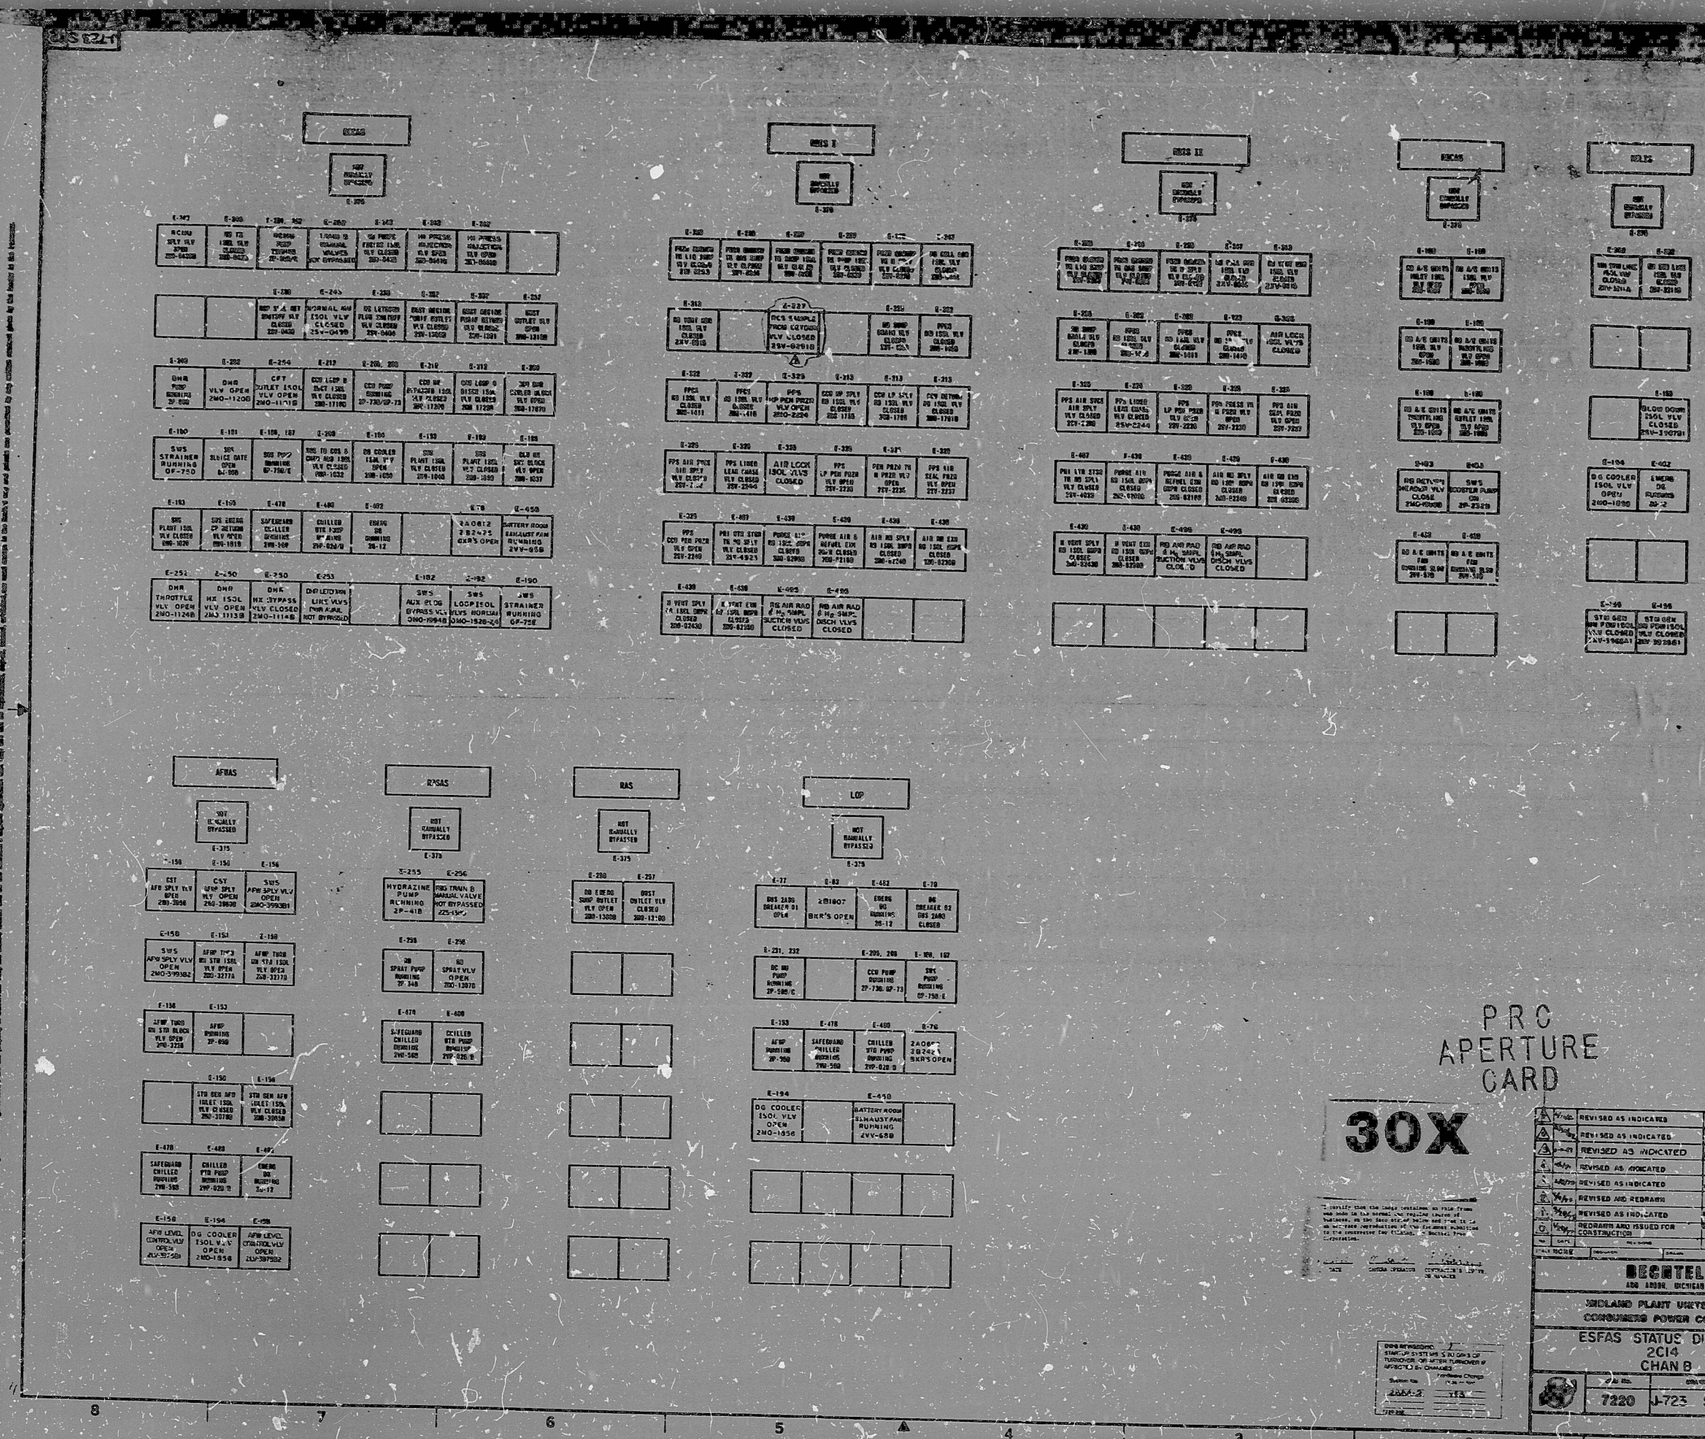
AFWAS
RCAS
RAS
LOP
PRC
APERTURE
CARD
30X
BECHTEL
ANN ARBOR, MICHIGAN
MIDLAND PLANT UNITS 1 & 2
CONSUMERS POWER COMPANY
ESFAS STATUS DISPLAY
2C14
CHAN B
7220
J-723 SH 2
REVISED AS INDICATED
REVISED AS INDICATED
REVISED AS INDICATED
REVISED AS INDICATED
REVISED AS INDICATED
REVISED AS INDICATED
REDRAWN AND ISSUED FOR CONSTRUCTION

RIDS

8302049132

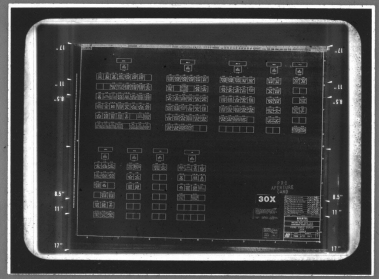

MMM 5824 — FILMSORT® Brand Aperture & Camera Cards and DUPLICARD® Brand Copy Cards — Product of 3M Company, St. Paul, Minn.