


17"
11"
8.5"
6.5"
11"
17"

17"
11"
8.5"
6.5"
11"
17"

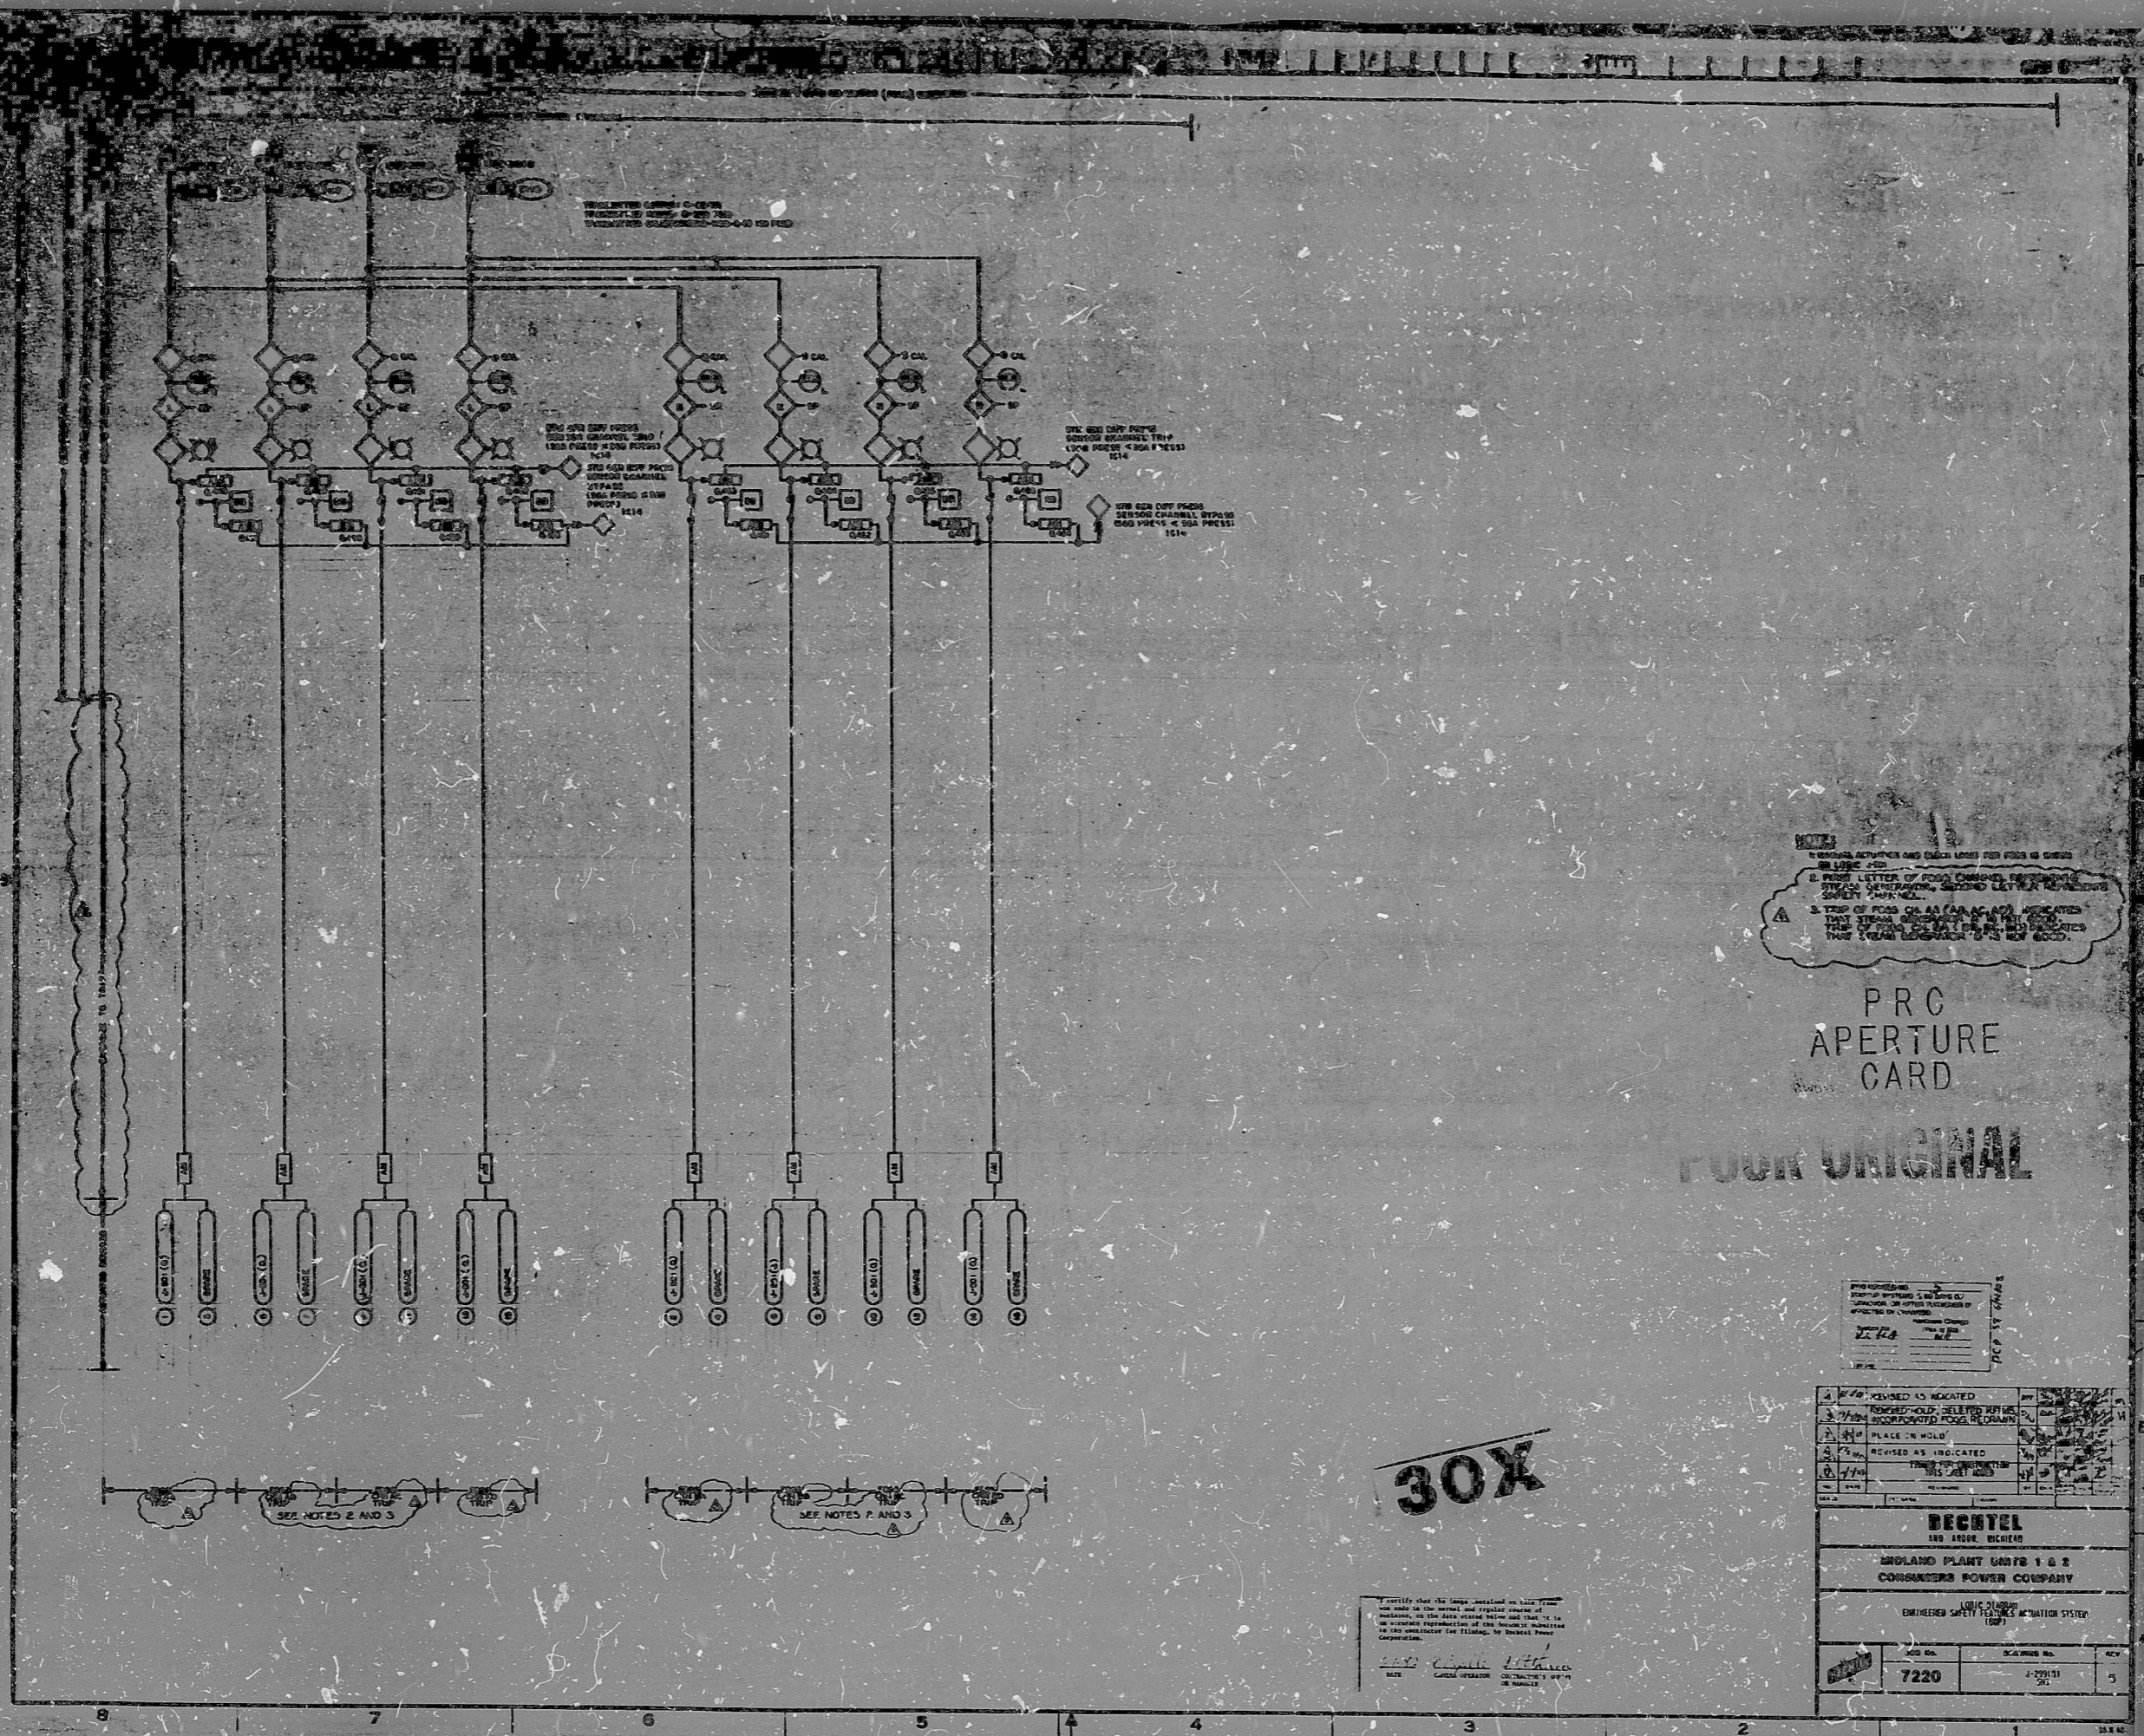

NOTE:
 1. SIGNAL ACTUATOR AND CHECK LIGHT FOR PRC IS SHOWN IN LINE 300.
 2. FIRST LETTER OF PRC CHANNEL IDENTIFICATION SYSTEM IDENTIFICATION, SECOND LETTER INDICATES SAFETY STATUS.

PRC
 APERTURE
 CARD



REVISIONS	DATE	BY	REASON
1			REVISED AS INDICATED

BECHTEL


LOGIC DESIGN
 ENGINEERED SAFETY FEATURES ACTUATOR SYSTEM
 (EAF)

SCALE NO. 7220
 DRAWING NO. 1-22015
 REV. 5

30X

I certify that the data contained on this form was made in the normal and regular course of business, as the data stated herein and that it is an accurate representation of the business transactions in the conduct of the business of Bechtel Power Corporation.

 NAME: [Signature]
 TITLE: CONTROL OPERATOR
 NAME: [Signature]
 TITLE: CONTRACTOR'S REPRESENTATIVE

RIDS

8302040179

