


17"  
11"  
8.5"  
8.5"  
11"  
17"

17"  
11"  
8.5"  
8.5"  
11"  
17"

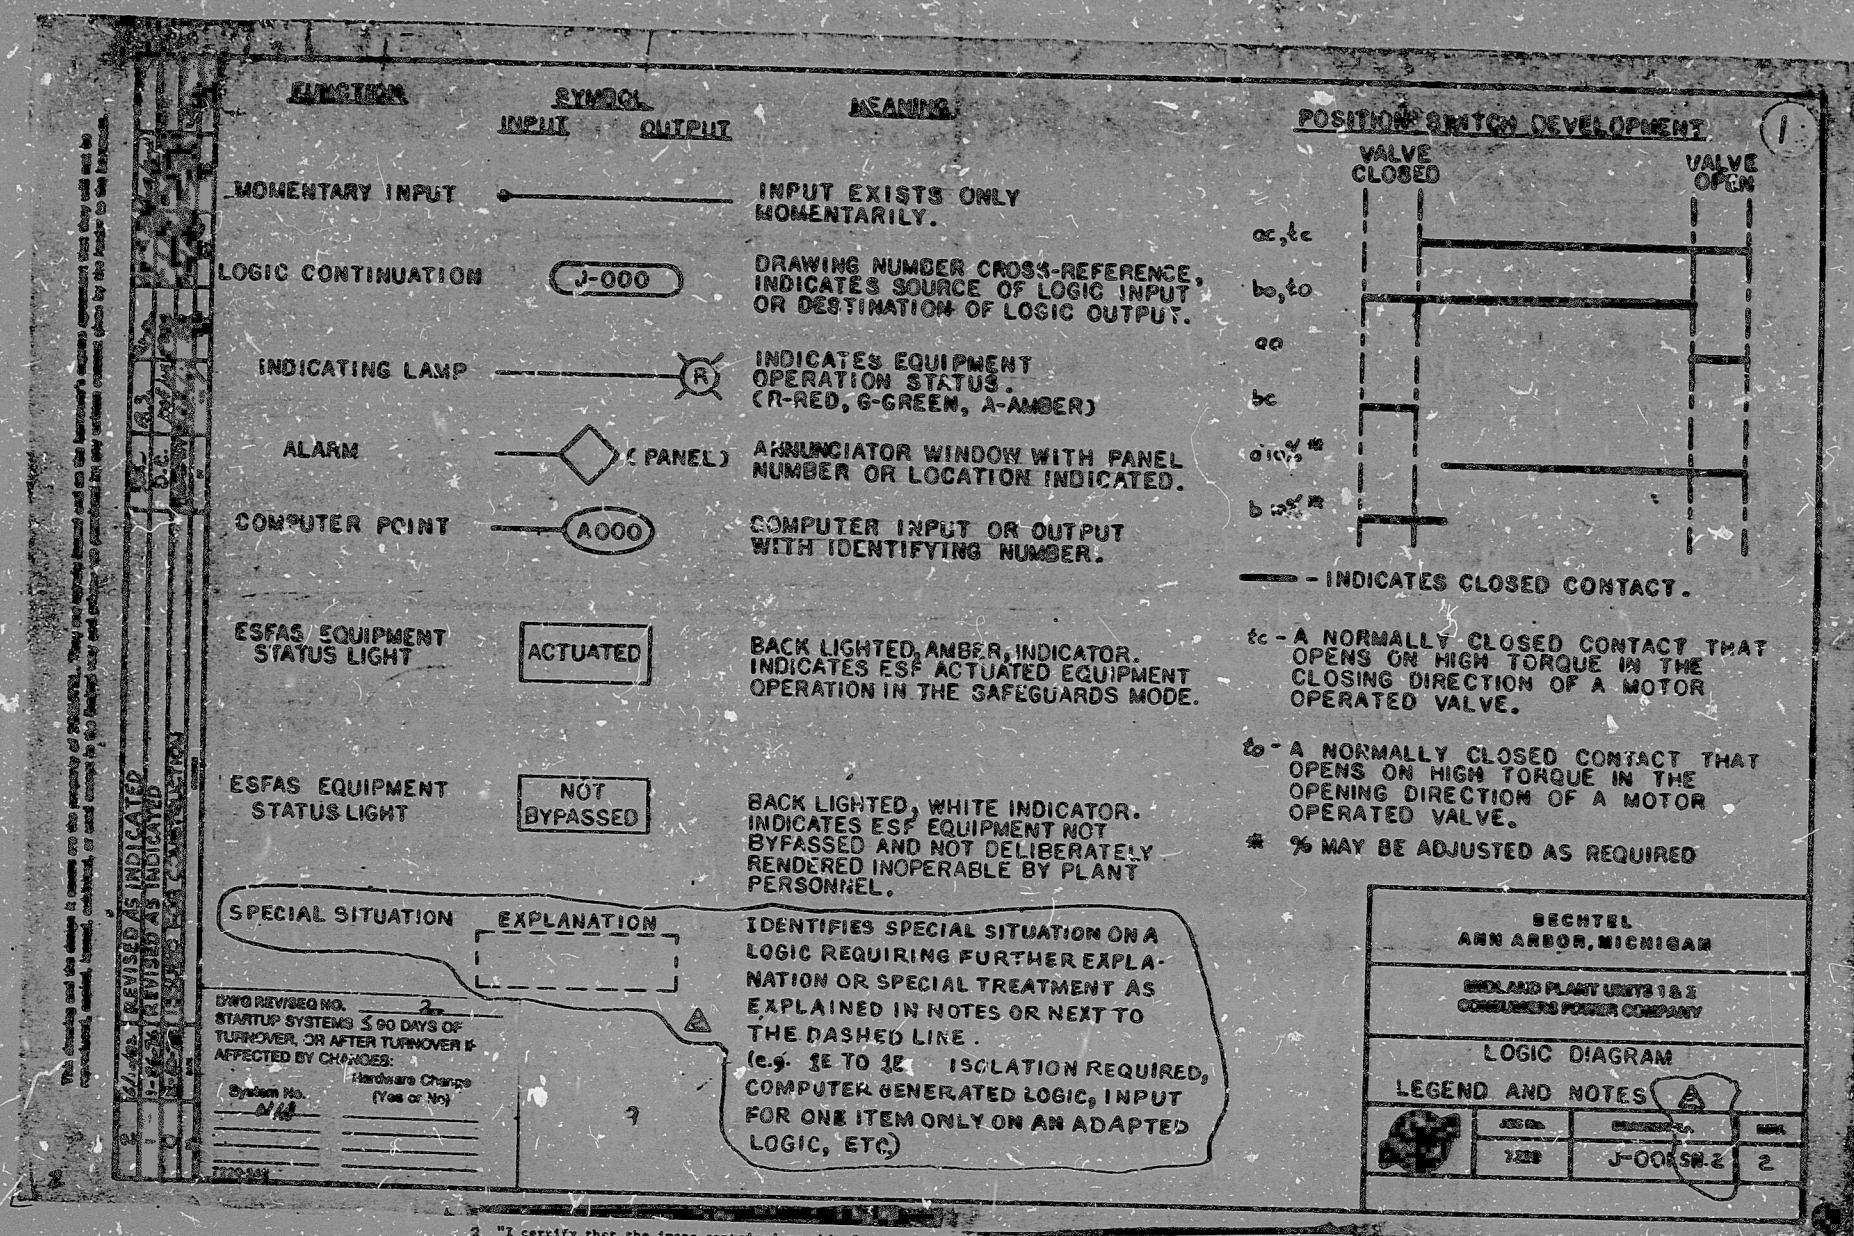

This drawing and the design it covers are the property of BECHTEL. They are prepared hereunder and to the licensee's express agreement that they shall not be reproduced, altered, copied, or used except in the manner and for the purposes intended by the licensee.

1. REVISIONS AS INDICATED  
 2. REVISIONS AS INDICATED

DWD REVISED NO. 2  
 STARTUP SYSTEMS 590 DAYS OF  
 TURNOVER, OR AFTER TURNOVER IF  
 AFFECTED BY CHANGES:  
 System No. NA  
 Hardware Change (Yes or No)

I certify that the image contained on this frame was made in the normal and regular course of business, of the data stated below and that it is an accurate reproduction of the document submitted to the contractor for filming, by Bechtel Power Corporation.  
 DATE: 6-15-82  
 CAMERA OPERATOR: M. Coles  
 CONTRACTOR'S SUPERVISOR: J. Williams

BECHTEL  
 ANN ARBOR, MICHIGAN  
 CONSUMERS POWER COMPANY  
 LOGIC DIAGRAM  
 LEGEND AND NOTES

	ISS. NO.	REVISION	DATE
	1228	J-0005R-2	2

**16X**  
 P.R.O.  
 APERTURE  
 CARD



RIDS

8302040185

