


11
11
5.2
11
11
11
11

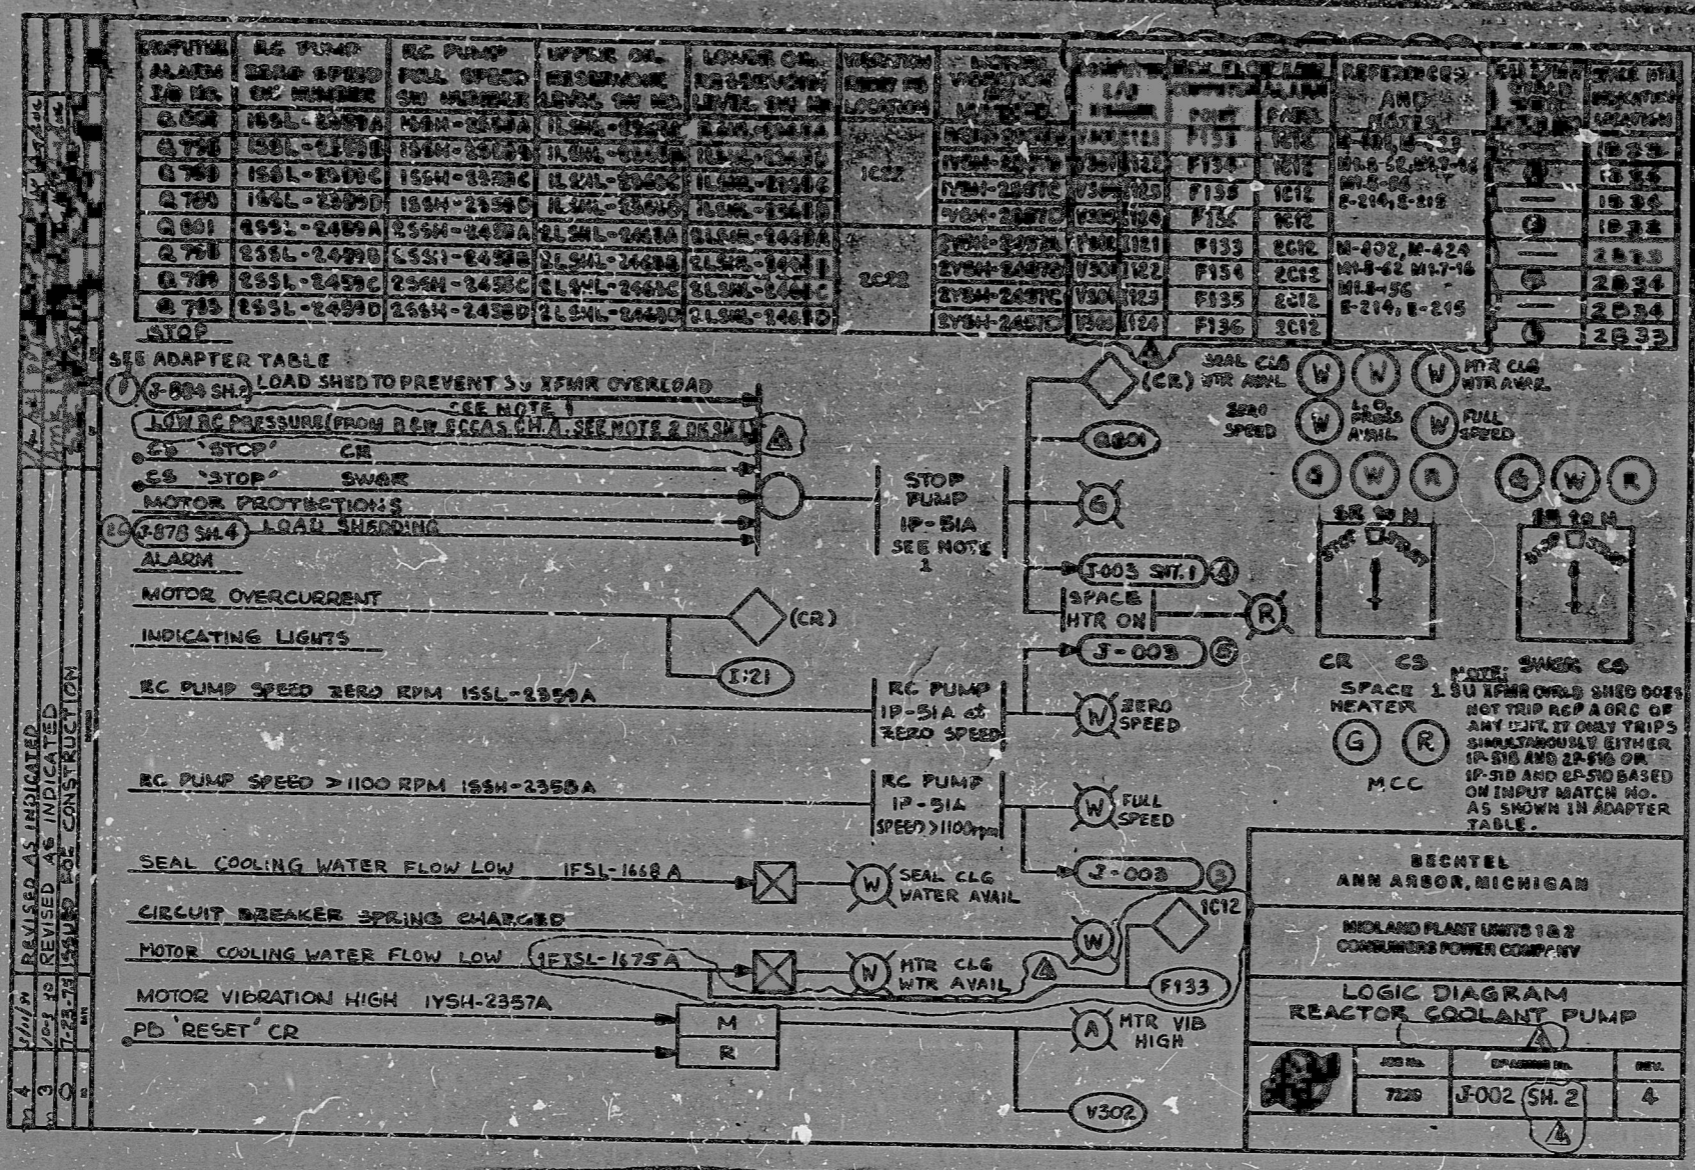

PRC
APERTURE
CARD

I certify that the image contained on this frame was made in the normal and regular course of business, on the date stated below and that it is an accurate reproduction of the document submitted to reprographics.
3-8-80
DATE
SUPERVISOR OF REPROGRAPHICS

16X

11
11
5.8
11
11
11
11
11
8.5
11
11

RIDS

8302040196

