

I certify that the image contained on this frame was made in the normal and regular course of business, on the date stated below and that it is an accurate reproduction of the document submitted to the contractor for filing, by Bechtel Power Corporation.

6-8-82 C. Claxton J. Ottaviano  
 DATE CAMERA OPERATOR CONTRACTOR'S SUP'V  
 OR MANAGER


16X

R6

This drawing and the design it covers are the property of BECHTEL. They are hereby loaned and on the borrower's account equipment that they will not be reproduced, copied, loaned, exhibited, or used except in the limited way and private use permitted by any written consent given by the lender to the borrower.

6	2/2/80	REVISED AS INDICATED
7	2/2/80	REVISED AS INDICATED
8	8-27-78	ISSUED FOR CONSTRUCTION
9		
10		

OPEN STOP VALVE

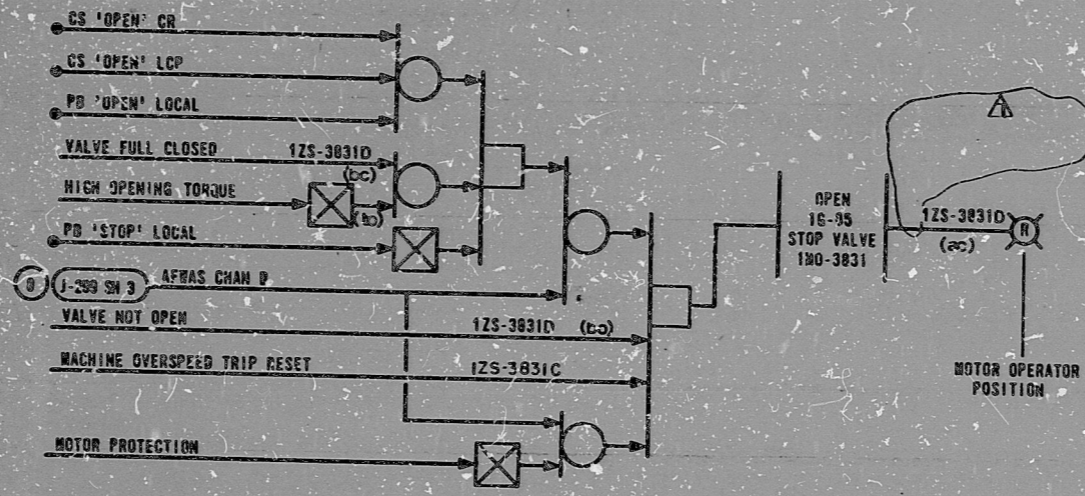

NOT BYPASSED	NOT BYPASSED
ACTUATED	ACTUATED
CR AFBAS STATUS	CR LOP STATUS

- NOTES:
1. THE LCP IS THE AUXILIARY SHUTDOWN PANEL, 1C114
  2. FOR REFERENCE SEE M-438 SH-3, M-439 SH-3A/B, E-153, M-419A

PRO APERTURE CARD

DWG REVISED NO. 7  
 STARTUP SYSTEMS ≤ 90 DAYS OF TURNOVER, OR AFTER TURNOVER IF AFFECTED BY CHANGES:  
 System No. Hardware Change (Yes or No)  
 2FA YES

BECHTEL ANN ARBOR, MICHIGAN		
MIDLAND PLANT UNITS 1 & 2 CONSUMERS POWER COMPANY		
LOGIC DIAGRAM AUXILIARY FEEDWATER PUMP-TURBINE		
JOB No.	DRAWING No.	REV.
7220	J-3210 SH 1	7

RIDS

8302040204

