


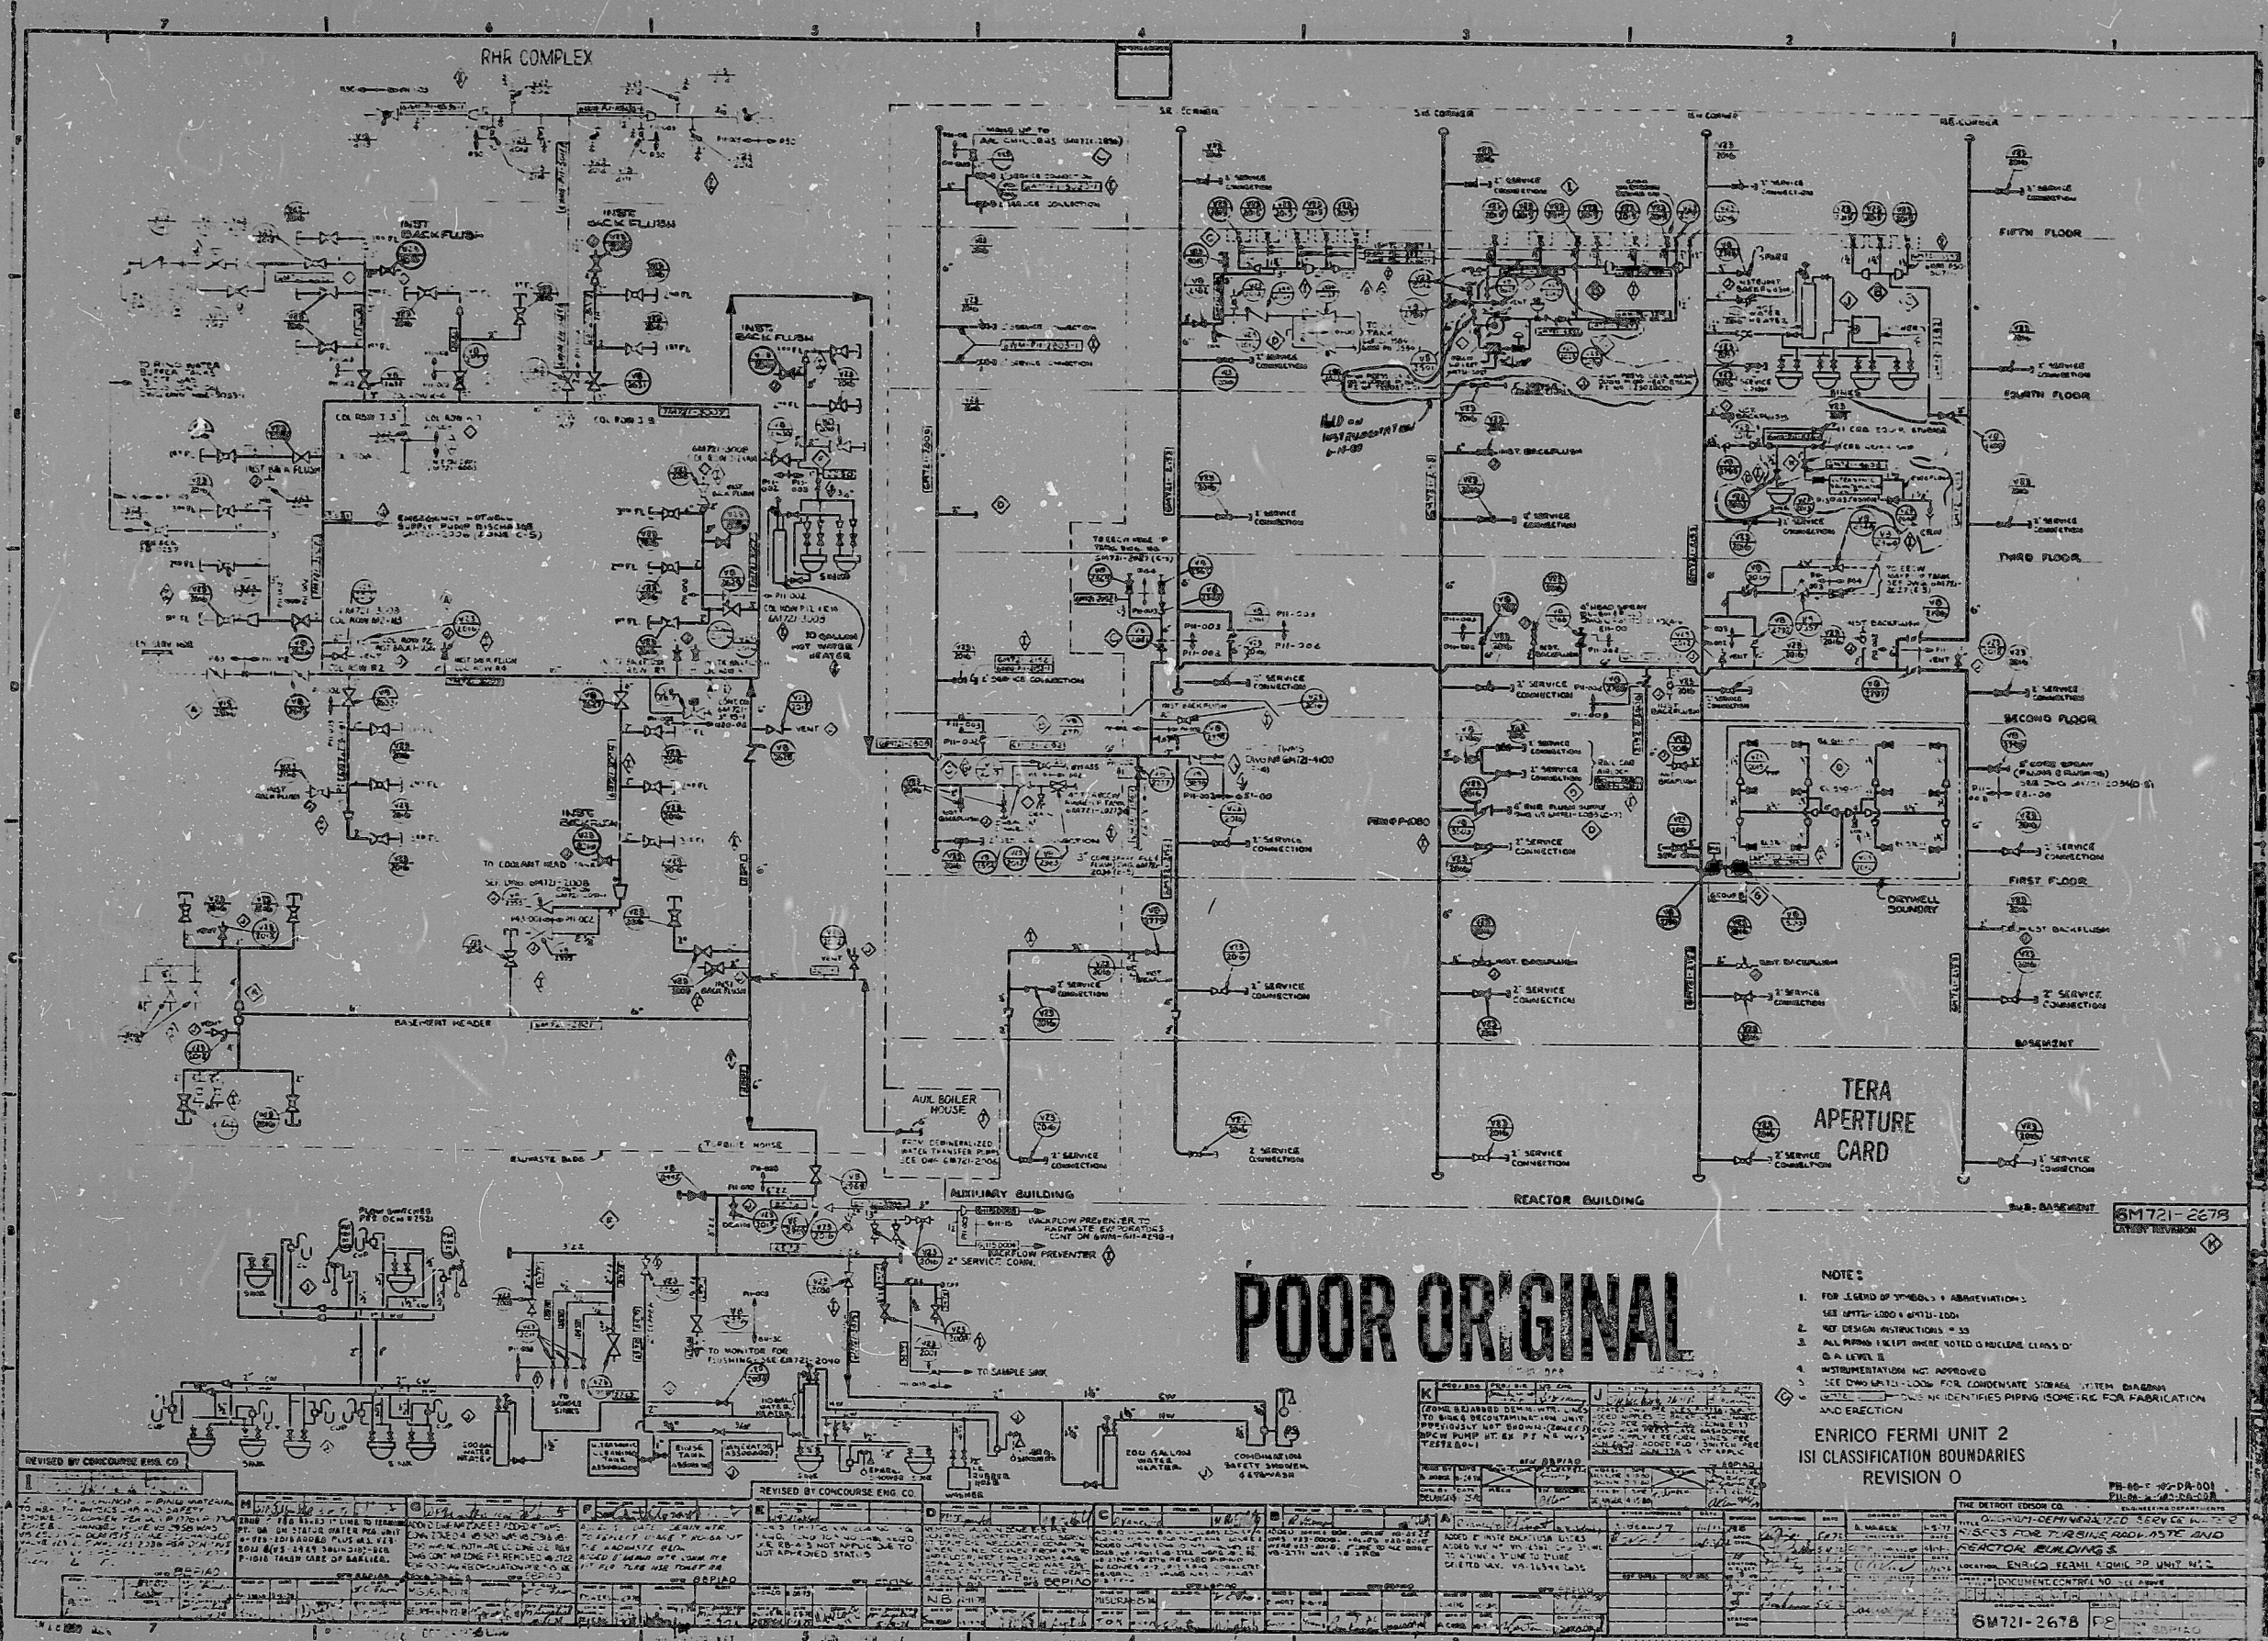

8108120139

