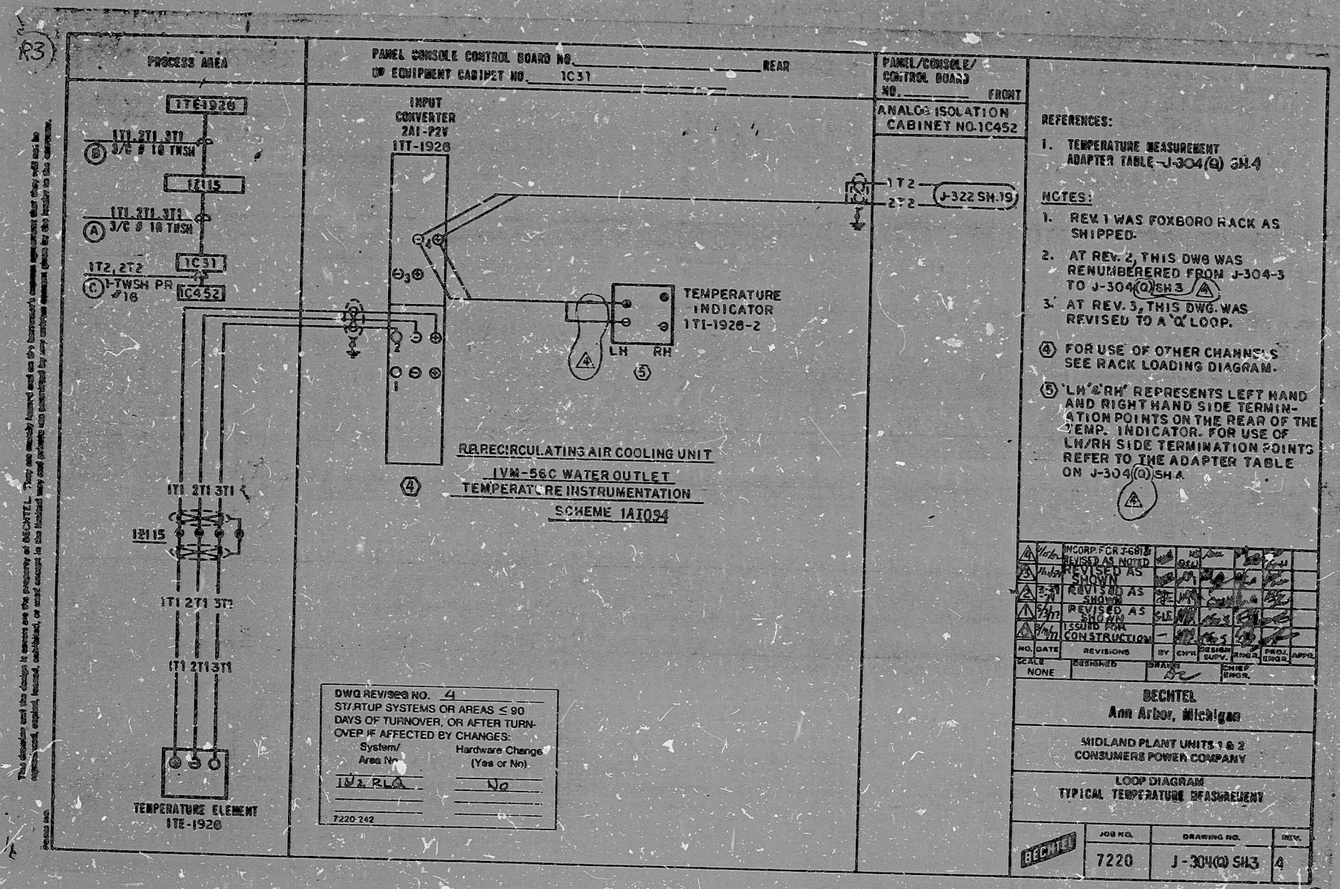

"I certify that the image contained on this frame was made in the normal and regular course of business, on the data stated below and that it is an accurate reproduction of the document submitted to the contractor for filming, by Bechtel Power Corporation.

11-1-82 DATE
M. Cricchi CAMERA OPERATOR
D. Mahoney CONTRACTOR'S SUP'VR. OR MANAGER

16X

PRC APERTURE CARD

RIDS

8302040253

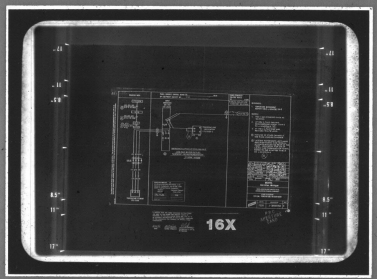

MMM 5824 — FILMSORT® Brand Aperture & Camera Cards and DUPLICARD® Brand Copy Cards — Product of 3M Company, St. Paul, Minn.