POOR ORIGINAL

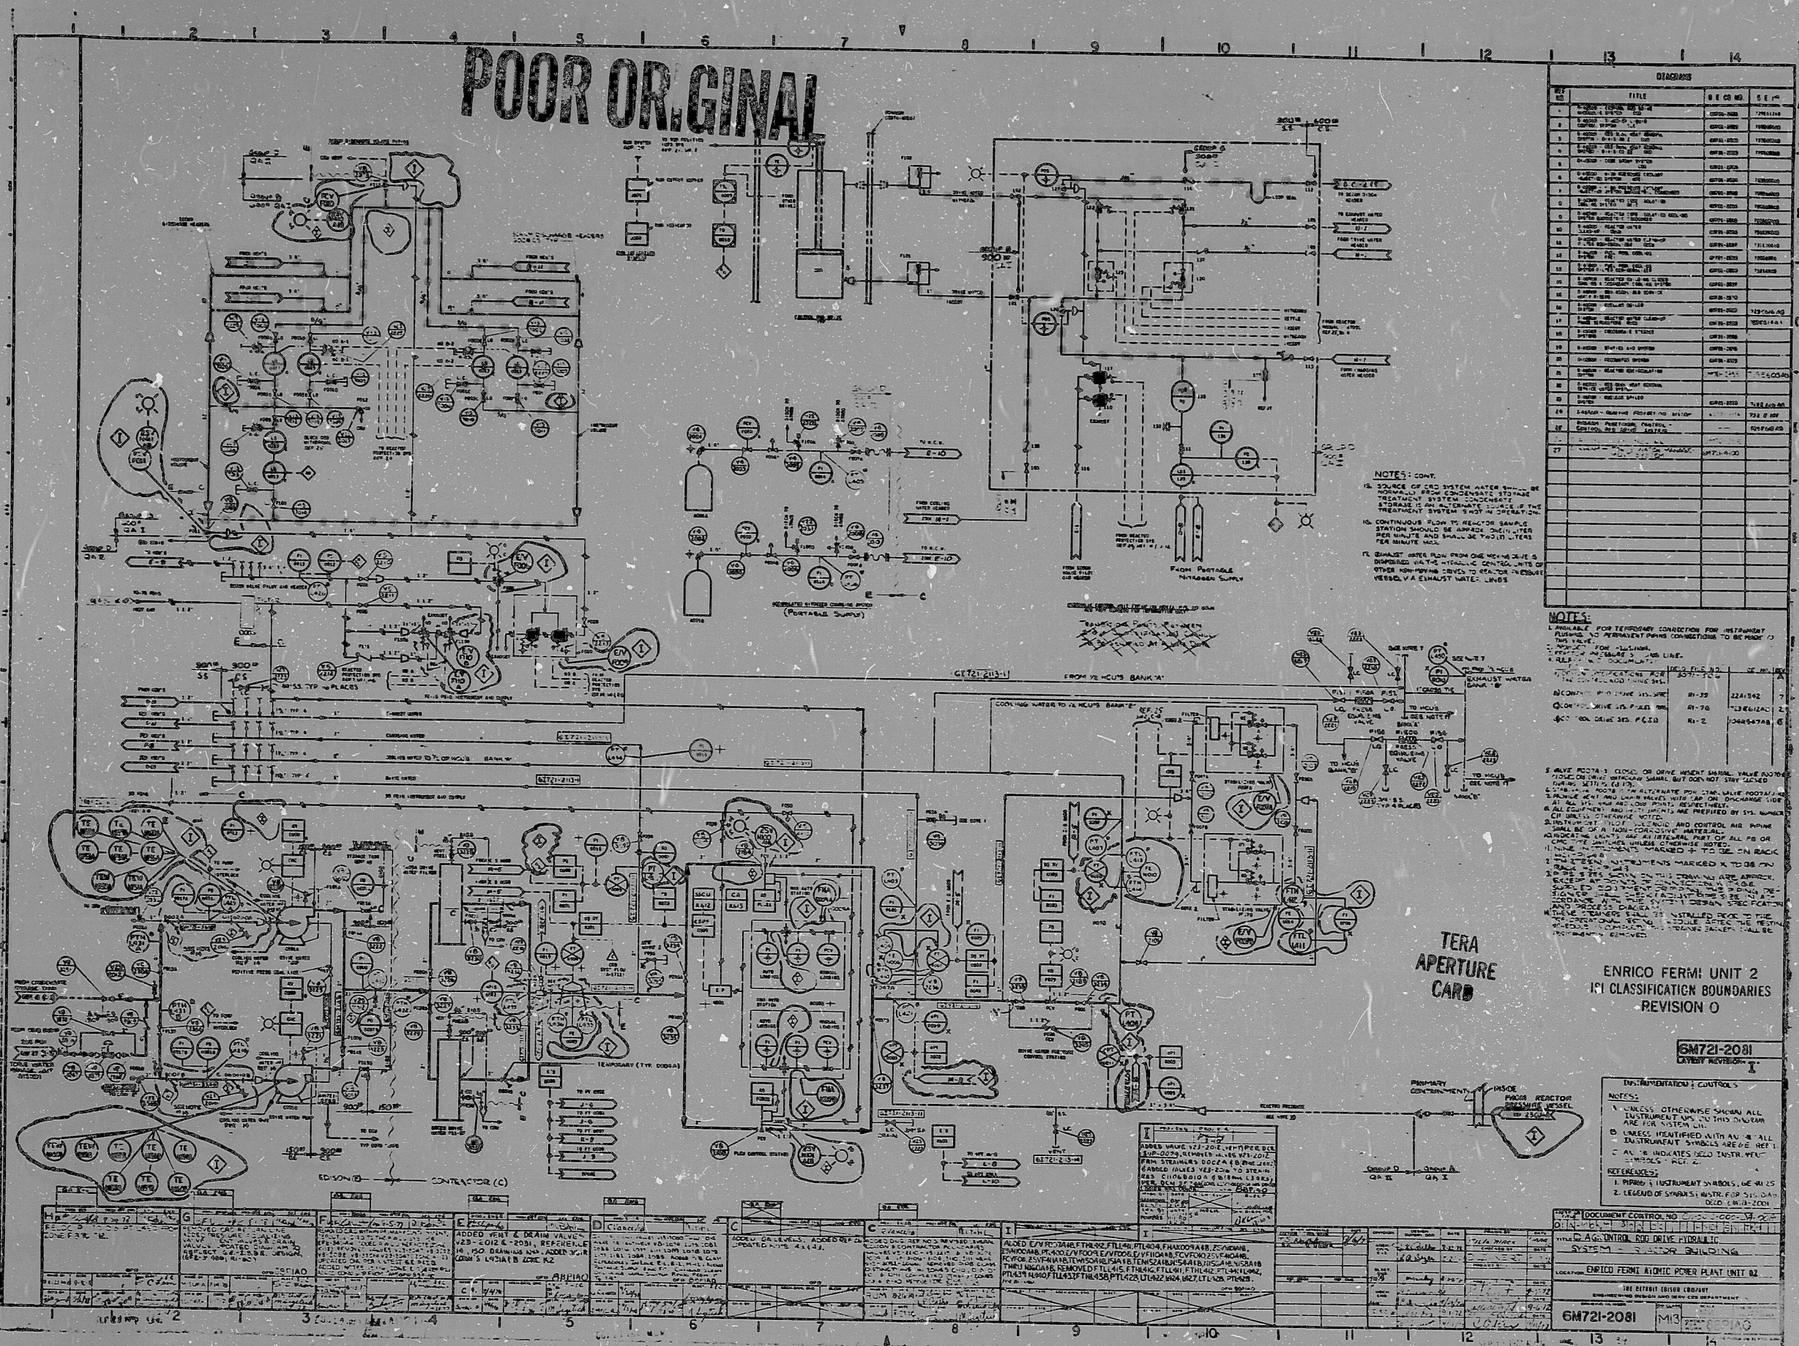

REV NO	DIAGRAMS TITLE	DTE CO NO.	SEE NO
1			
2			
NOTES: CONT.

15. MAKE-UP AND SYSTEM WATER SHALL BE NORMALLY FROM CONDENSATE STORAGE TREATMENT SYSTEM. CONDENSATE STORAGE IS AN ALTERNATE SOURCE IF THE TREATMENT SYSTEM IS NOT IN OPERATION.

16. CONTINUOUS FLOW TO REACTOR SAMPLE STATION SHOULD BE APPROX. 300 LITERS PER MINUTE AND SHALL BE TWO (2) LITERS PER MINUTE MIN.


NOTES:

1. AVAILABLE FOR TEMPORARY CONNECTION FOR INSTRUMENT FLUSHING TO PERMANENT PIPING CONNECTIONS TO BE MADE BY [illegible]


5. VALVE POSITION IS CLOSED OR DRIVE INSERT SHOWN. VALVE POSITION IS CLOSED OR DRIVE WITHDRAWN SHOWN, BUT DOES NOT STAY LOCKED DURING SCRAM TO CLOSE.

6. [illegible] VALVE POSITION FOR STAR VALVE POSITION IS [illegible] VALVES WITH AP OR DISCHARGE SIDE [illegible] ALL EQUIPMENT AND LOOP POINTS, RESPECTIVELY. [illegible] ARE PREFIXED BY SYS. NUMBER

7. [illegible] AND CONTROL AIR PIPING [illegible] INSTRUMENTS MARKED X TO BE ON [illegible] INSTRUMENTS MARKED + TO BE IN RACK

8. [illegible] INSTALLED PER SPECIFICATION [illegible] SHALL BE REMOVED

TERA APERTURE CARD

ENRICO FERMI UNIT 2
ICI CLASSIFICATION BOUNDARIES
REVISION 0

6M721-2081
LATEST REVISION I

INSTRUMENTATION & CONTROLS

NOTES:
1. UNLESS OTHERWISE SHOWN ALL INSTRUMENTS ARE TO THIS DIAGRAM ARE FOR INTERLOCK.
2. UNLESS IDENTIFIED WITH AU OR ALL INSTRUMENT SYMBOLS ARE OF HEIT [illegible]
3. ALL X INDICATES DEDD INSTRUMENTS [illegible]

REFERENCES:
1. PIPING & INSTRUMENT SYMBOLS, GE 49125
2. LEGEND OF SYMBOLS, REVISION FOR SYS. DIAG. DEDD E 6M721-2001

DOCUMENT CONTROL NO [illegible]
TITLE: CAD-UNTROL RID DRIVE HYDRAULIC
SYSTEM - REACTOR BUILDING
LOCATION: ENRICO FERMI ATOMIC POWER PLANT UNIT 02
THE DETROIT EDISON COMPANY
ENGINEERING DESIGN AND NEW CES DEPARTMENT
6M721-2081 M13 DEDD

8.5" 11" 17"

8108120167

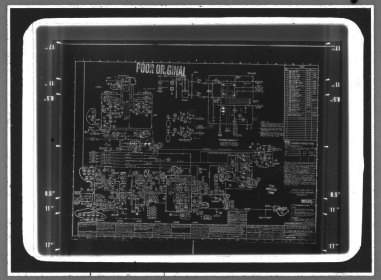

MMM 5824 — FILMSORT® Brand Aperture & Camera Cards and DUPLICARD® Brand Copy Cards — Product of 3M Company, St. Paul, Minn.