


17"
11"
8.5"
11"
17"

17"
11"
8.5"
11"
17"

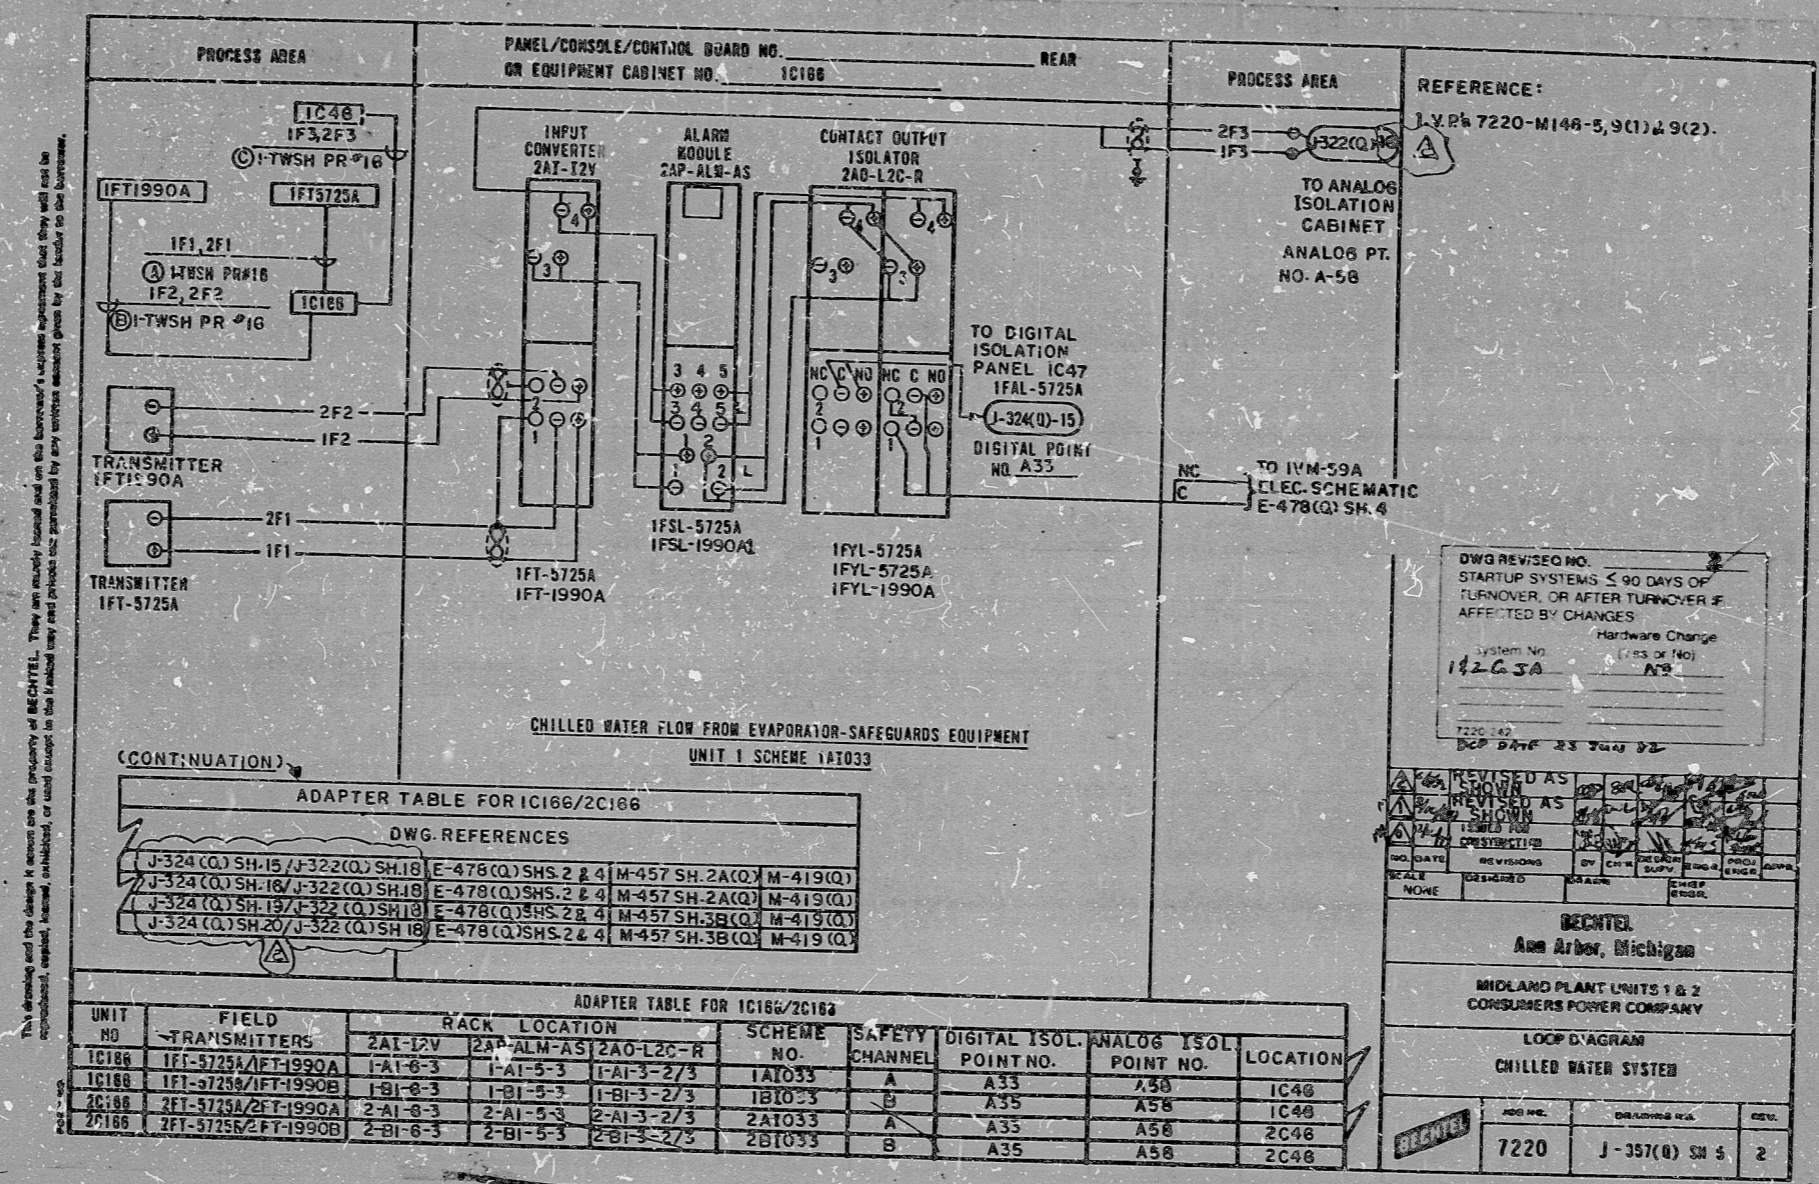

This drawing and the data it contains are the property of BECHTEL. They are made for use on the licensee's system equipment and they will not be reproduced, copied, loaned, exhibited, or used except in the manner and for the purposes intended by the licensee to the licensee.

DWG. REVISION NO. STARTUP SYSTEMS < 90 DAYS OF TURNOVER, OR AFTER TURNOVER IF AFFECTED BY CHANGES.

Hardware Change (Yes or No)
14205A
N/A

7220-142
REV. DATE 23 JUL 72

SCALE	DESIGNED	DRAWN	CHECKED	APPROVED
NONE				

BECHTEL
Ann Arbor, Michigan

MIDLAND PLANT UNITS 1 & 2
CONSUMERS POWER COMPANY

LOOP DIAGRAM
CHILLED WATER SYSTEM

NO.	DATE	BY	REASON
7220		J-357(B) SH. 5	2

"I certify that the image contained on this frame was made in the normal and regular course of business, on the date stated below and that it is an accurate reproduction of the document submitted to the contractor for filming, by Bechtel Power Corporation.

DATE 6/10/82
CAMERA OPERATOR M. Mason
CONTRACTOR'S SUPERVISOR OR MANAGER J. Williams

16X

PRC
APERTURE
CARD

RIDS

8302040267

