

17"

11"

8.5"

8.5"

11"

17"

17"



11"

8.5"

8.5"

11"

17"

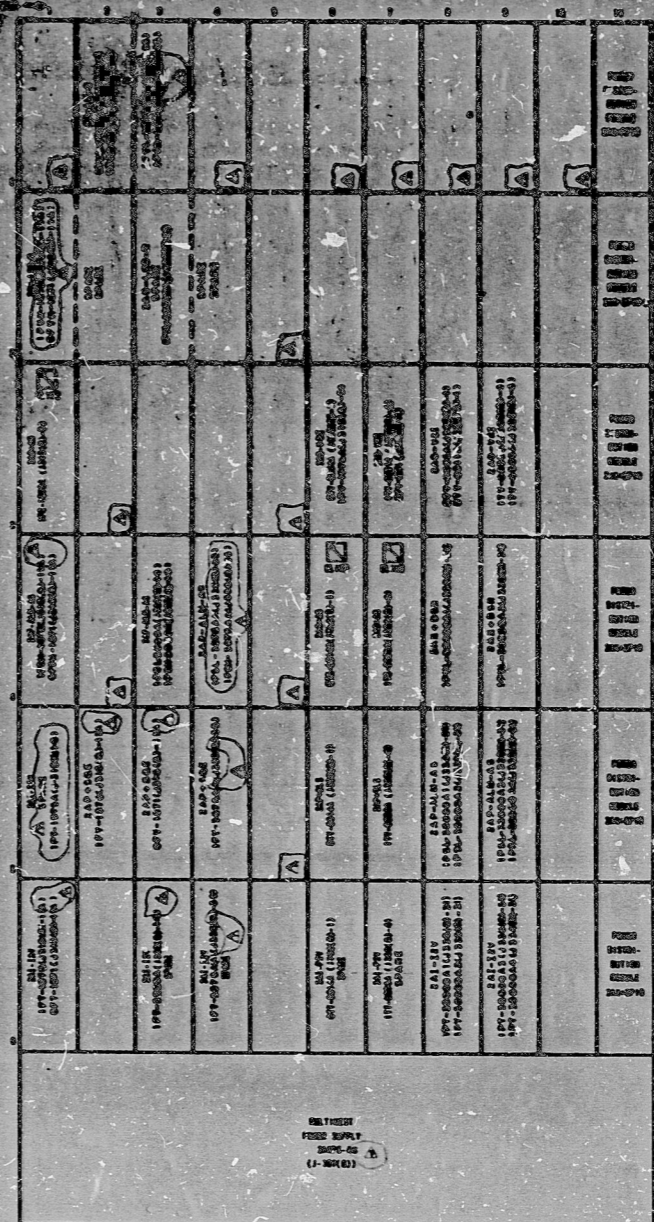 

01	03	05
02	04	06

LOCATION: FOR WIRING, INSTALLED IN EACH CAB (FLOOR ELEVATION 100'-00")



GENERAL NOTES:
1. THIS DRAWING IS TO BE USED FOR MODULE LOCATION AND AS A REFERENCE TO THE LOOP DIAGRAMS ONLY. FOR EXAMINATION OF MODULES WITH MULTIPLE INPUTS/OUTPUTS, REFER TO THE SPECIFIC LOOP DIAGRAMS.

PRO APERTURE CARD

NOTES:
REVISION 1 WAS FORBIDDEN RACK AS SHIPPED

NO.	DATE	REVISION AS INDICATED	BY	CHKD.

BECHTEL

CONSUMERS POWER COMPANY

PERMITS RACK - UNIT 1C100
PAGE OF PLAN - (1)

NO. 7220	DATE	REV.
	J-392(G) 5/61	7



30X

changes to Unit 1

RIDS

- enter only 50-329

in Docket field

&

file level

8302040293

