

17"

11"

8.5"

8.5"

11"

17"

17"



11"

8.5"

8.5"


11"

17"

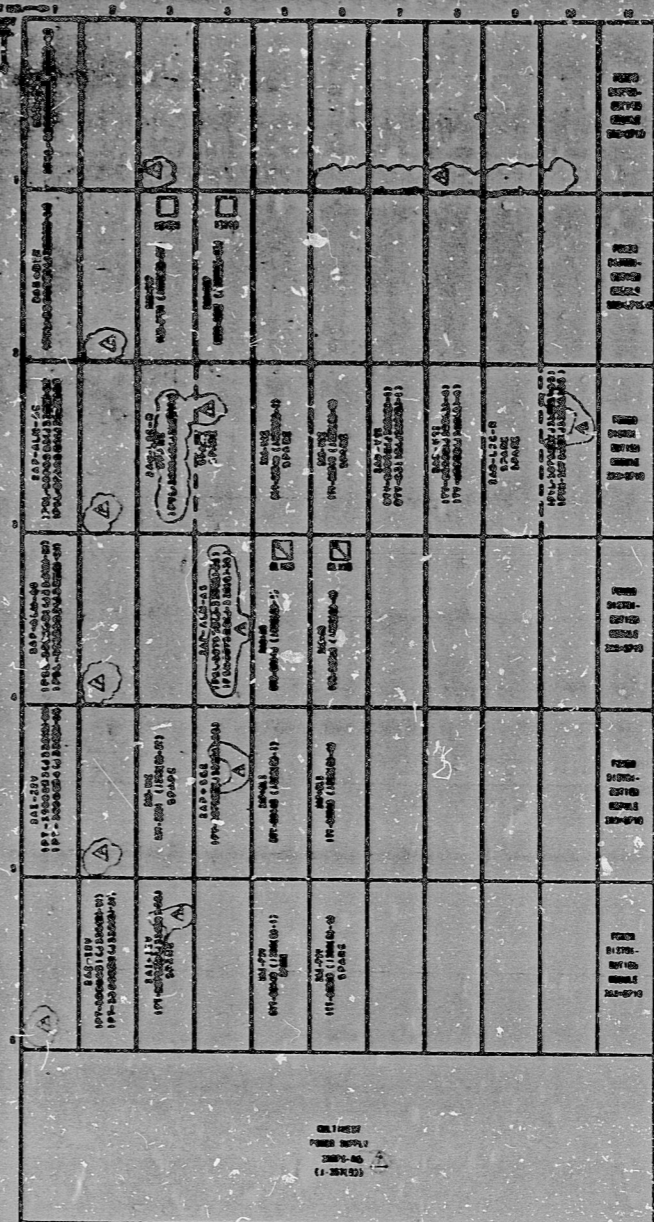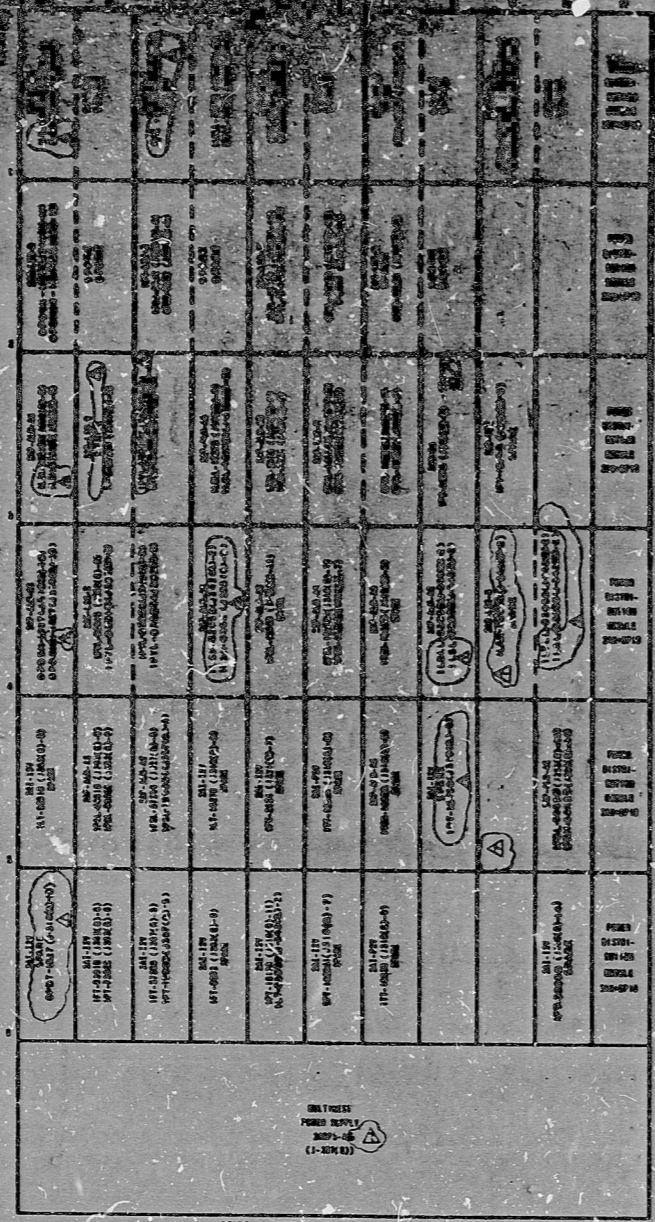



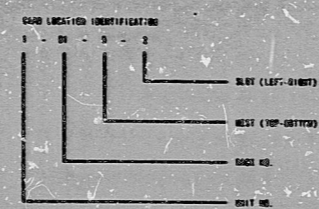

GENERAL NOTES:
THIS DRAWING IS TO BE USED FOR WIRE LOCATION AND AS A REFERENCE TO THE LOOP DIAGRAMS ONLY FOR EXACT USAGE ON MODULES WITH MULTIPLE INPUTS/OUTPUTS REFER TO THE SPECIFIC LOOP DIAGRAM

PRC APERTURE CARD

NOTE:
RAVISON BURS FORGONO RACK AS SHIPPED

REVISIONS	DATE	BY	REASON
1			
2			
3			
4			
5			
6			
7			
8			
9			
10			






REV. NO.	DATE	BY	REASON
7220	J-752101 SH 2		

30X

RIDS

8302040296

