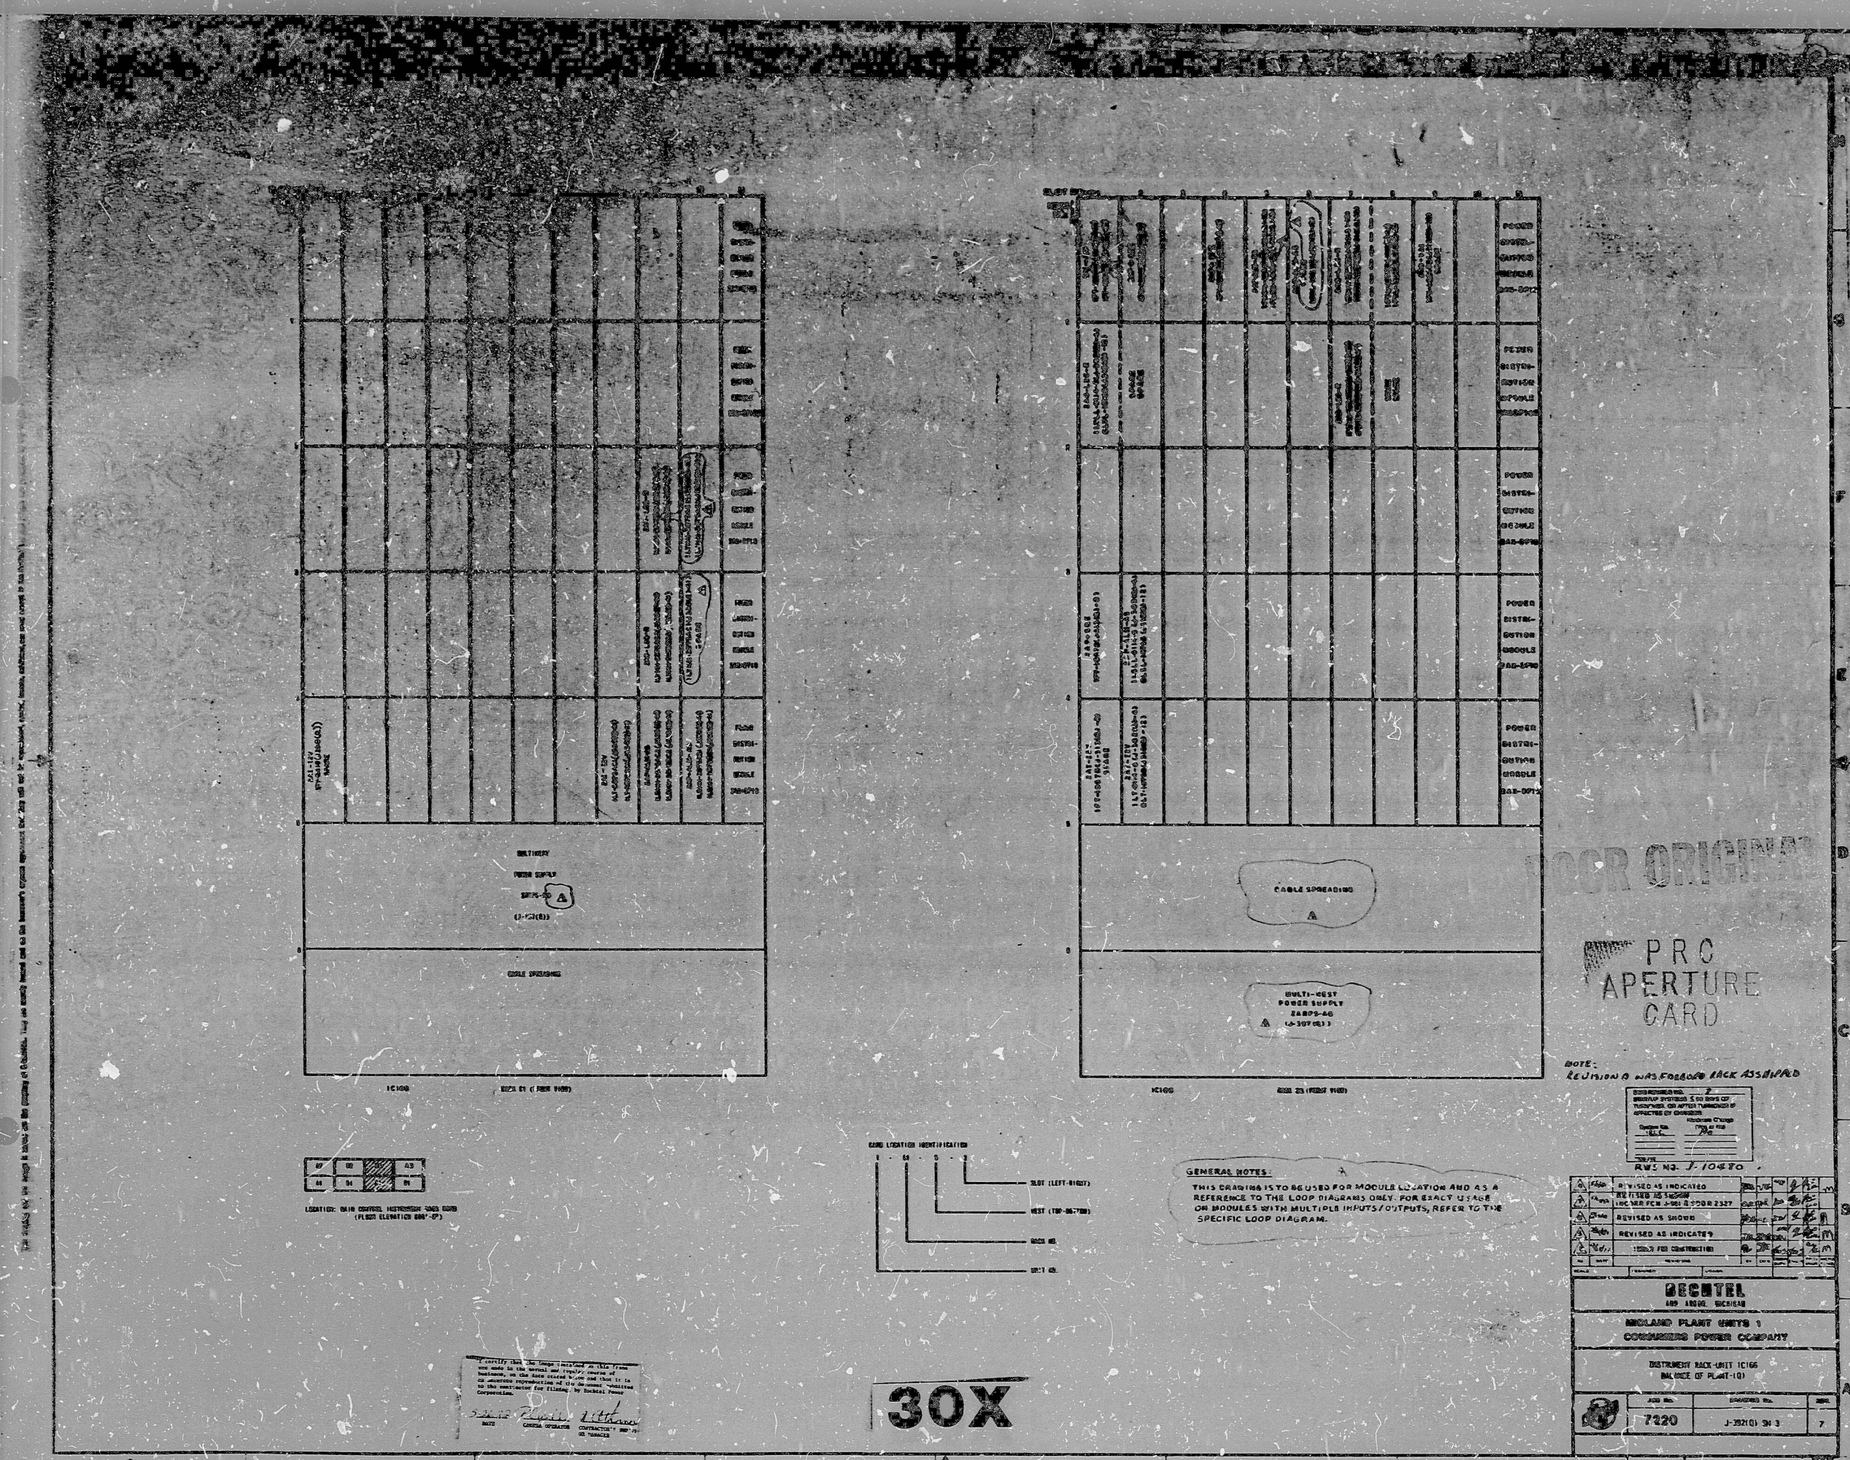
BATTERY
POWER SUPPLY
(J-352(B))
CABLE SPREADING
IC100
CABLE SPREADING
MULTI-MEST
POWER SUPPLY
ZA805-A6
(J-307(B))
IC106
LOCATION: MAIN CONTROL INSTRUMENT CASES BOARD
(FLOOR ELEVATION 606'-0")
LOOP LOCATION IDENTIFICATION
SLOT (LEFT-RIGHT)
MEST (TOP-BOTTOM)
GROUP NO.
UNIT NO.
GENERAL NOTES:
THIS DRAWING IS TO BE USED FOR MODULE LOCATION AND AS A REFERENCE TO THE LOOP DIAGRAMS ONLY. FOR EXACT USAGE OF MODULES WITH MULTIPLE INPUTS/OUTPUTS, REFER TO THE SPECIFIC LOOP DIAGRAM.
NOTE:
REVISION B WAS FOR BACK ASSEMBLY
RWS NO. J-10670.
REVISED AS INDICATED
REVISED AS SHOWN
REVISED AS INDICATED
ISSUED FOR CONSTRUCTION
BECHTEL
MIDLAND PLANT UNITS 1
CONSUMERS POWER COMPANY
INSTRUMENT RACK-UNIT IC166
BALANCE OF PLANT-(0)
7220
J-352(0) SH 3
7
I certify that the image contained on this frame was made in the normal and regular course of business, on the date stated below and that it is an accurate reproduction of the original, supplied to the contractor for filming by Bechtel Power Corporation.
DATE
GENERAL OPERATOR
CONTRACTOR'S REP. OR ENGINEER
30X
PRC APERTURE CARD
17"
11"
8.5"

RIDS

8302040297

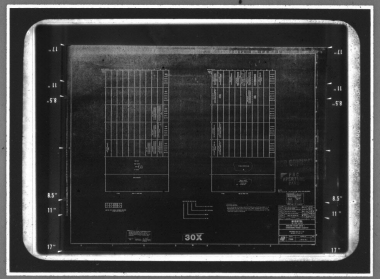

MMM 5824 — FILMSORT® Brand Aperture & Camera Cards and DUPLICARD® Brand Copy Cards — Product of 3M Company, St. Paul, Minn.