

17"

11"

8.5"

8.5"

11"

17"

17"



11"

8.5"

8.5"

11"


17"

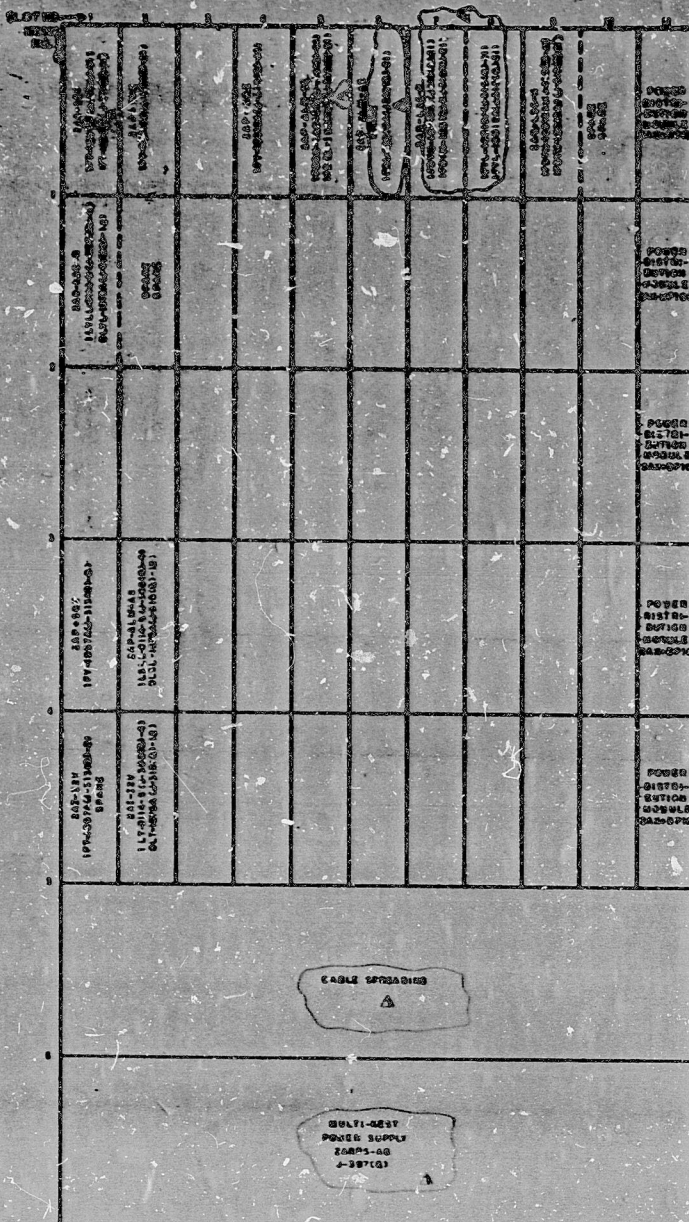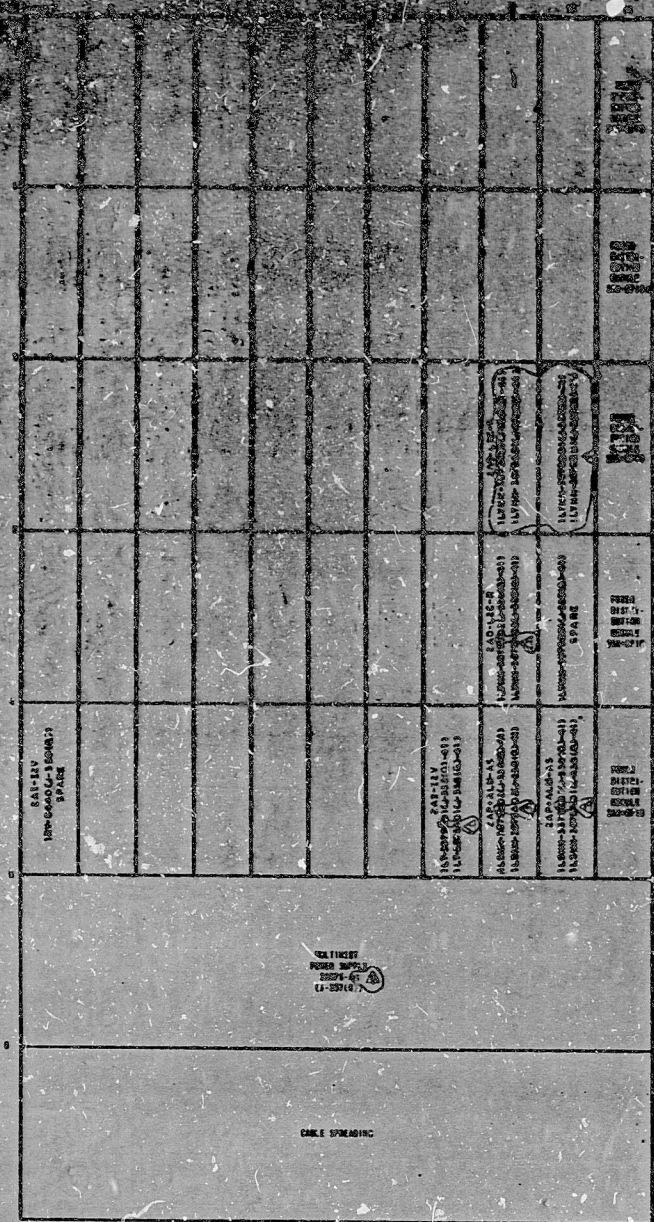

02	03	05
01	04	01

LOCATED: MAIN CONTROL INSTRUMENT RACK ROOM (FLOOR ELEVATION 840'-0")


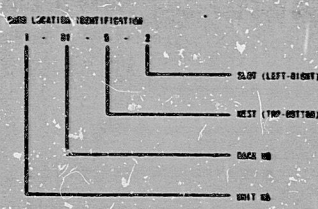

GENERAL NOTES  
1. THIS DRAWING IS TO BE USED FOR LOCATION AND AS A REFERENCE TO THE LOOP DIAGRAM ONLY. FOR EXACT CONNECTIONS WITH MULTIPLE INPUTS/OUTPUTS, REFER TO THE SPECIFIC LOOP DIAGRAM.

PRO APERTURE CARD  
POOR ORIGINAL

30X

REVISION NO. J-104-00

NOTE: REVISION 0 WAS FOR NO LOCK AS SHOWN

REV	DESCRIPTION	DATE	BY

BECHTEL  
AND ASSOCIATES  
INSTRUMENT RACK - UNIT 1016  
RACK SIZE OF PLANT - (01)

DATE	DESCRIPTION	NO.
7/23/68	J-101(1) 514.4	7



RIL

8302049300

