

17"

11"

8.5"

8.5"

11"

17"

17"


11"

8.5"

8.5"

11"

17"

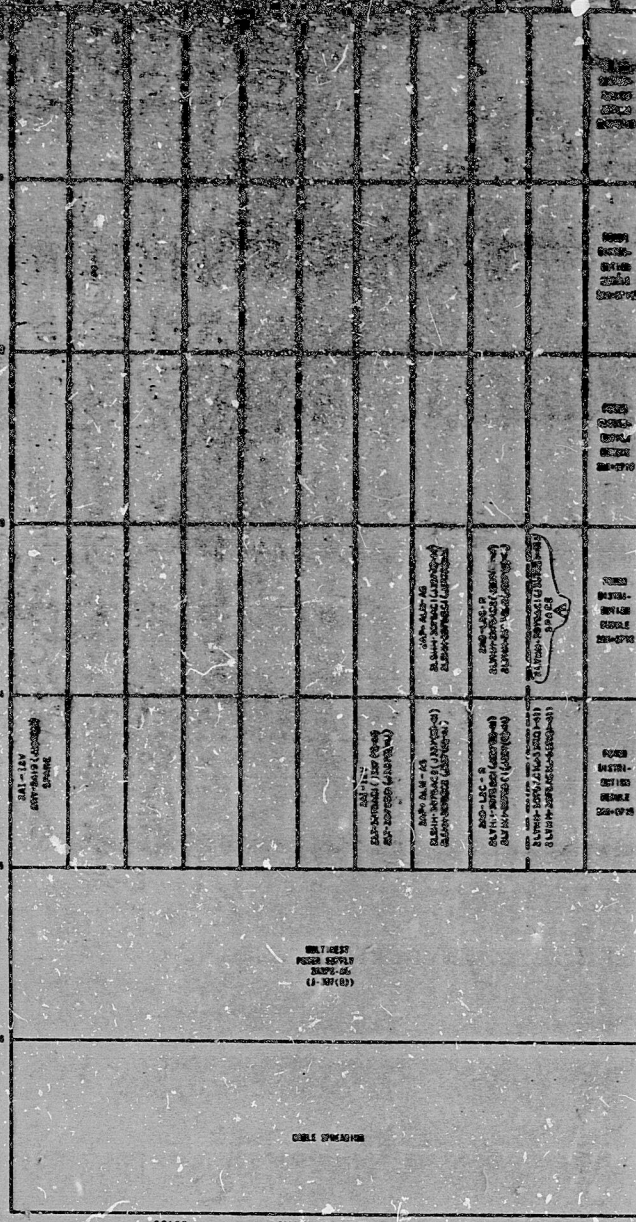


ZC190 REAR VIEW (PAGE VIEW)


AS	BS	CS
AS	BS	CS

LEGEND: 6818 CONTROL INSTRUMENT LOOP PWR (FIELD OPERATION 800-87)


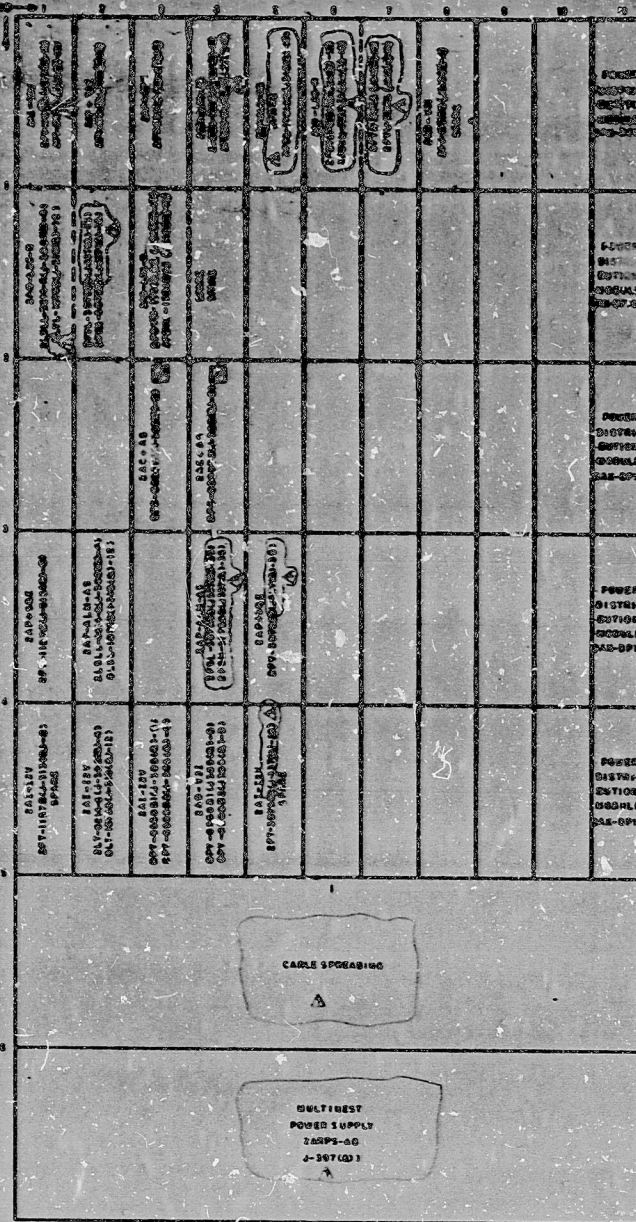

ZC190 FRONT VIEW (PAGE VIEW)

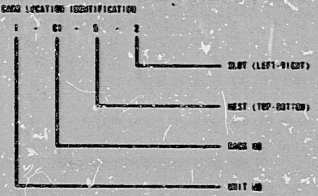

**GENERAL NOTES**

1. THIS DRAWING IS TO BE USED FOR MODULE LOCATION AND AS A REFERENCE TO THE LOOP DIAGRAMS ONLY. FOR EXACT USAGE ON MODULES WITH MULTIPLE INPUTS/OUTPUTS, REFER TO THE SPECIFIC LOOP DIAGRAM.

**POOR ORIGINAL**  
 PRC  
 APERTURE  
 CARD

30X


REVISIONS:


AS	BS	CS
AS	BS	CS




 DRAWING NO.: J-355(1) 24.3  
 SHEET: 7



RIDS

8302040308

