
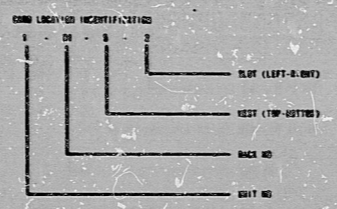
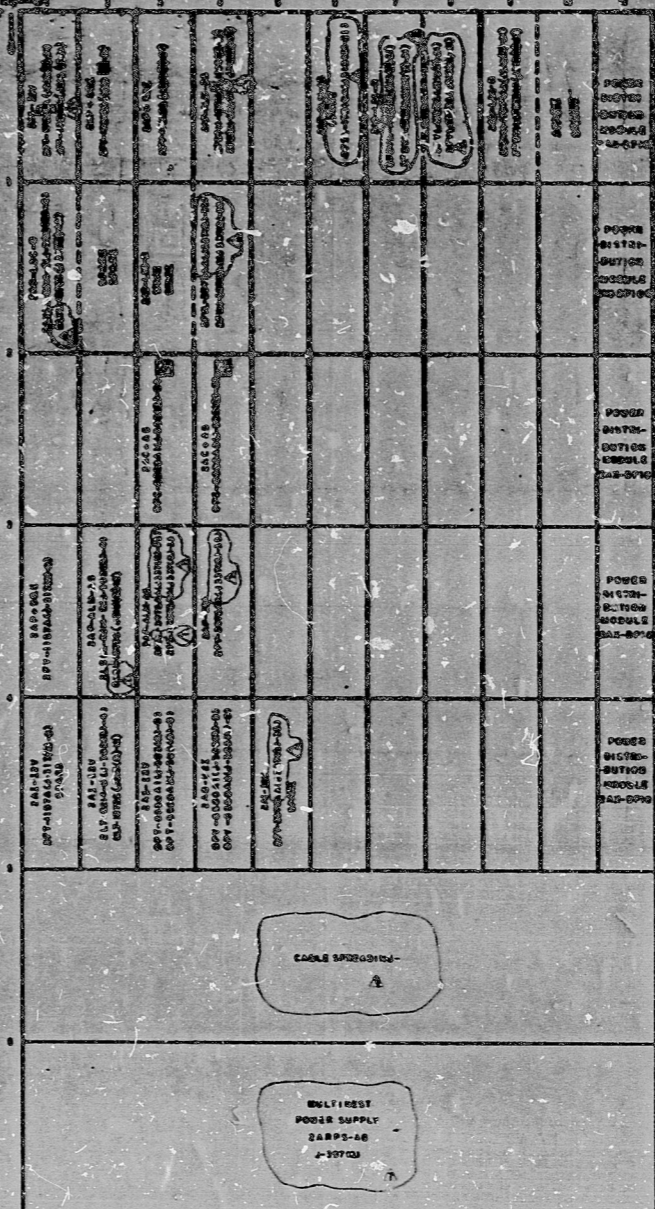


17"
11"
8.5"
8.5"
11"
17"

17"
11"
8.5"
8.5"
11"
17"

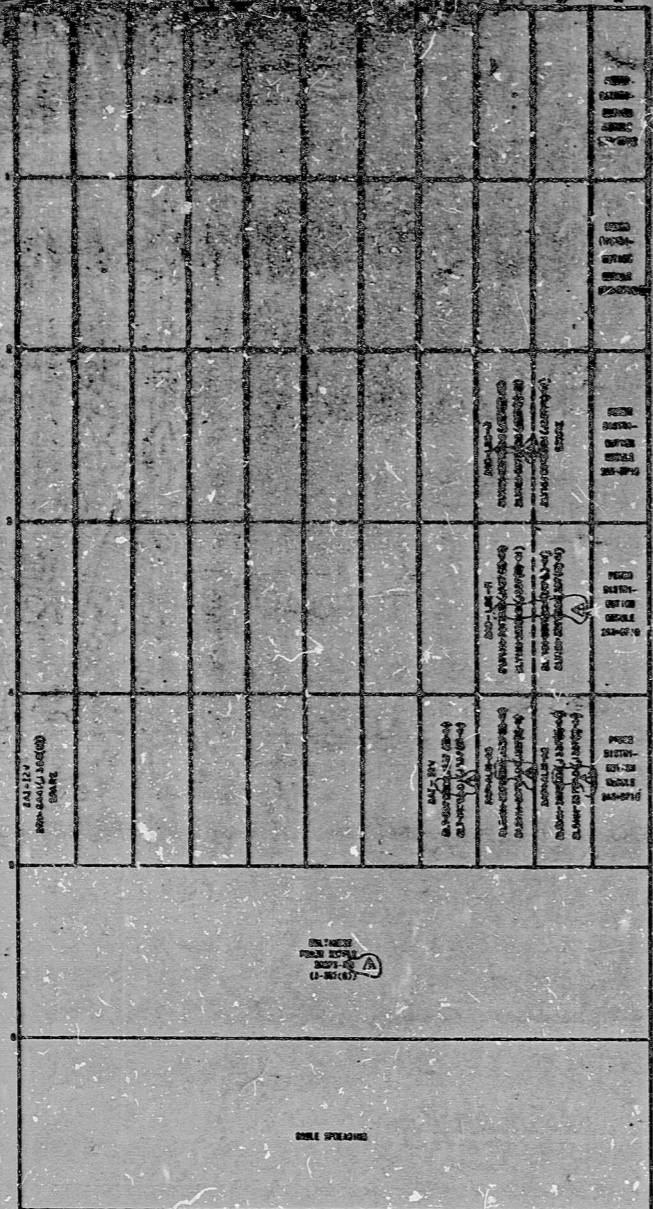

GENERAL NOTES:
 1. THIS DRAWING IS TO BE USED FOR MODULE LOCATION AND AS A REFERENCE TO THE LOOP DIAGRAMS ONLY. FOR EXACT USAGE IN MODULES WITH MULTIPLE INPUTS/OUTPUTS, REFER TO THE SPECIFIC LOOP DIAGRAM.

PRC
 APERTURE
 CARD

NOTES:

REVISIONS

NO.	DATE	BY	DESCRIPTION
0			


30X

SECURITY



DATE	APPROVED BY	DATE
7/22/60	J. BOSSIGI SM. 4	7

RIDS

8302040309

