
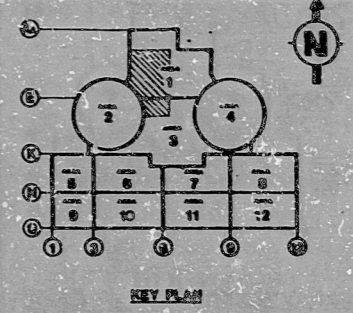


310-10

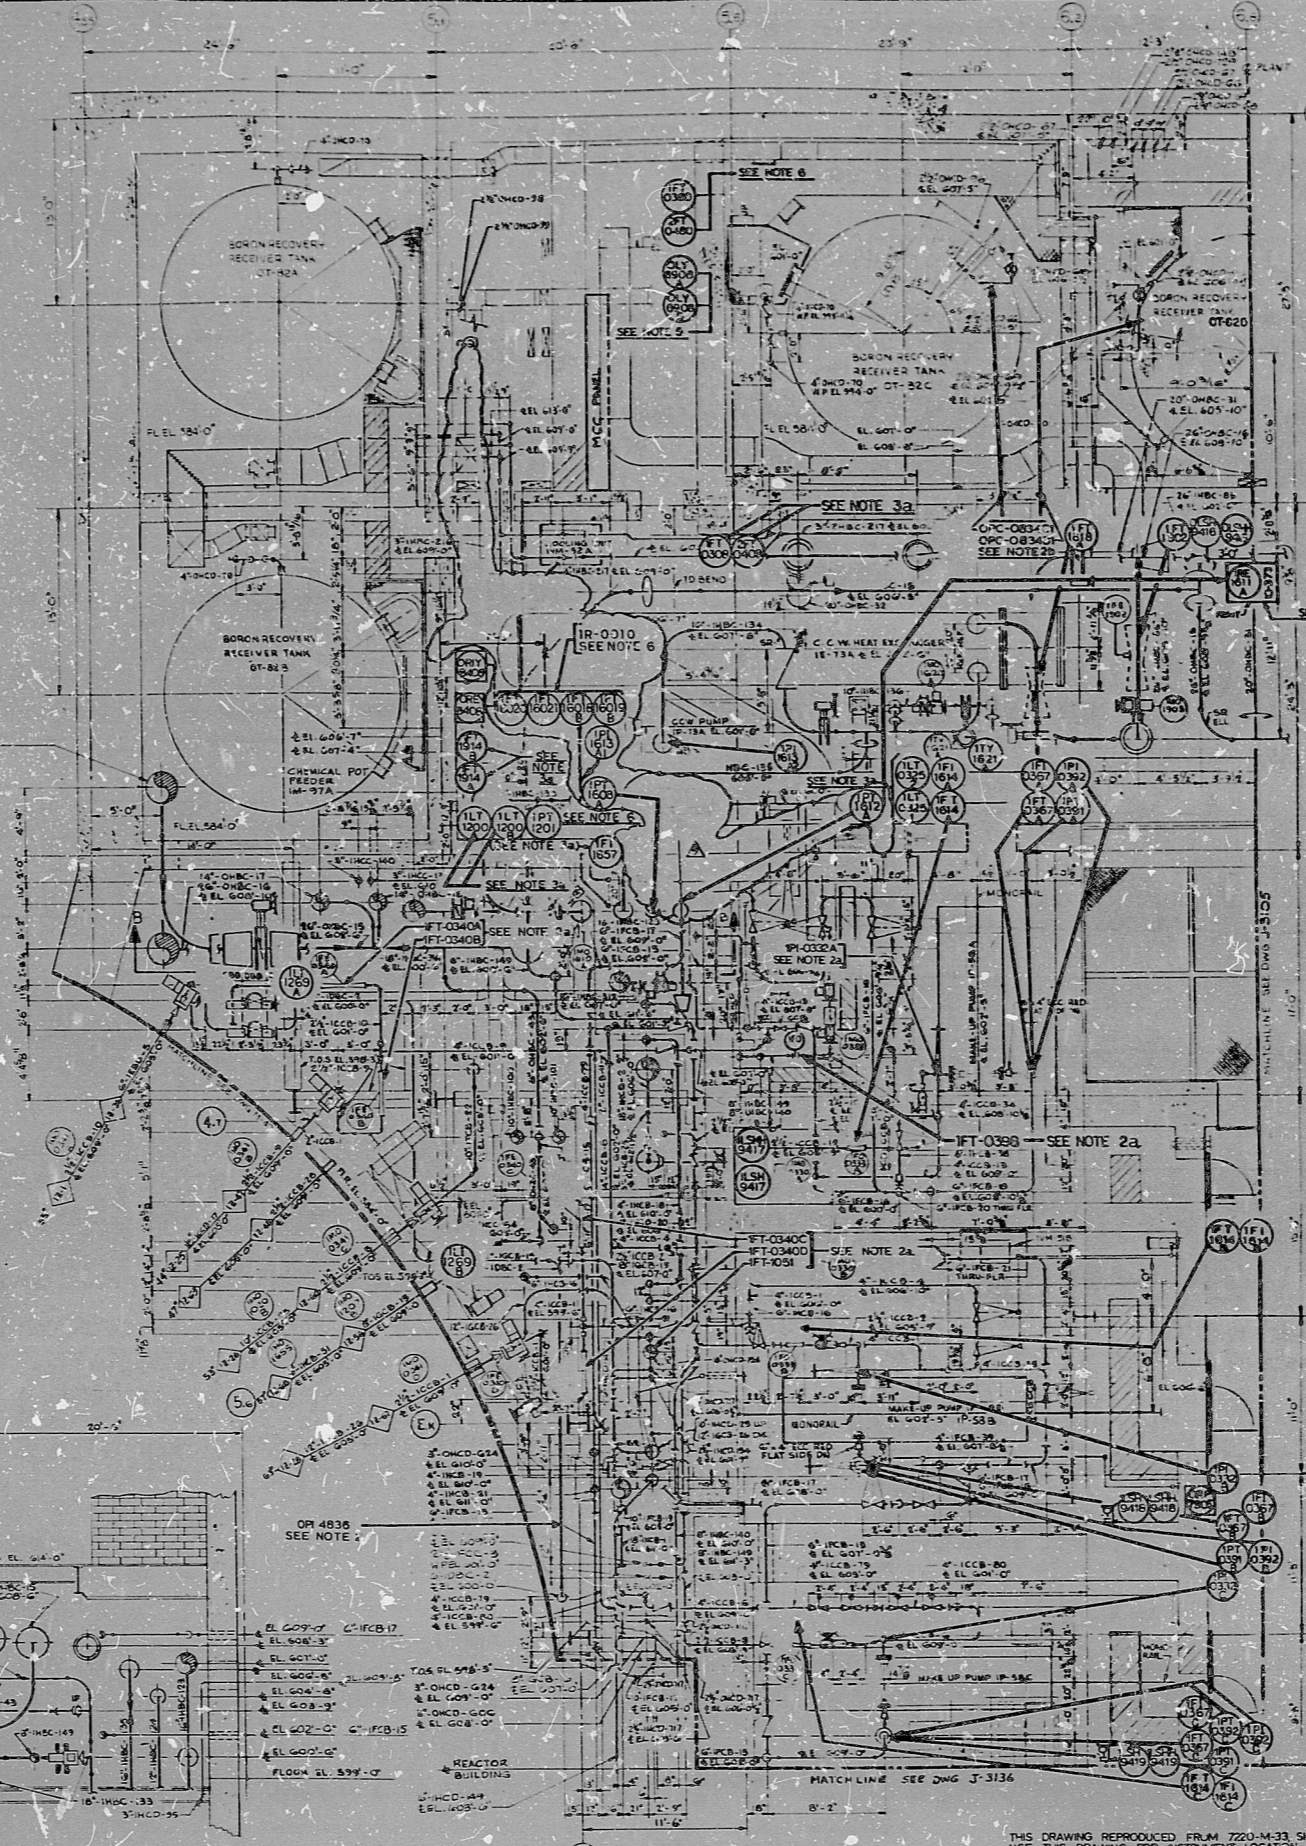

SYSTEMS SHOWN

SYSTEM	NO.	DATE	BY

- INSTRUMENT LOCATION DRAWING NOTES:**
- SEE DWG. 7220-J-3104 FOR ALL GENERAL NOTES.
 - THESE ARE TAP LOCATIONS ONLY REFER TO DWG. J-3104 FOR INSTRUMENT LOCATION.
 - TAP LOCATIONS FOR THESE INSTRUMENT ARE SHOWN (J-3104).
 - FOR RETURN TAP LOCATION OF THE-N11A SEE DWG. J-3102.
 - INSTRUMENT LOCATION ONLY, RUN AIR SUPPLY TO WALKS (J-3104) AND B LOCATED ON DWG. J-3104.
 - INSTRUMENT LOCATION ONLY, REFER TO DWG. J-3104 FOR TAP LOCATION.
 - DELETED.

REVISIONS OF INSTRUMENT LOCATION
 I certify that the design contained in this drawing was made in the normal and regular course of business, on the date stated below and that it is an accurate reproduction of the design submitted to the contractor for construction by Bechtel Power Corporation.
 2-3-79 Rev. Spices See Checklist
 J-3104 INSTRUMENT LOCATION DRAWING

NO.	DESCRIPTION	DATE	BY	CHKD.

BECHTEL
 INSTRUMENT LOCATION DRAWING
 AREA 1
 PLAN OF EL 599'-0"
 7220 J-3104 (Q) 9

THIS DRAWING REPRODUCED FROM 7220-M-33 SH 1102, REV. 1
 USE THIS DRAWING FOR INSTRUMENT LOCATION ONLY
 FOR ALL OTHER DATA REFER TO APPLICABLE DRAWINGS.

PROC 2
 APERTURE
 CARD

17"
 11"
 8.5"
 8.5"
 11"
 17"

17"
 11"
 8.5"
 8.5"
 11"
 17"

RIDS

8302040407

