
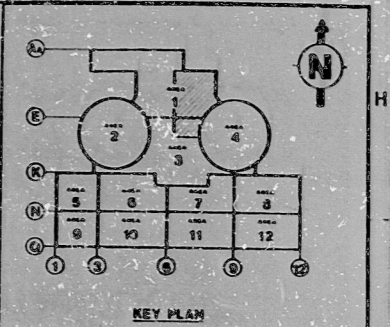


J-3116 (Q)

SIZE E

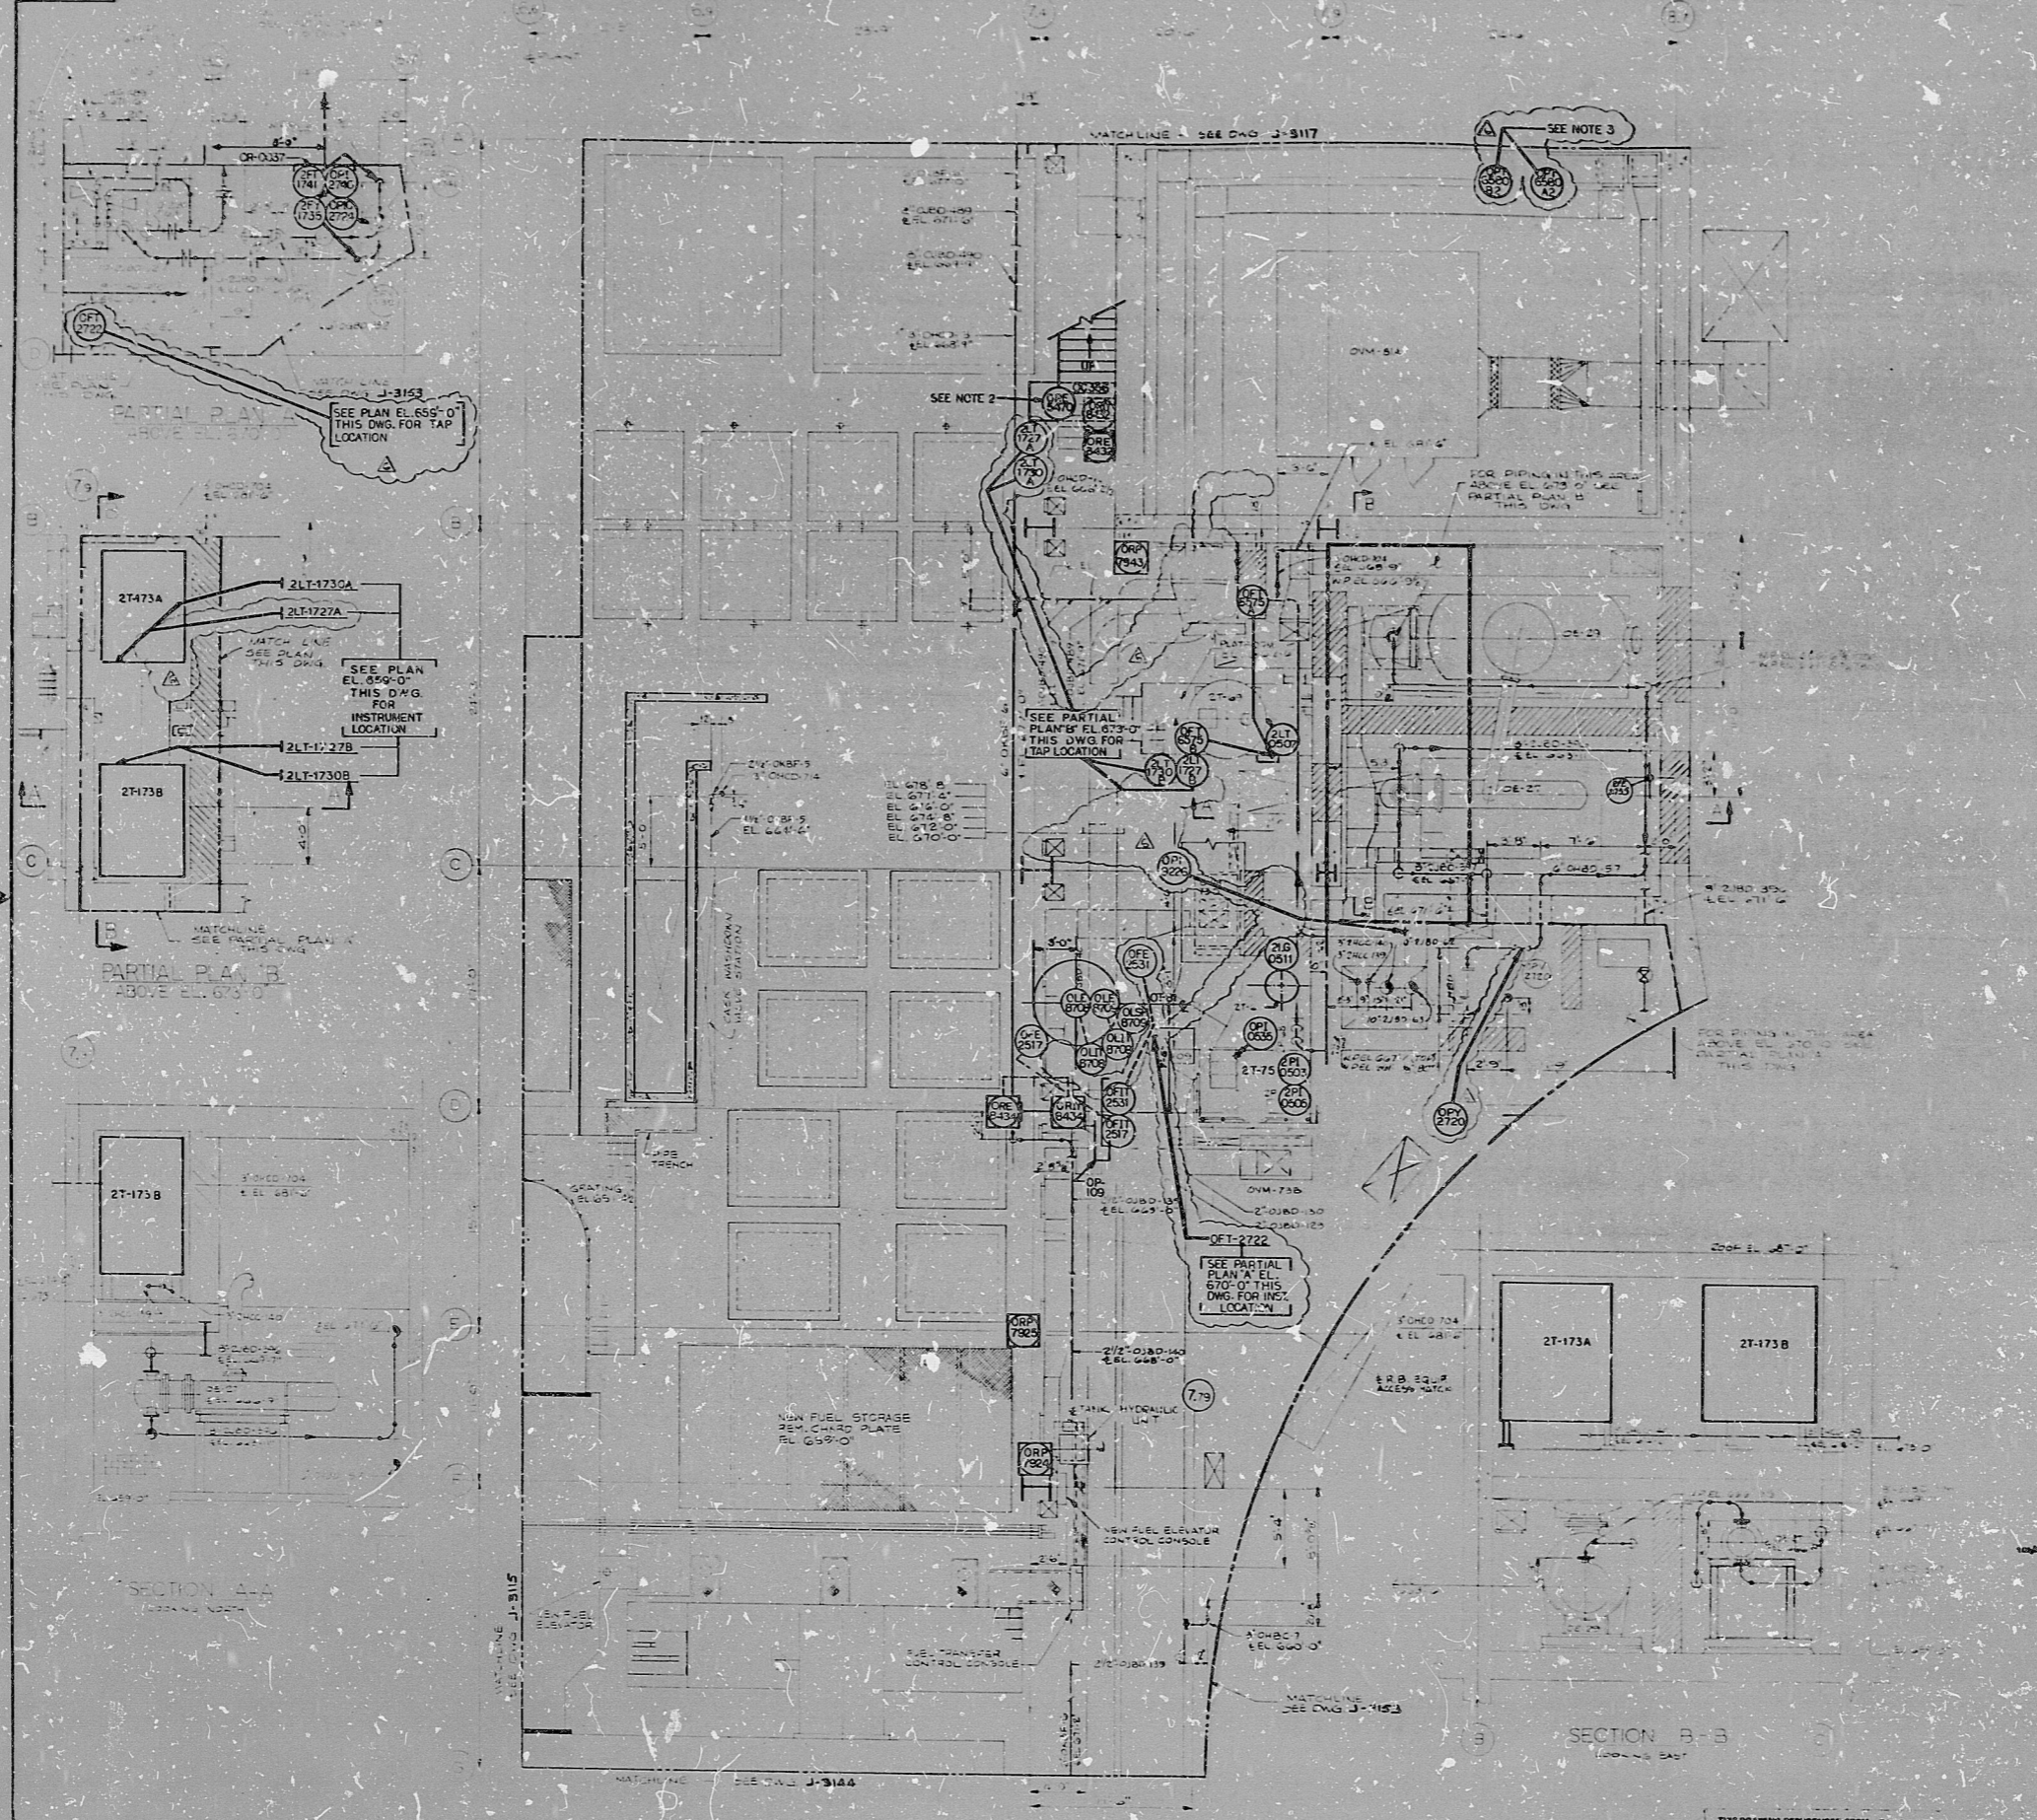







- INSTRUMENT LOCATION DRAWING NOTES**
- SEE DWG 7220-J-3101(Q) FOR ALL GENERAL NOTES.
  - INSTRUMENT LOCATION ONLY. REFER TO DWG 7220-J-3140 FOR SAMPLE TAP LOCATION WHICH WILL BE APPROXIMATELY 5'-0" ABOVE PLATFORM ELEVATION 155'.
  - INSTRUMENT LOCATIONS ONLY. SEE DWG 7220-J-3102(Q) FOR TAP LOCATIONS.



**RECNTEL**  
 MIDLAND PLANT UNITS 1 & 2  
 CONSUMERS POWER COMPANY

**INSTRUMENT LOCATION DRAWING**  
 AREA 1  
 PLAN OF EL. 659'-0"

JOB NO.	DRAWING NO.	REV.
7220	J-3116 (Q)	6

PRO3  
 APERTURE  
 CARD

8.5"  
 11"  
 17"

8.5"  
 11"  
 17"



RIDS

8302040427

